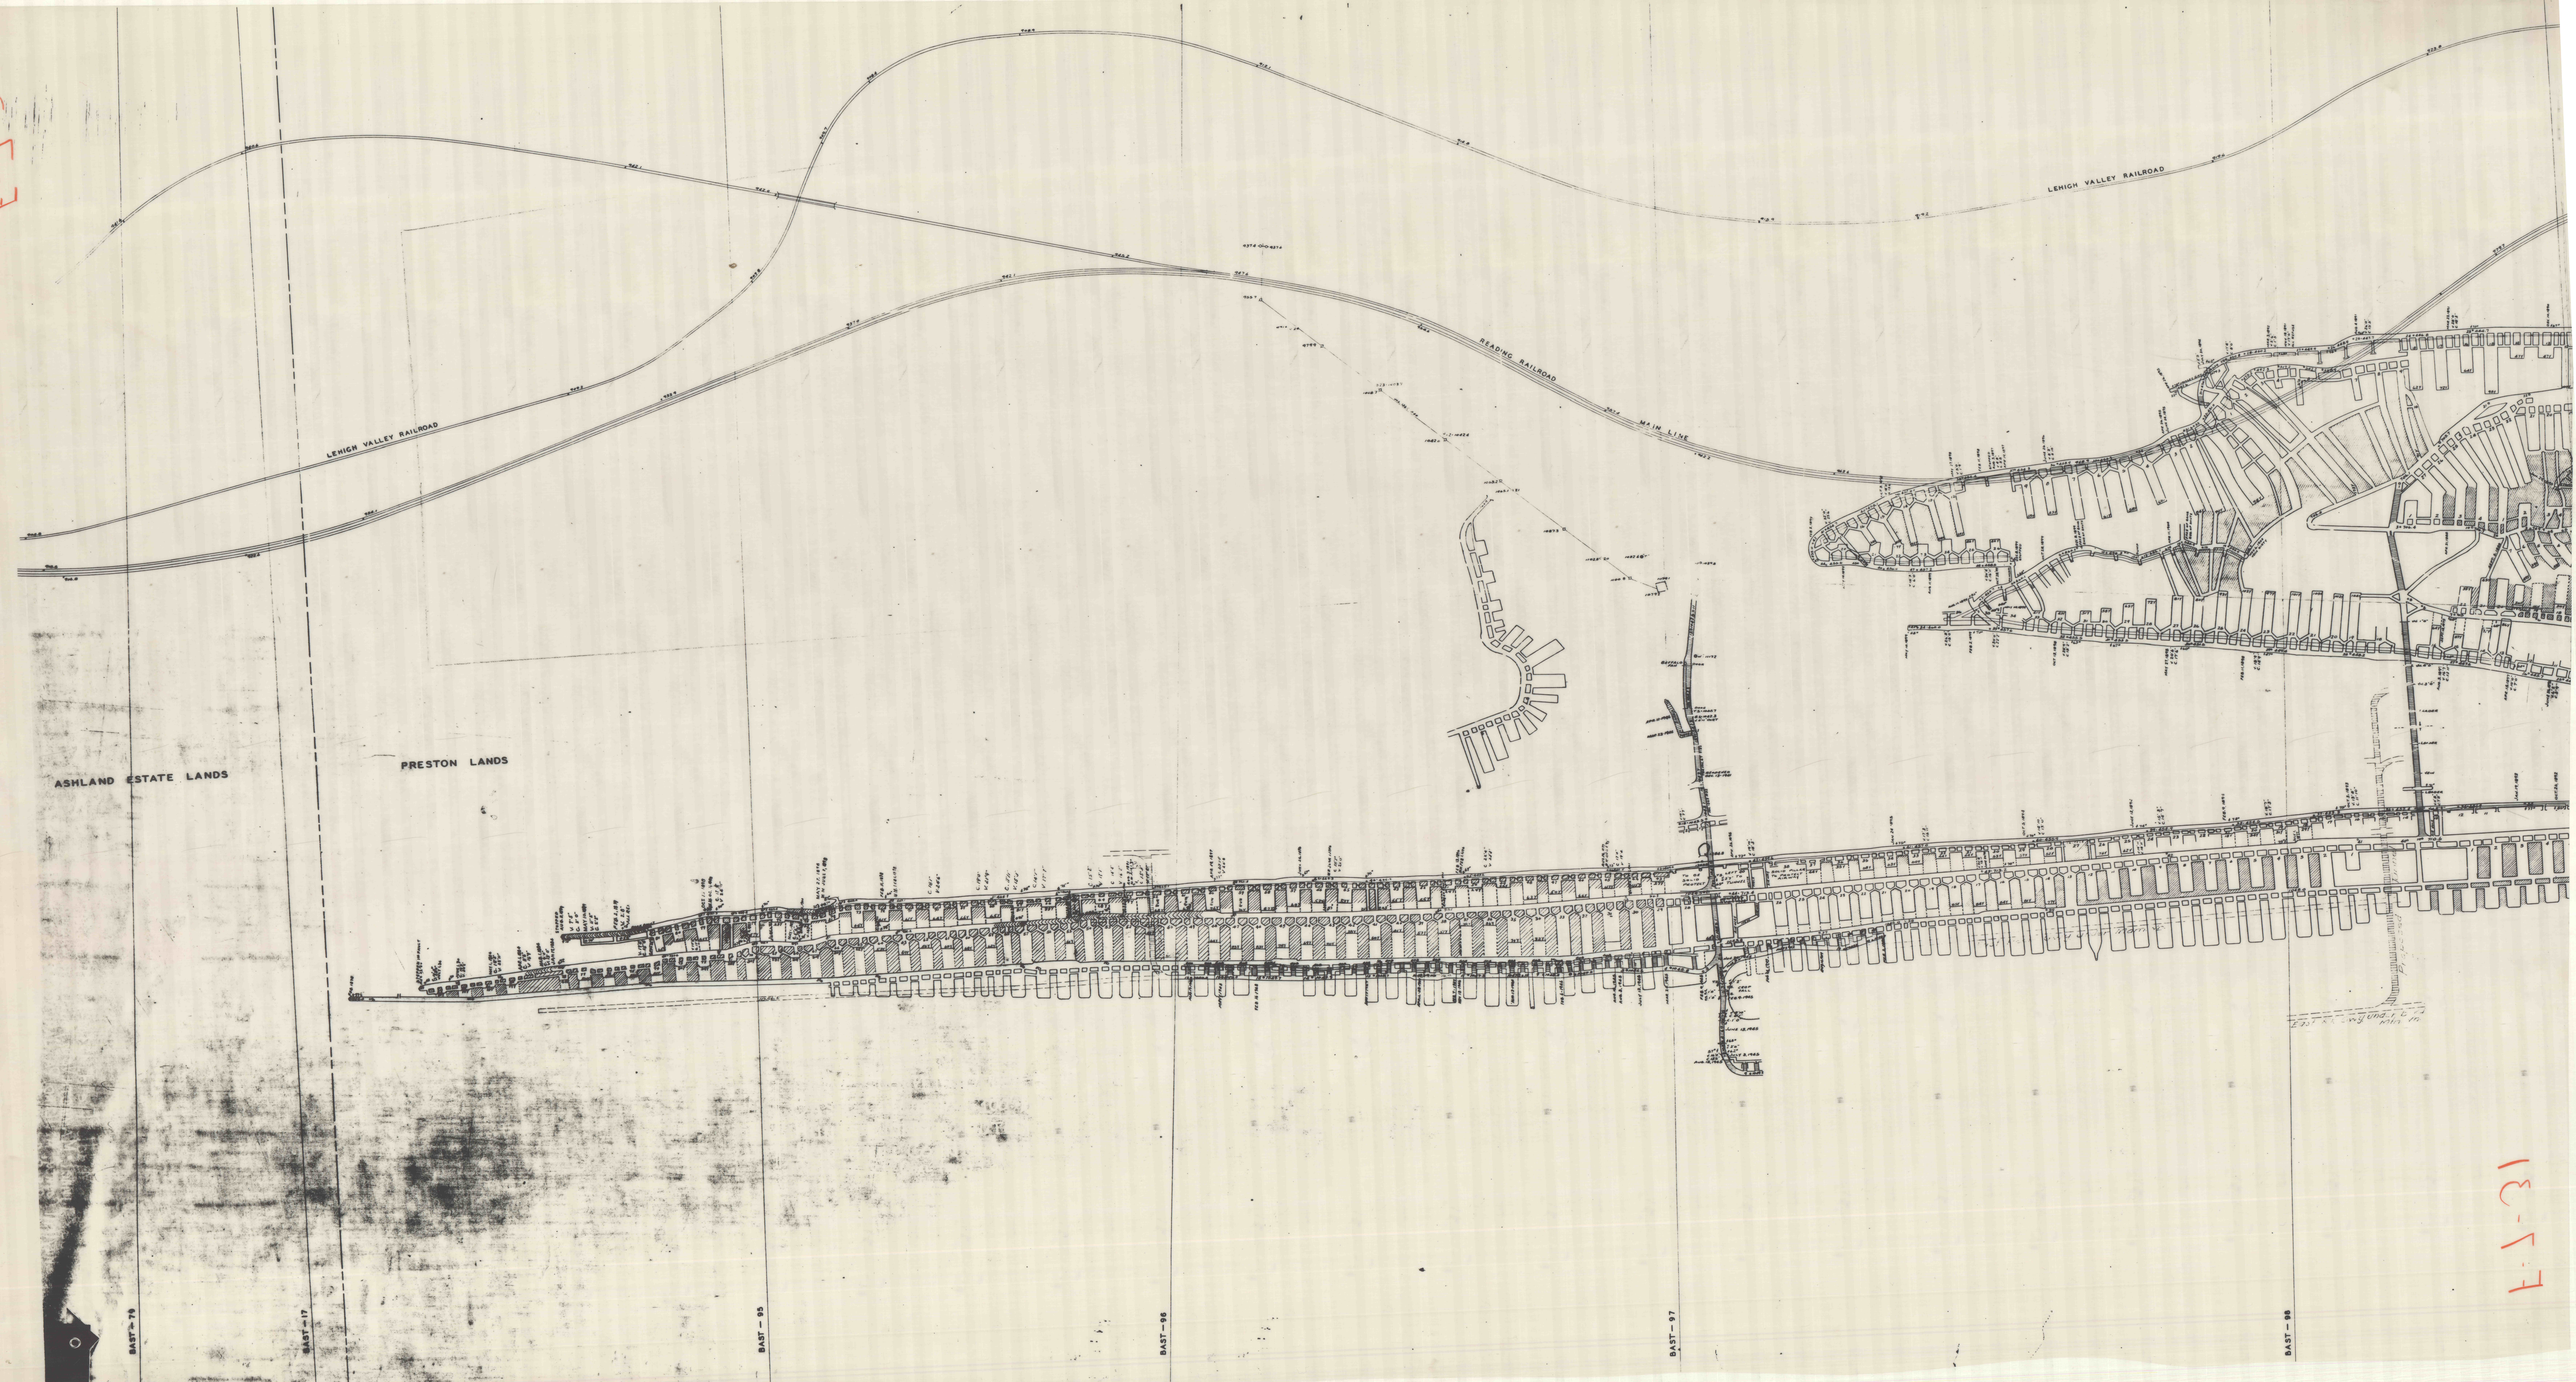
LEHIGH VALLEY RAILROAD
READING RAILROAD
MAIN LINE
LEHIGH VALLEY RAILROAD
ASHLAND ESTATE LANDS
PRESTON LANDS
BAST-76
BAST-17
BAST-95
BAST-96
BAST-97
BAST-98

F-1-31