BANCROFT COLLIERY

MAP OF

BUCK MOUNTAIN VEIN WORKINGS

SCALE 100 = 1' Ashland, Pa. Mar. 7, 1923
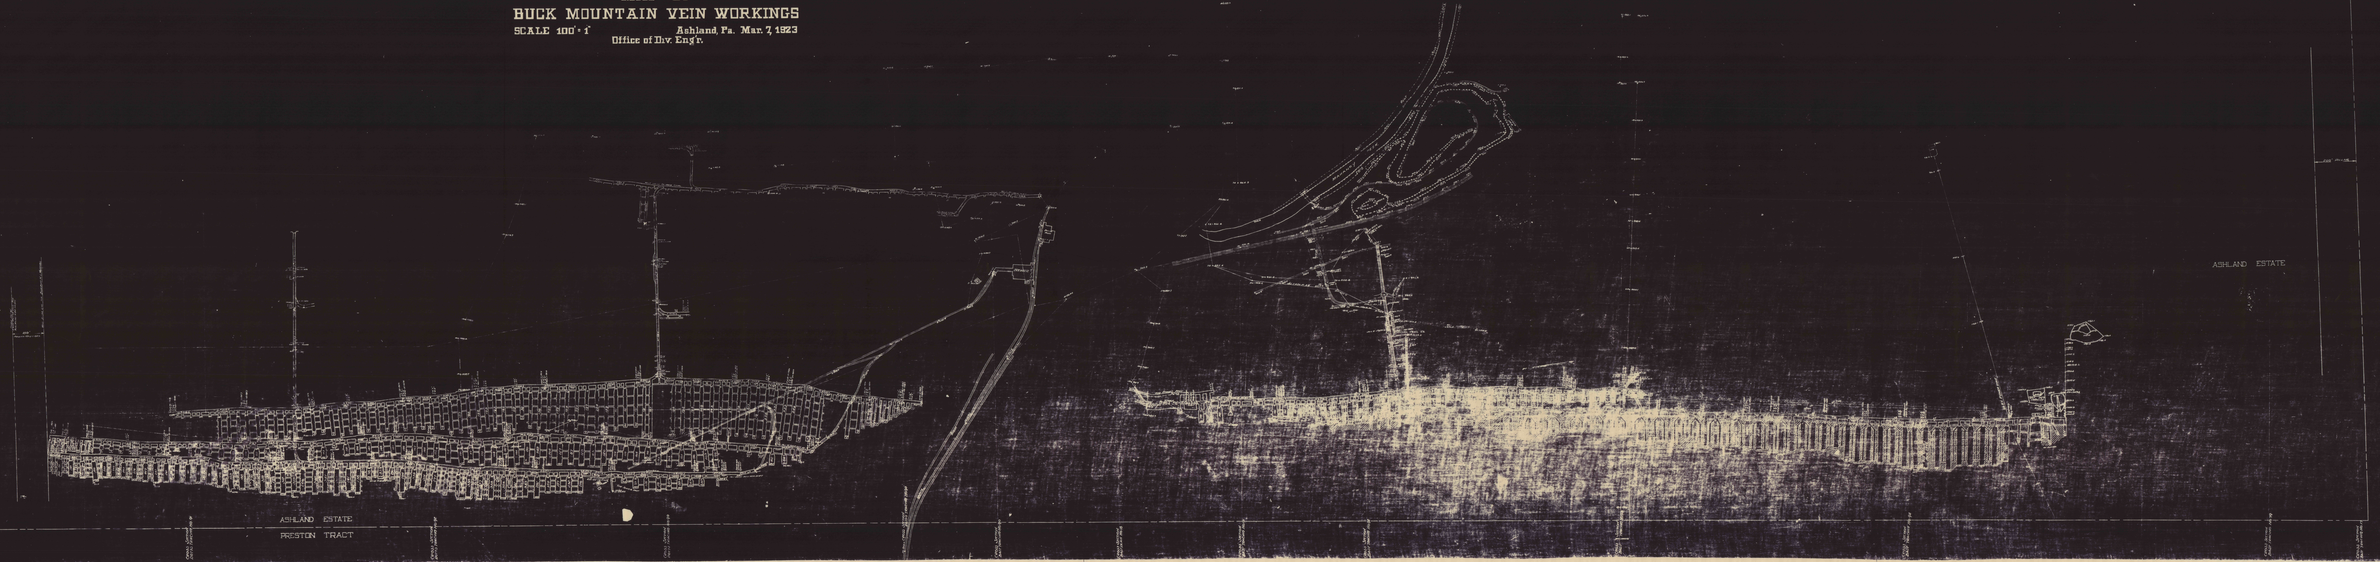
Office of Div. Eng'r.