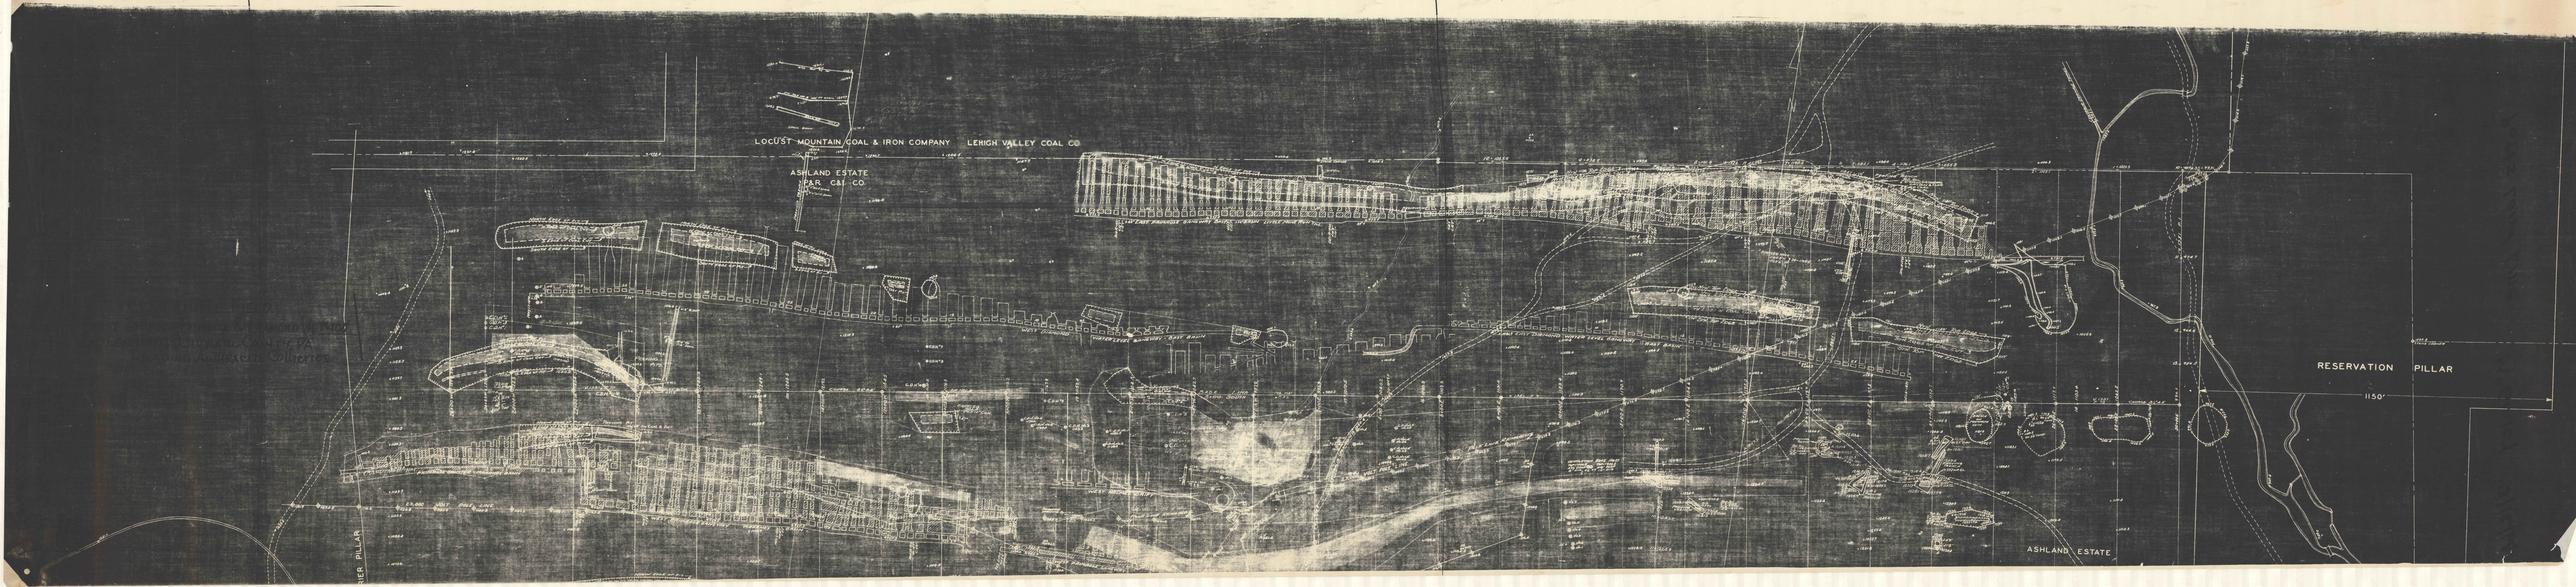
LOCUST MOUNTAIN COAL & IRON COMPANY
LEHIGH VALLEY COAL CO
ASHLAND ESTATE
P&R C&I CO
RESERVATION PILLAR
1150'
ASHLAND ESTATE