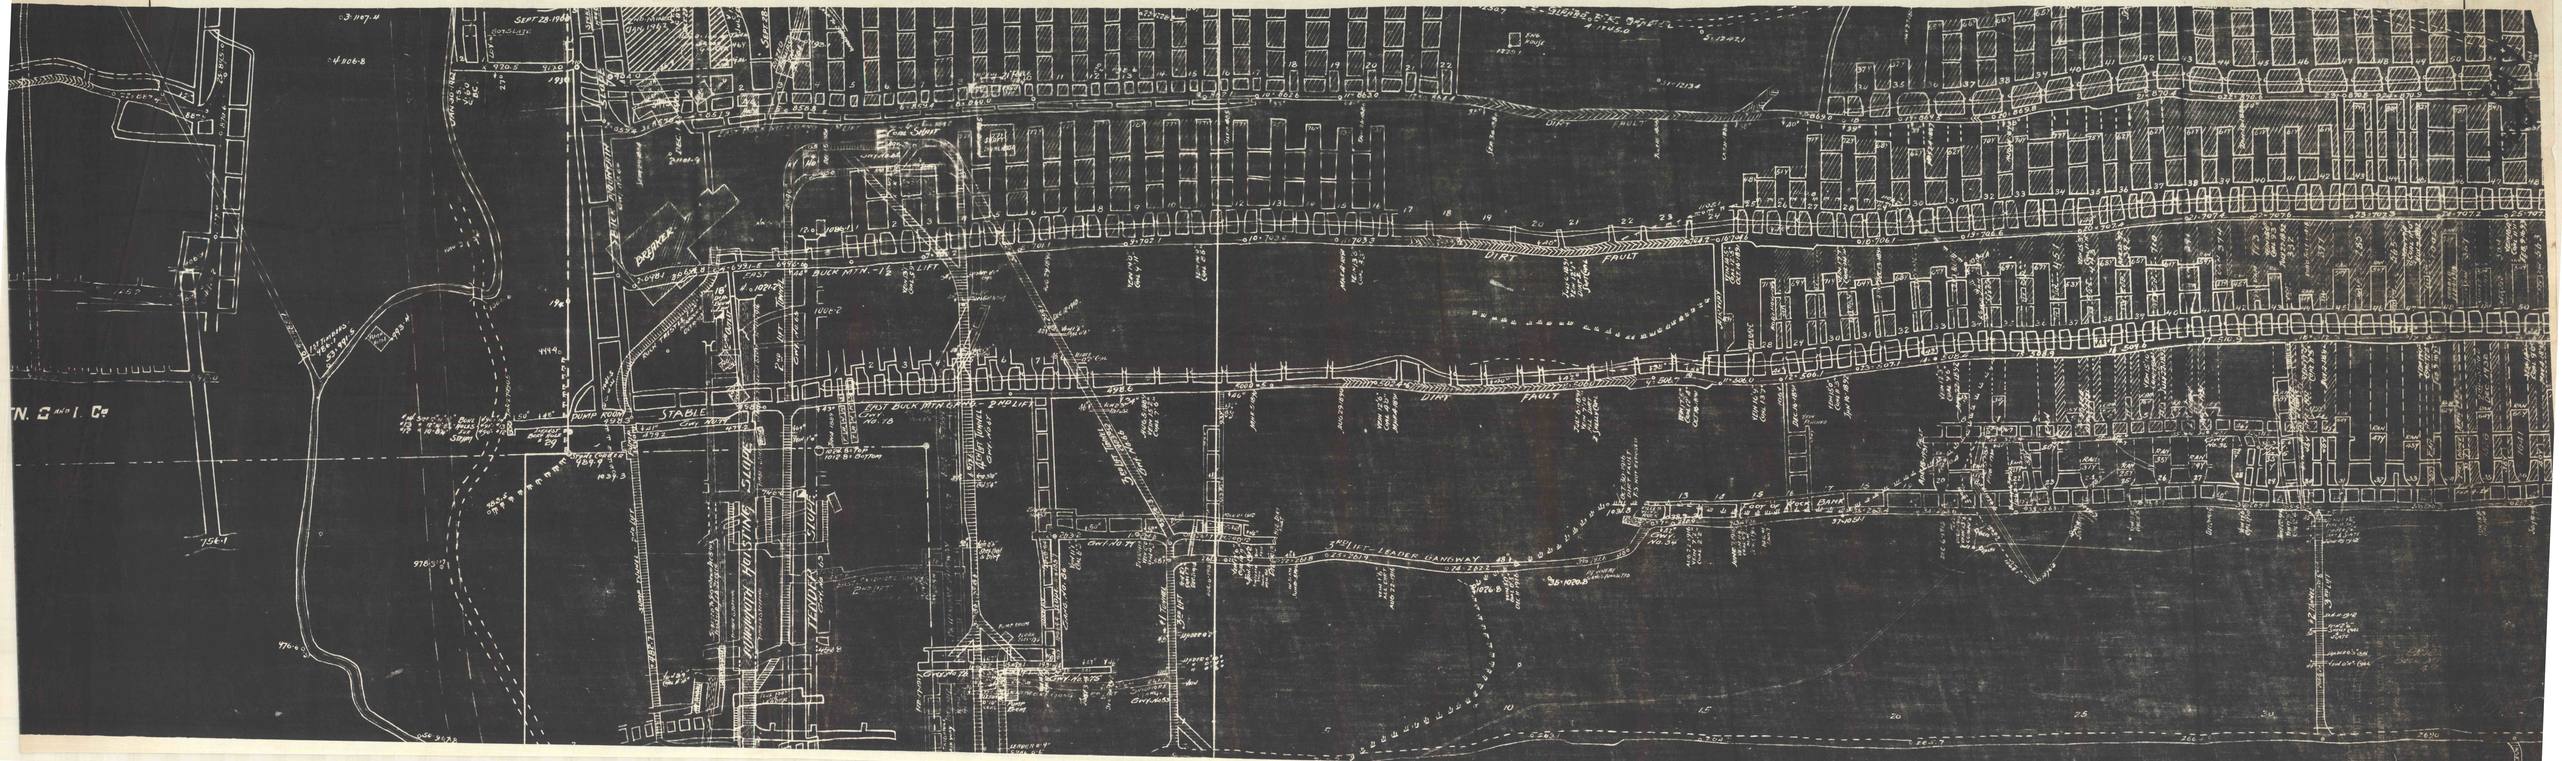
SEPT 28-1960
EAST BUCK MTN. - 1½ LIFT
EAST BUCK MTN. - 2nd LIFT
DIRT FAULT
DIRT FAULT
STABLE
DUMP ROOM
POWDER HOISTING SLOPE
TROOPER SLOPE
3rd LIFT LEADER GANGWAY
BANK
N. C. & I. Co