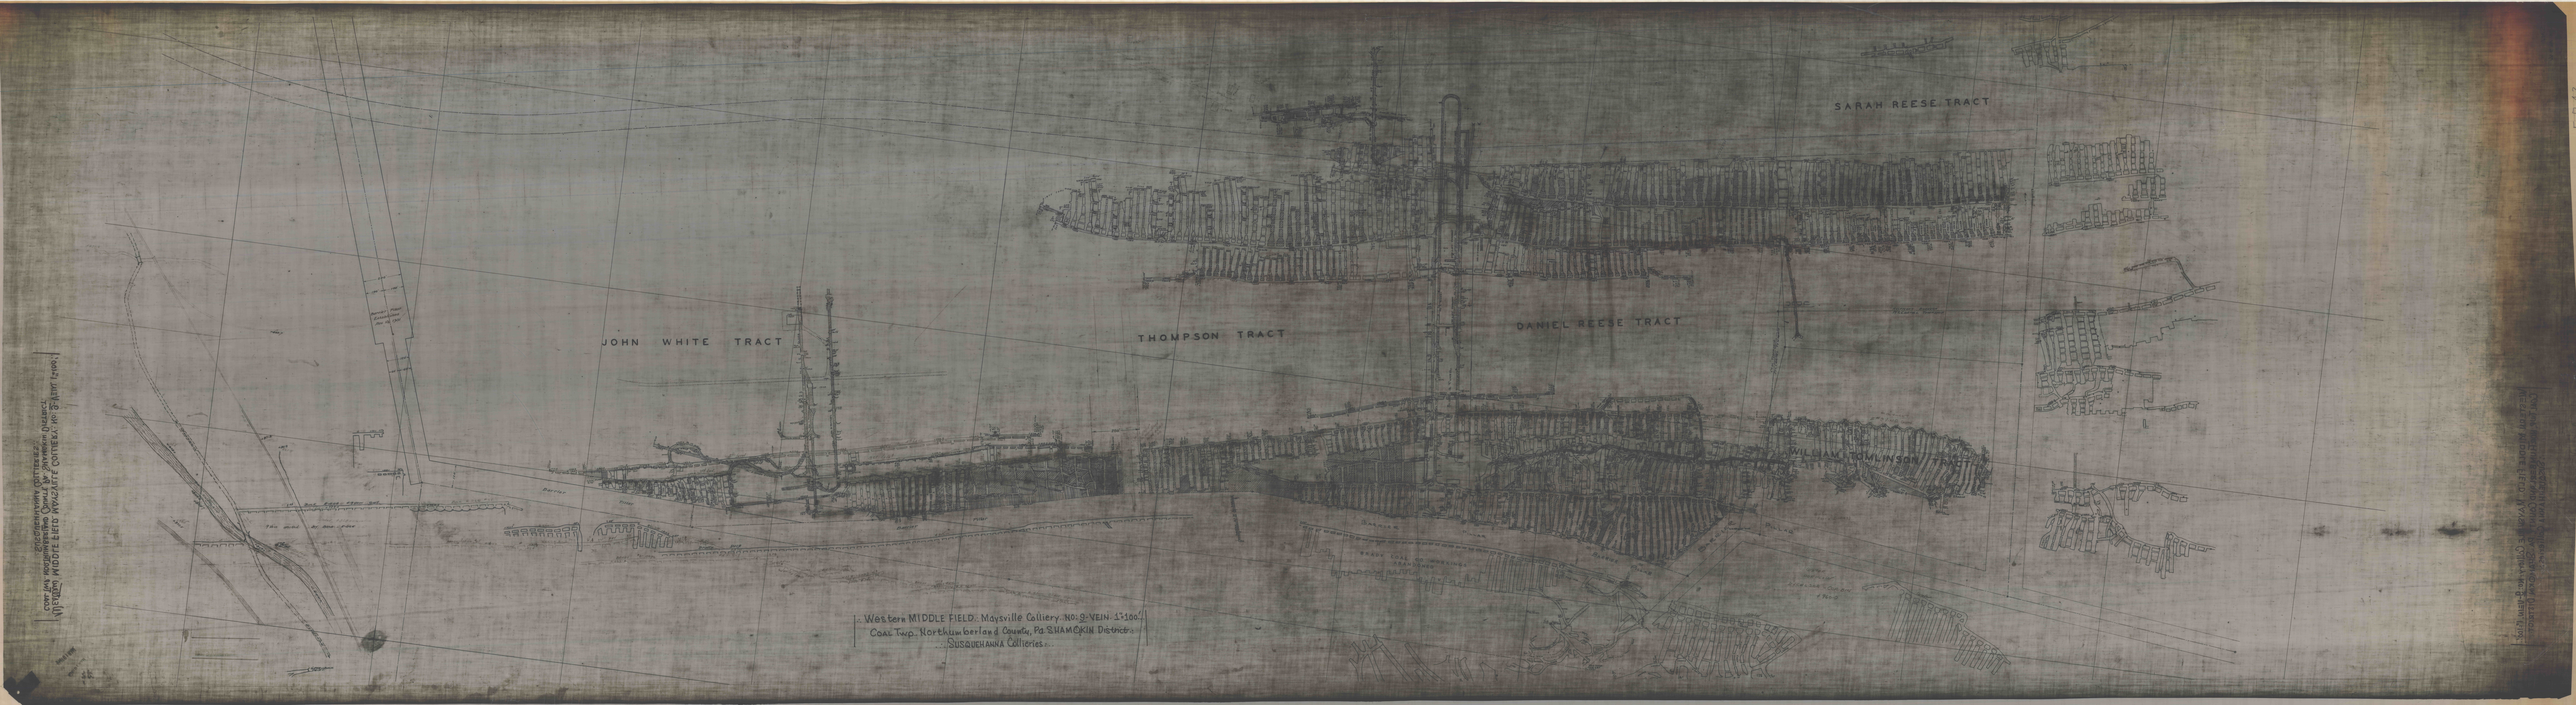

Western MIDDLE FIELD. Maysville Colliery No. 9 VEIN. 1"=100'
Coal Twp. Northumberland County, Pa. SHAMOKIN District.
SUSQUEHANNA Collieries.