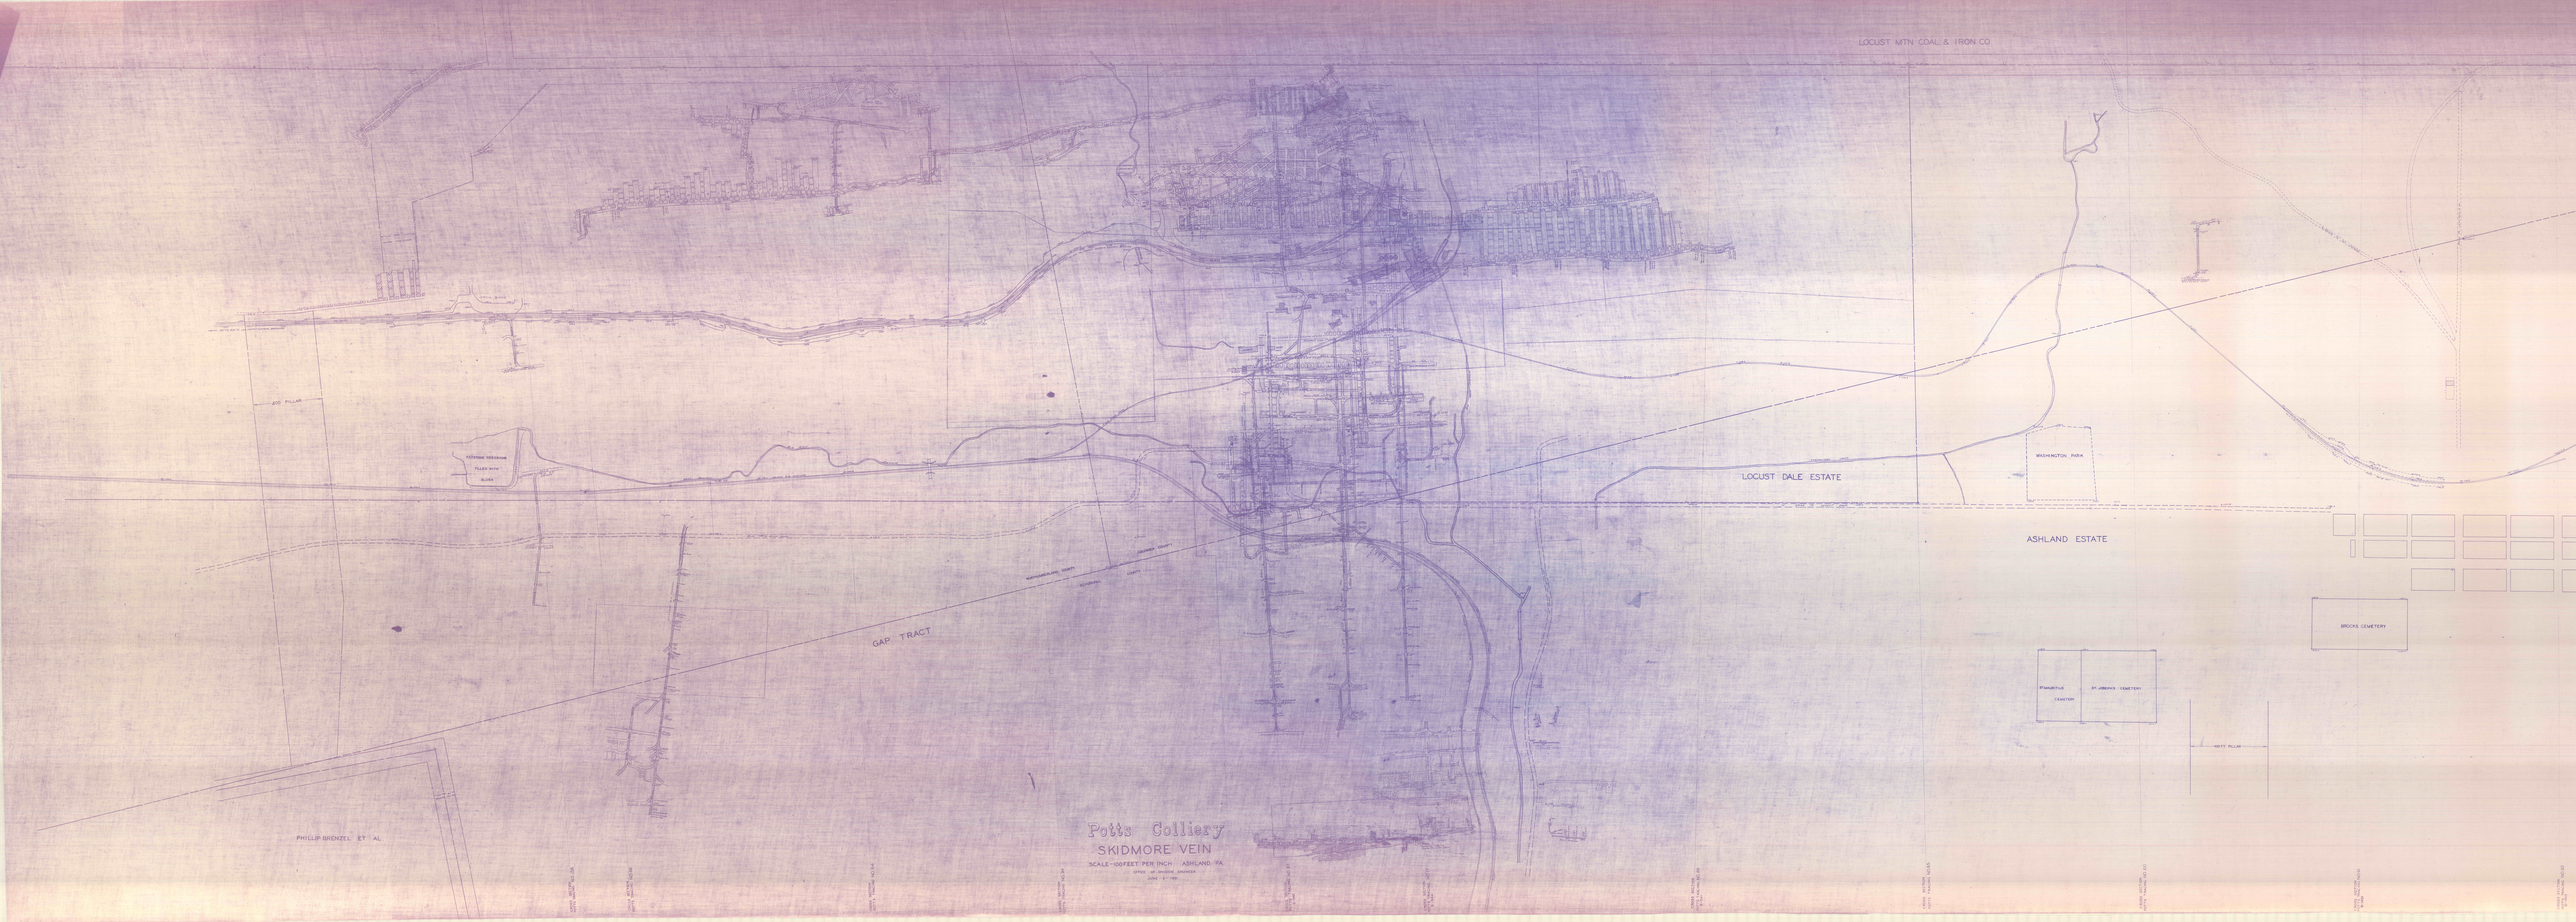
LOCUST MTN COAL & IRON CO
LOCUST DALE ESTATE
WASHINGTON PARK
ASHLAND ESTATE
BROCKS CEMETERY
ST MARKUS CEMETERY
ST JOSEPHS CEMETERY
GAP TRACT
PHILLIP BRENZEL ET AL
Potts Colliery
SKIDMORE VEIN
SCALE-100FEET PER INCH ASHLAND, PA