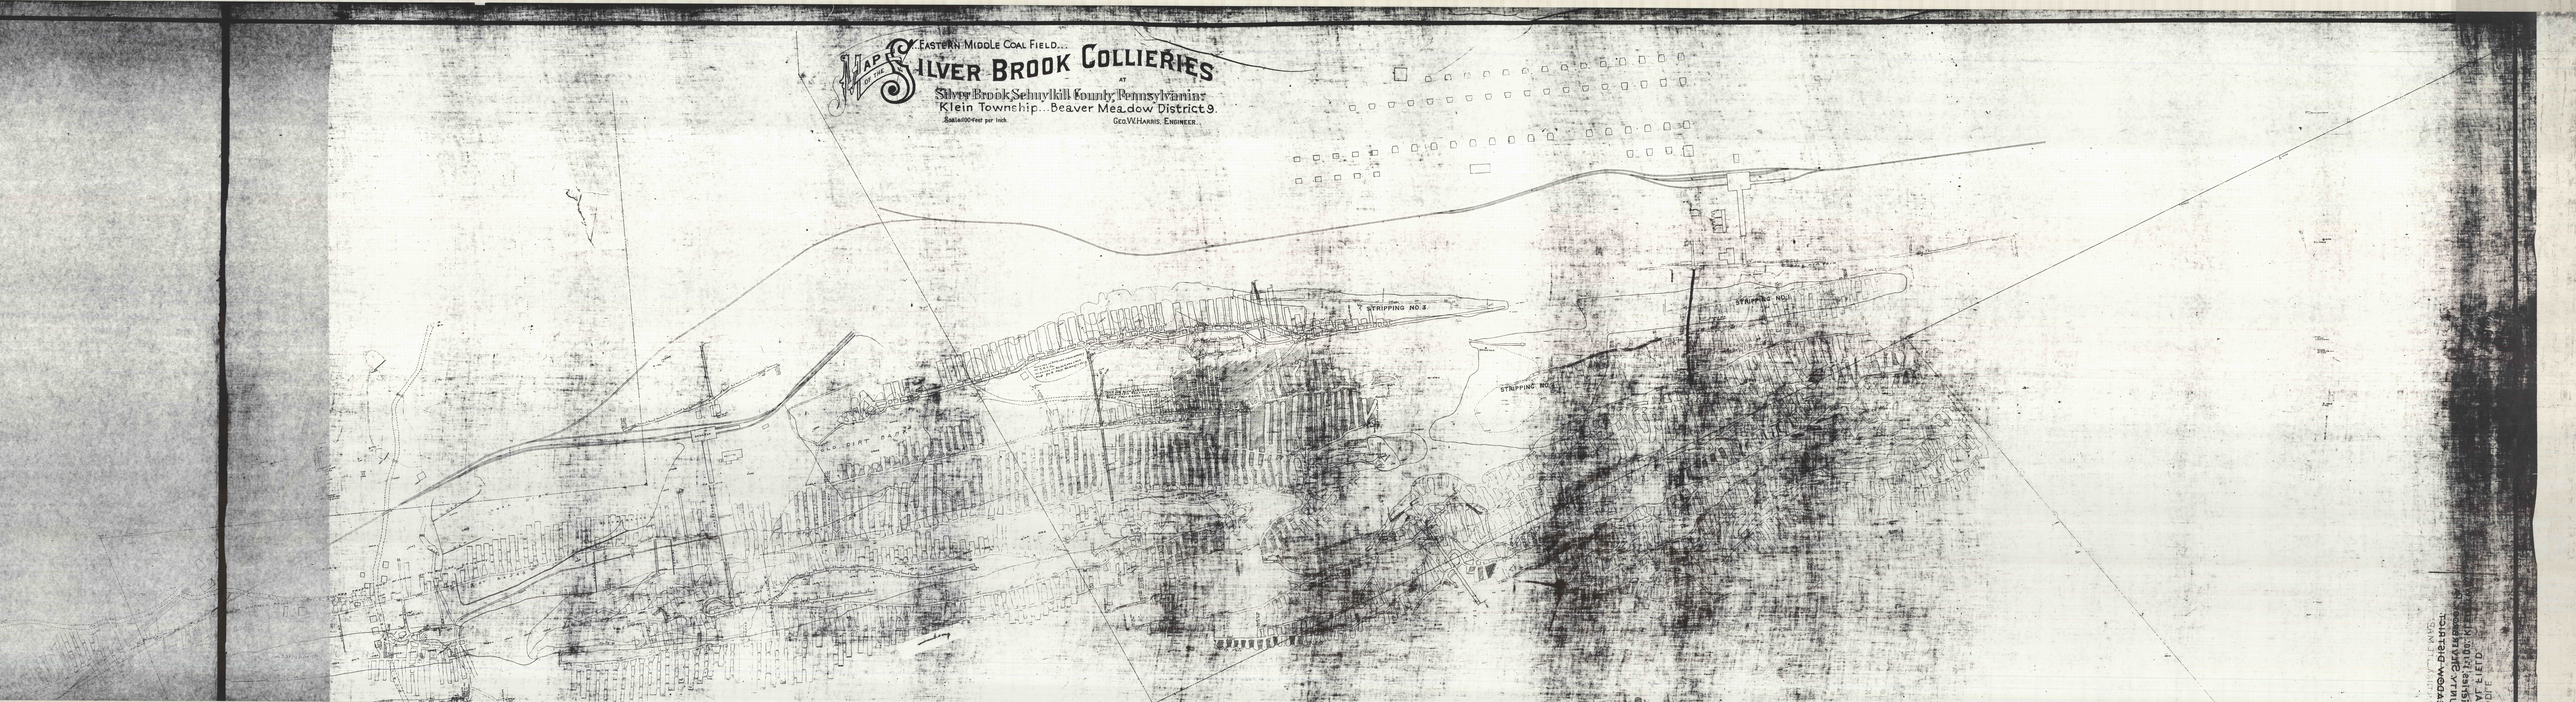

Eastern Middle Coal Field...
Map of the Silver Brook Collieries
at
Silver Brook, Schuylkill County, Pennsylvania.
Klein Township... Beaver Meadow District 9.
Scale 600 feet per inch.
Geo. W. Harris, Engineer.
Stripping No. 3
Stripping No. 1
Stripping No. 2