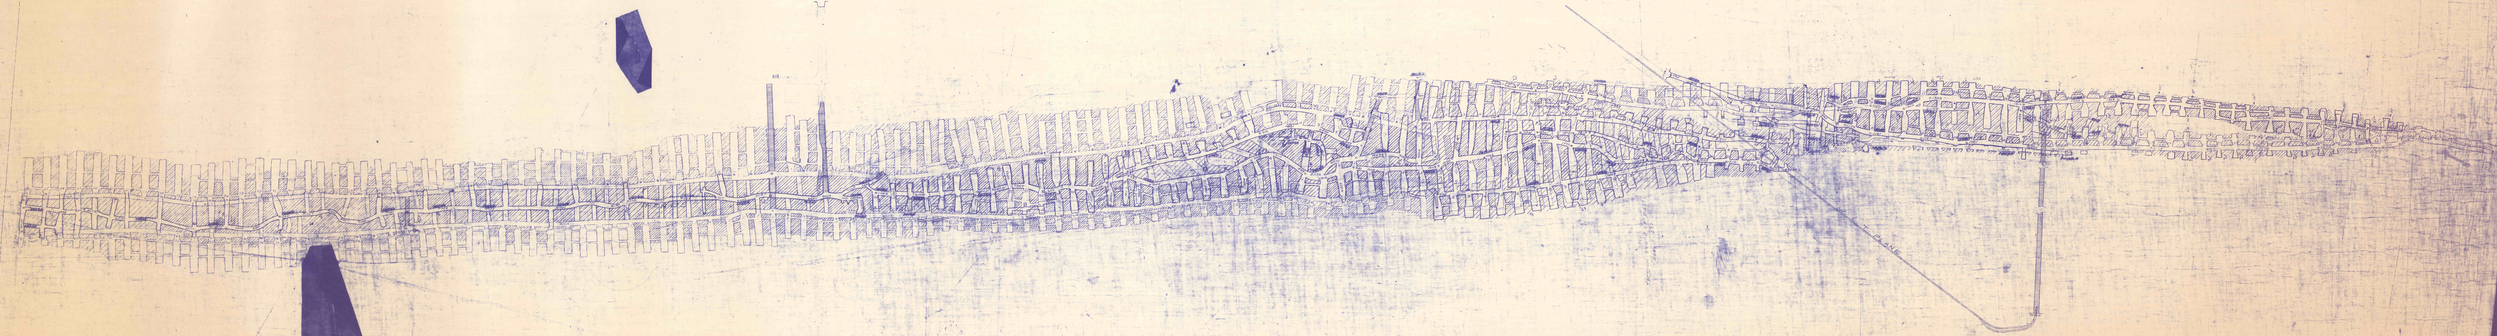

JM
MAR 10 1972
MF

Green Mtn. Colly.
Wharton Vein.
1" = 100'.

1 of 5.

GREEN MT'N
WHARTON VEIN.