

STUDY AREA PLAN
SCALE 1" = 5000'

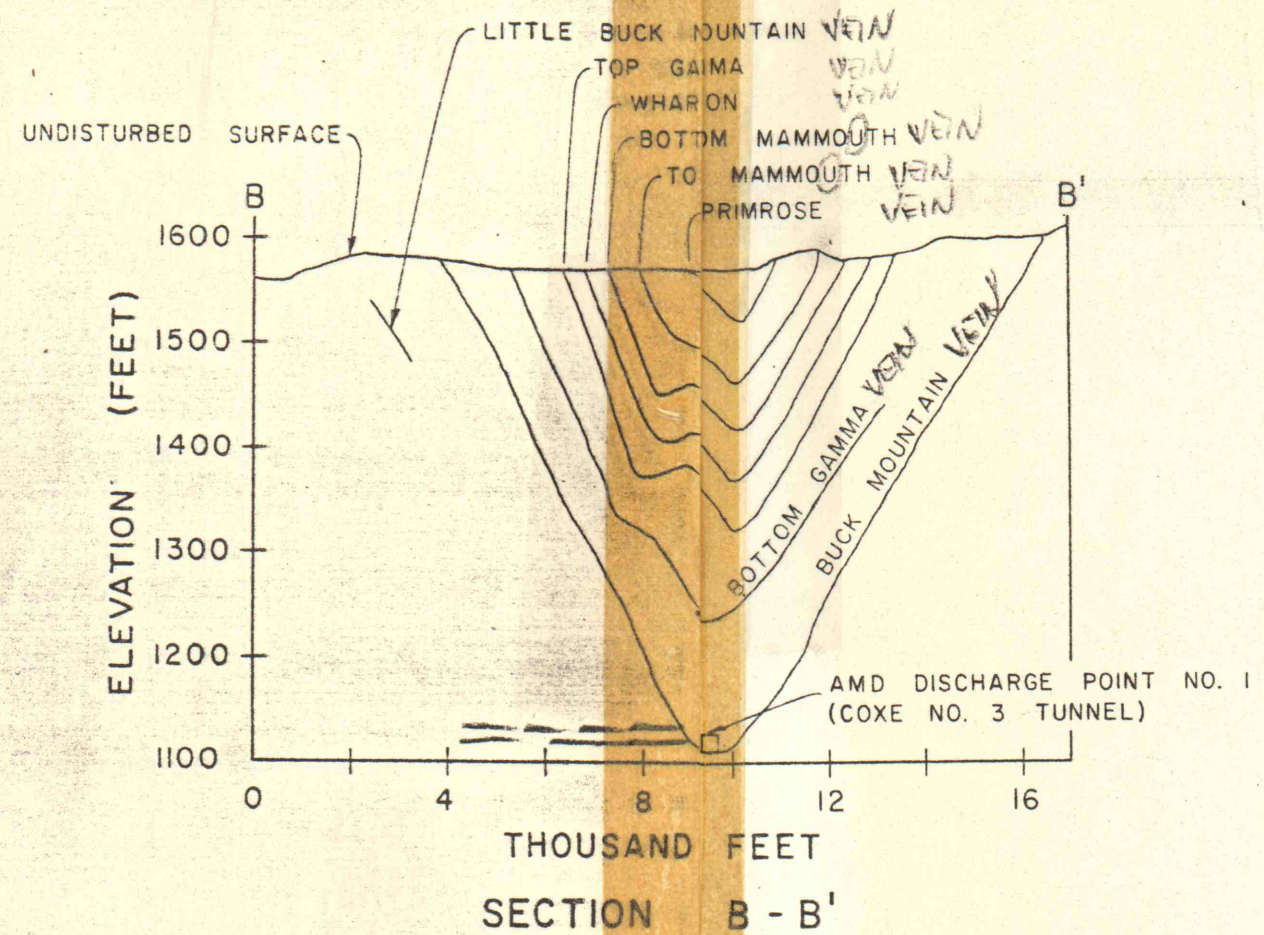
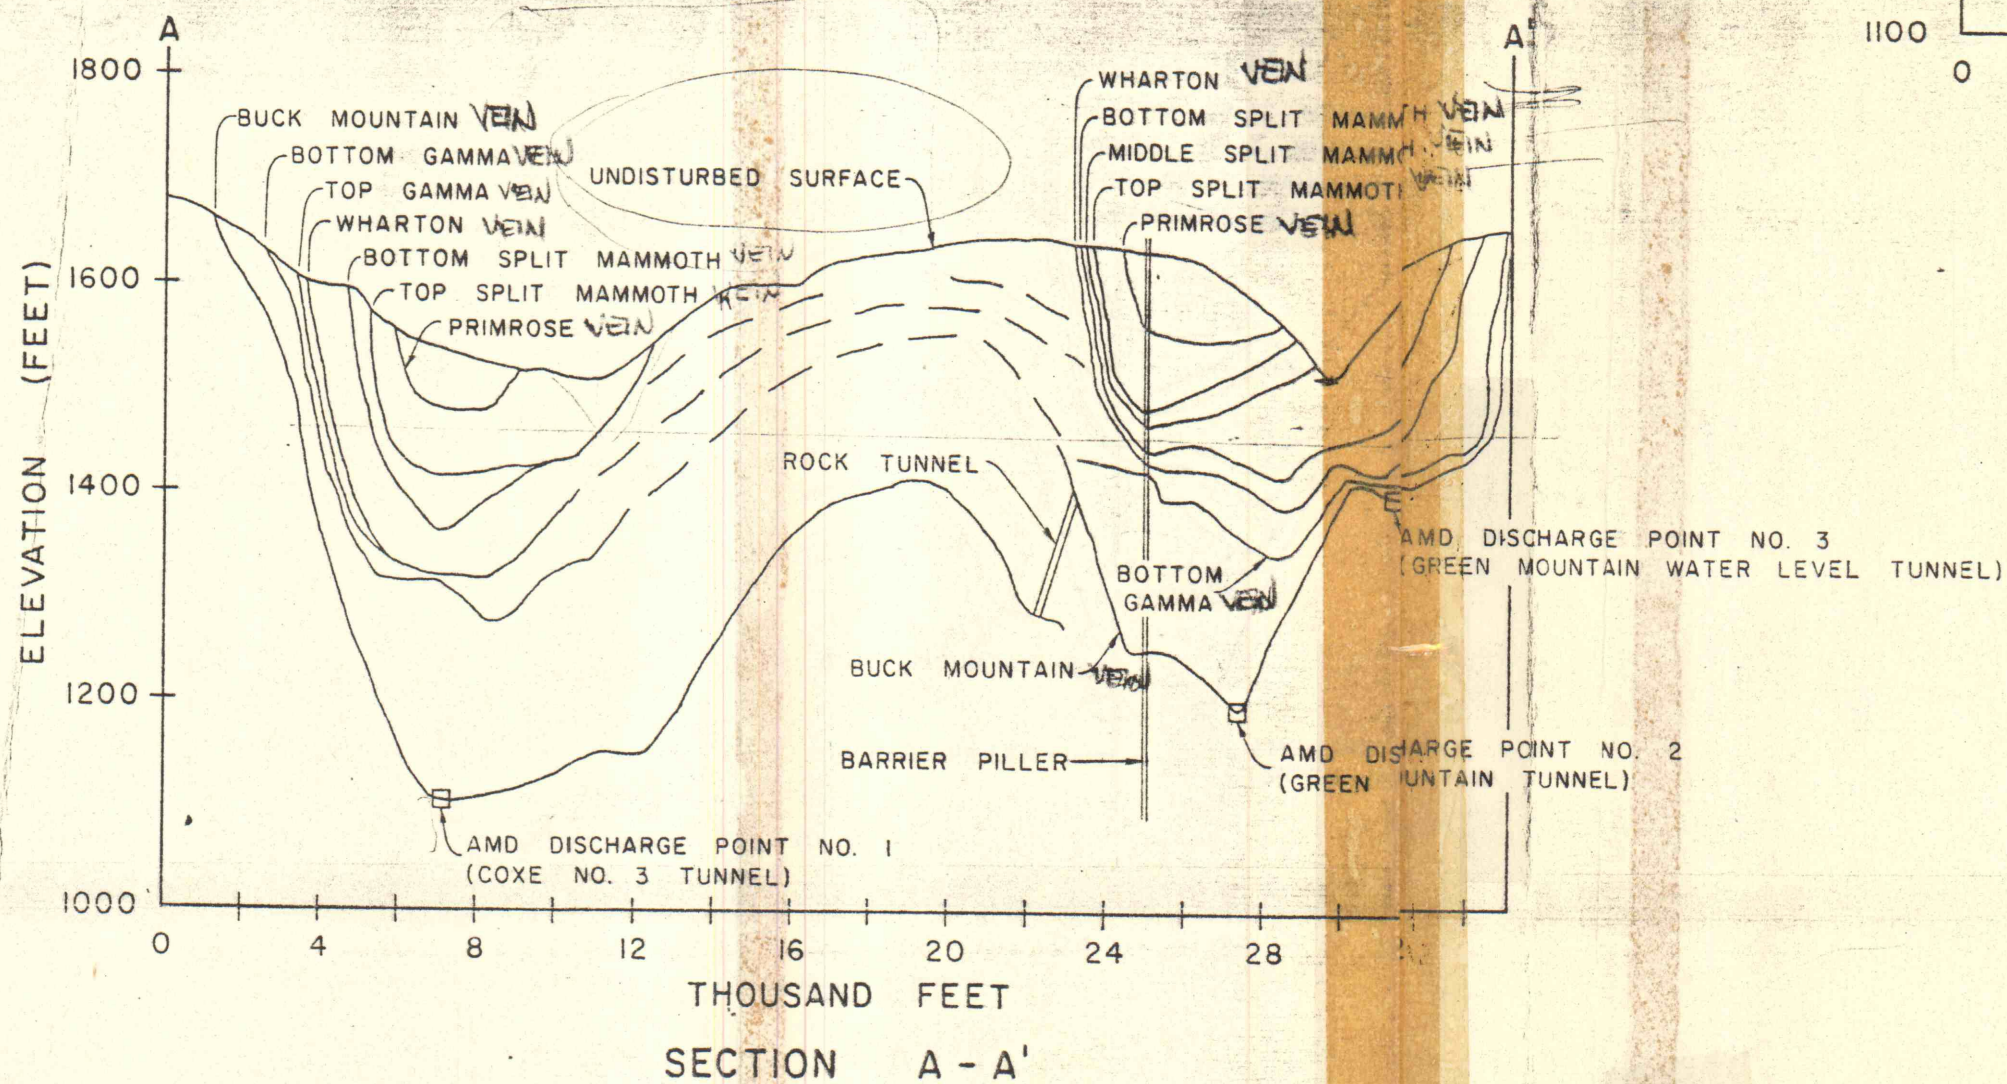


PLATE III (Sheppton)

UNITED STATES DEPARTMENT OF THE INTERIOR
FEDERAL WATER POLLUTION CONTROL ADMINISTRATION

ACID MINE DRAINAGE ABATEMENT MEASURES

VEINS
SHEPPTON COAL SEAMS

GANNETT FLEMING CORDRY & CARPENTER, INC.
ENGINEERS

600 N. SECOND ST. HARRISBURG, PENNA.

AUGUST 1967