


1573.2

1538.7

1558.0

1567.0

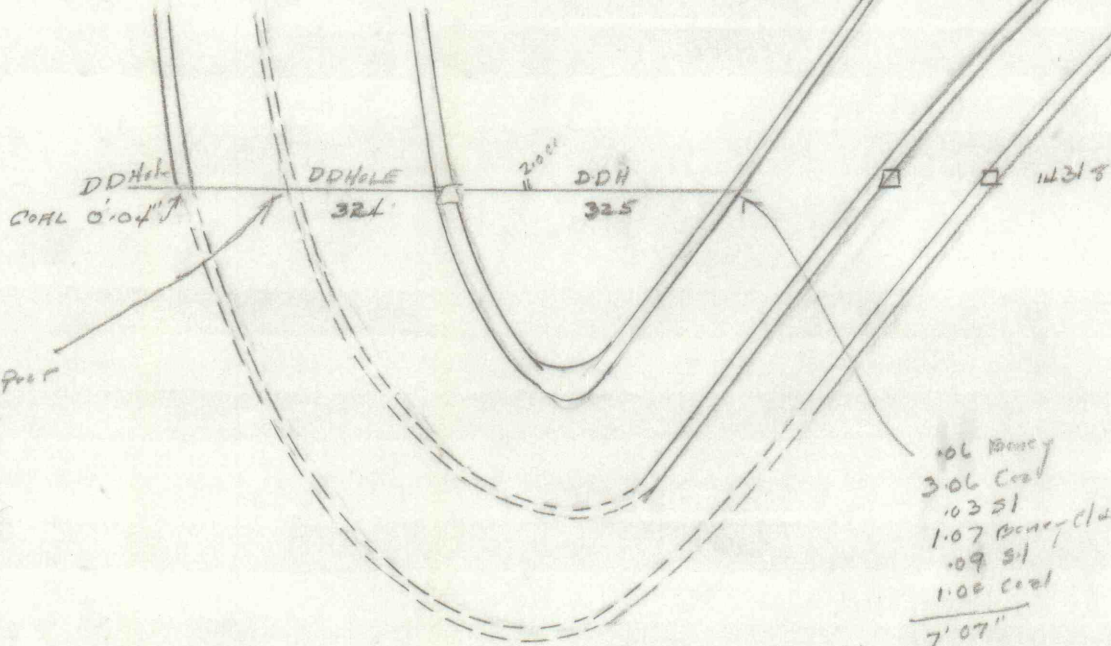

0.10 Bone  
 1.00 slate  
 2.02 Coal  
 .02 Bone  
 .03 slate  
 .04 Bone  
 0.7 Coal  
 ---  
 5' 04"

.06 Bone  
 3.06 Coal  
 .03 sl  
 1.07 Bone (4.21)  
 .09 sl  
 1.00 Coal  
 ---  
 7' 07"

GREEN Mtn. Colliv. SECTION 628

1000

SCALE 1" = 100'