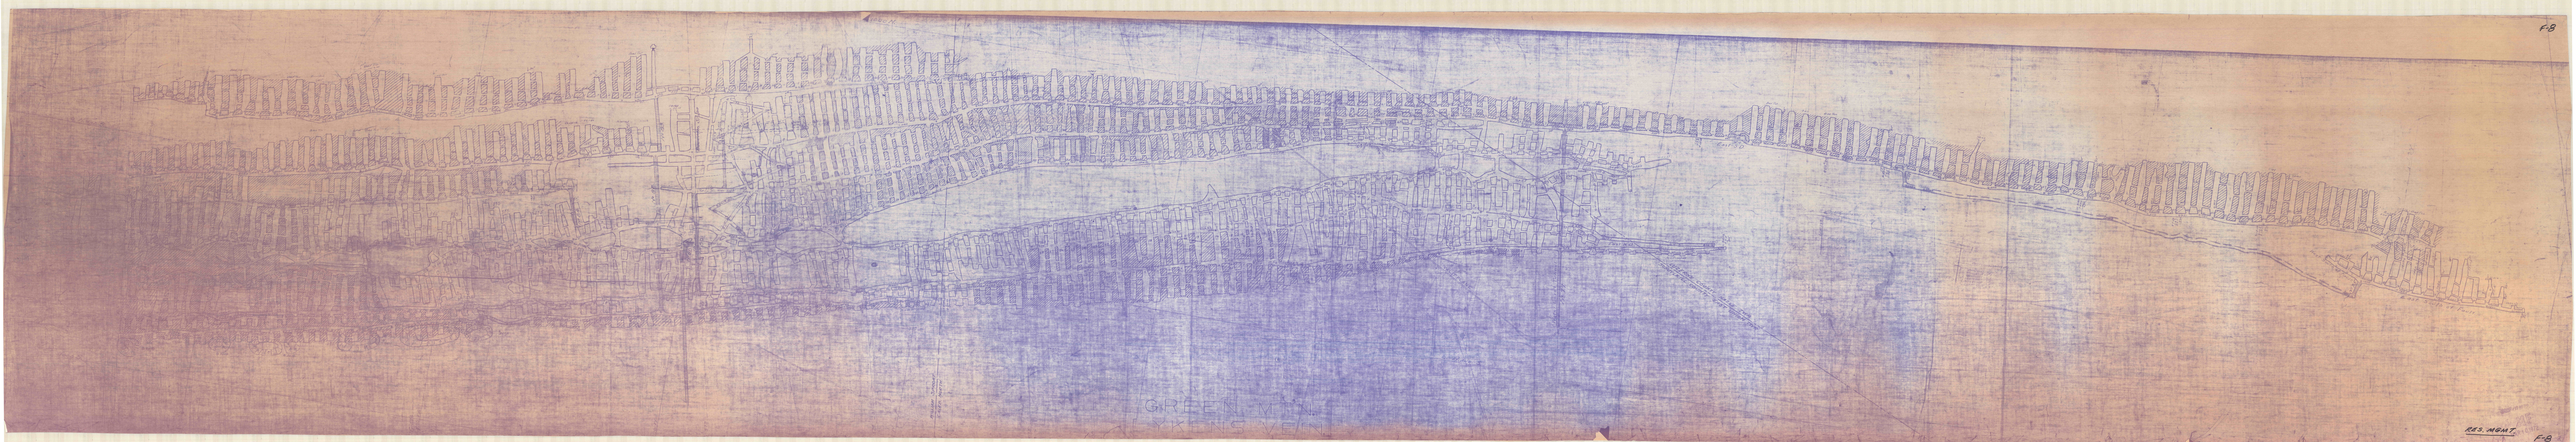
GREEN MT.
RES. HEIGHT.