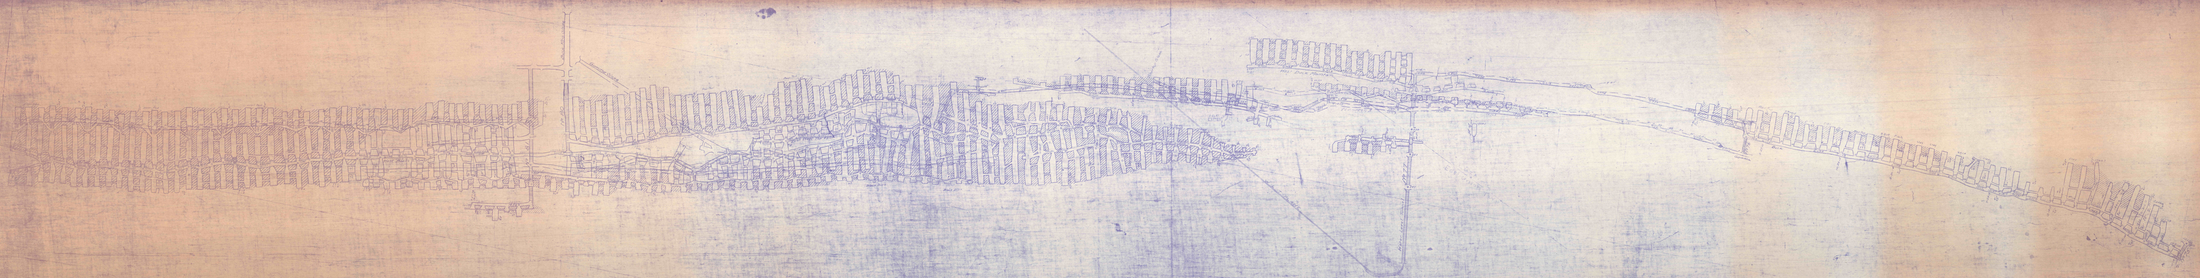

GREEN MT'N
GAMMA TOP SPLIT VEIN

WATER LEVEL TUNNEL
BUCK MT'N VEIN

F-8

223 MONT
F-8