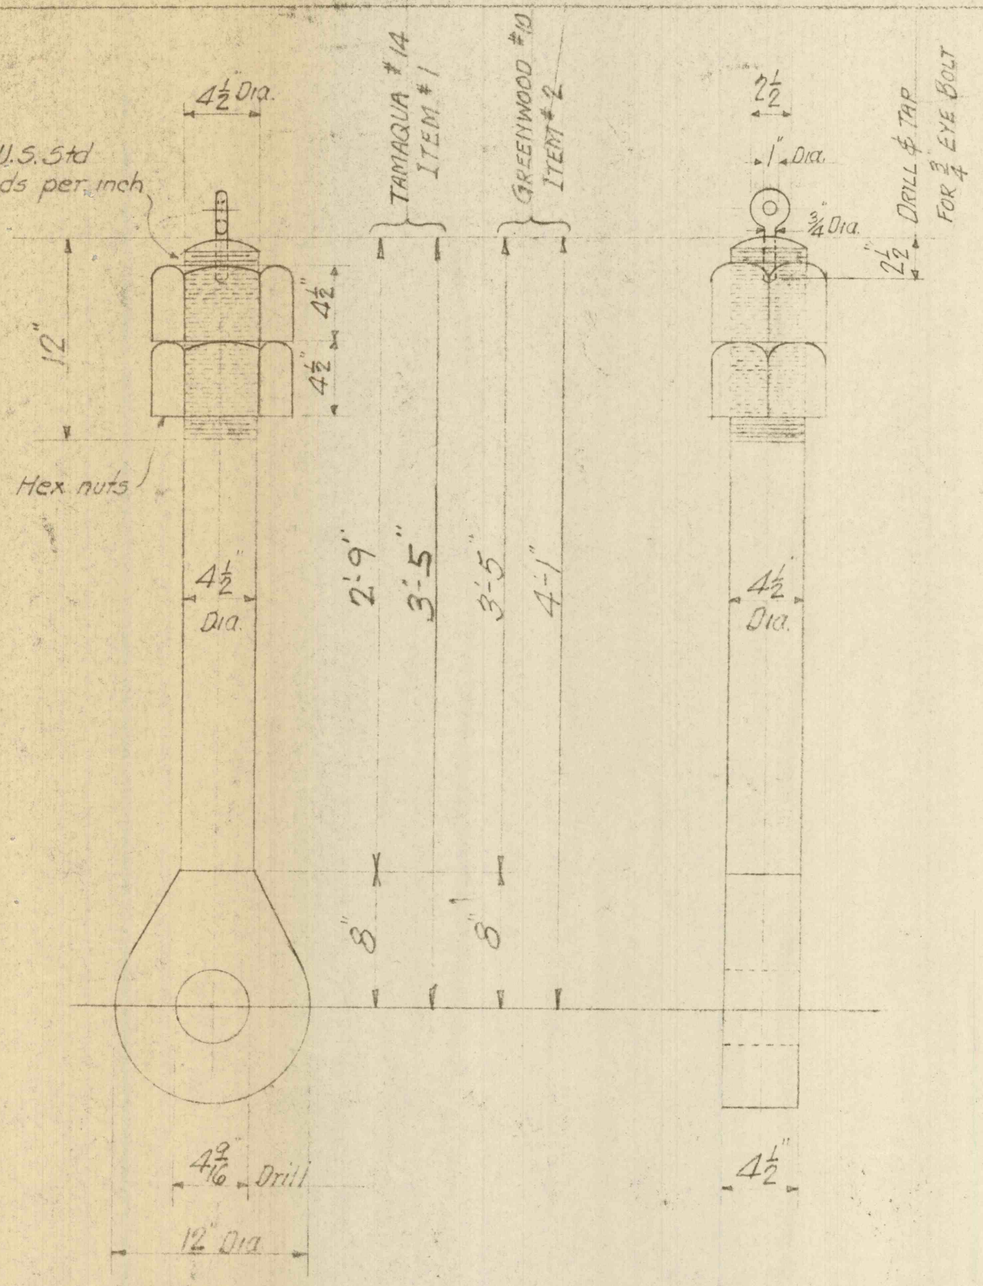

4½ DIA. SPECIAL EYE BOLTS

ITEMS # 1 & # 2.

Item # 1 - Load = 112,500#

Item # 2 - Load = 165,000#

REVISION

(A) - INCREASED LENGTH OF ITEM # 1

LEHIGH COAL & NAVIGATION CO.	
TAMAQUA #14 & GREENWOOD #10 SHAFTS	
4½ DIA. SPECIAL EYEBOLTS	
DATE JUNE 27 1956	DRAWN BY F.T.R.
(A) 5-26-59	TRACED BY R.V.D.
	5-3131