
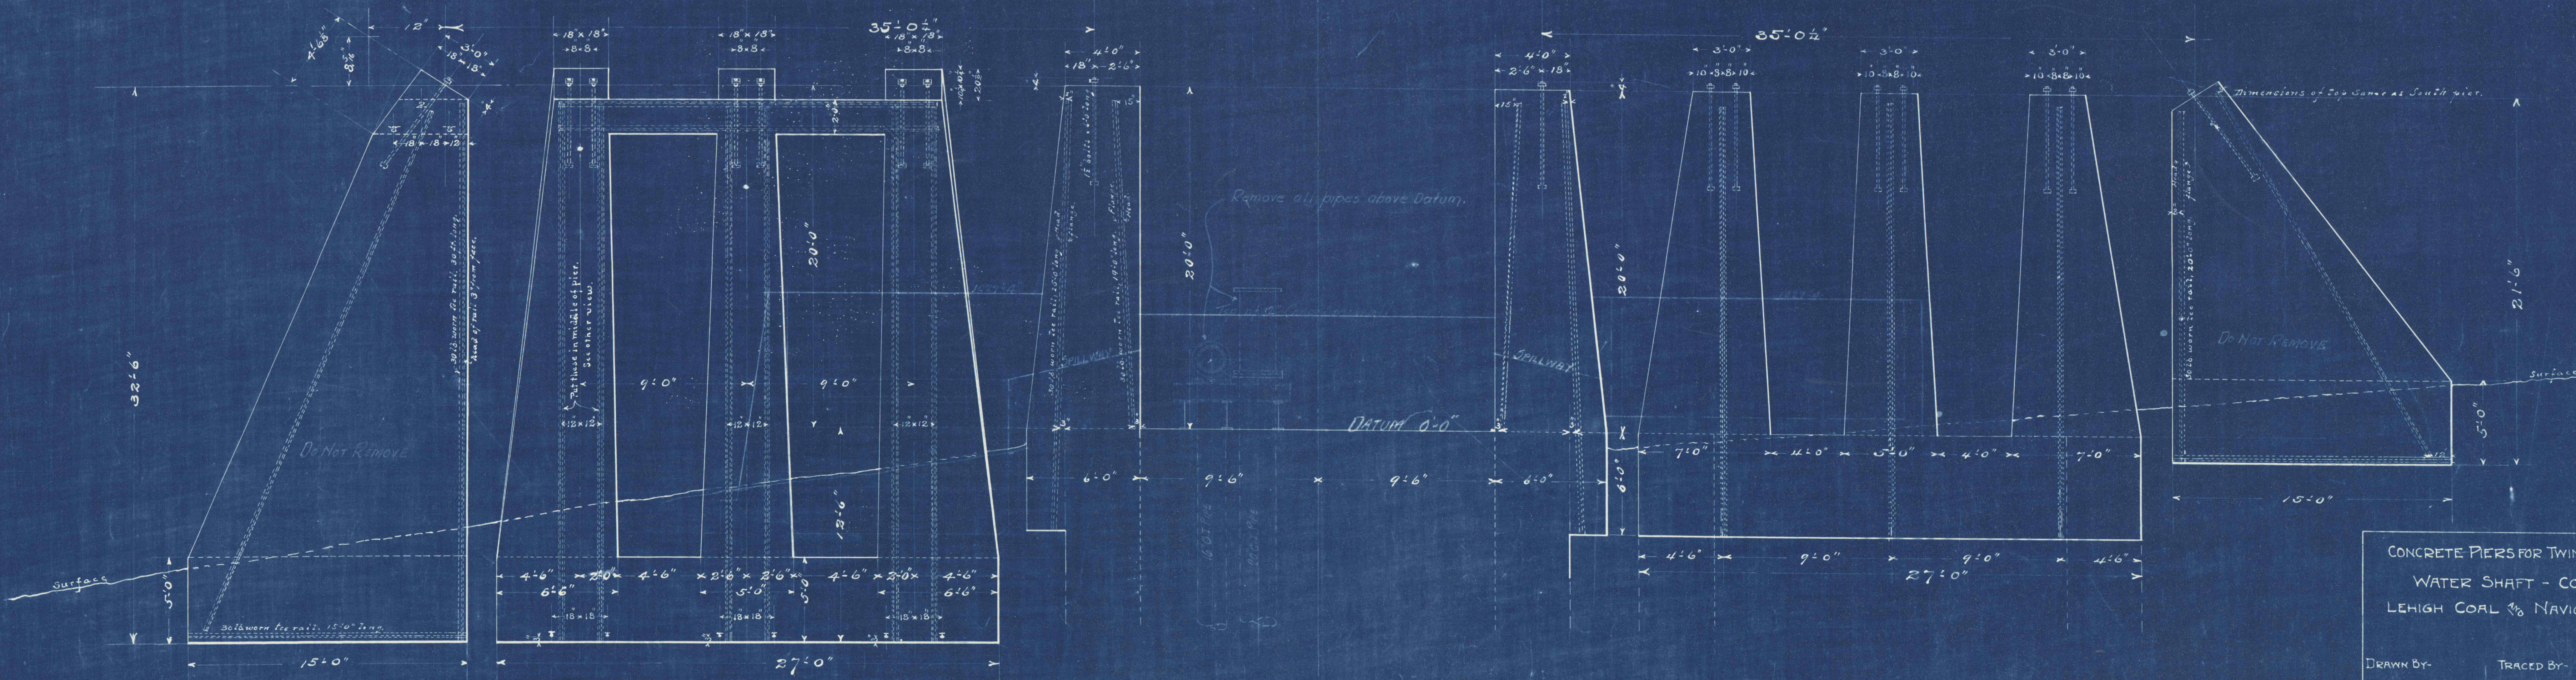


CONCRETE PIERS FOR TWIN HEAD FRAME AT WATER SHAFT. COLLIERY NO. 14.

Scale, $\frac{1}{4}'' = 1'$

Feb. 18th 1907

Cable Supports See Div. 5, 3052

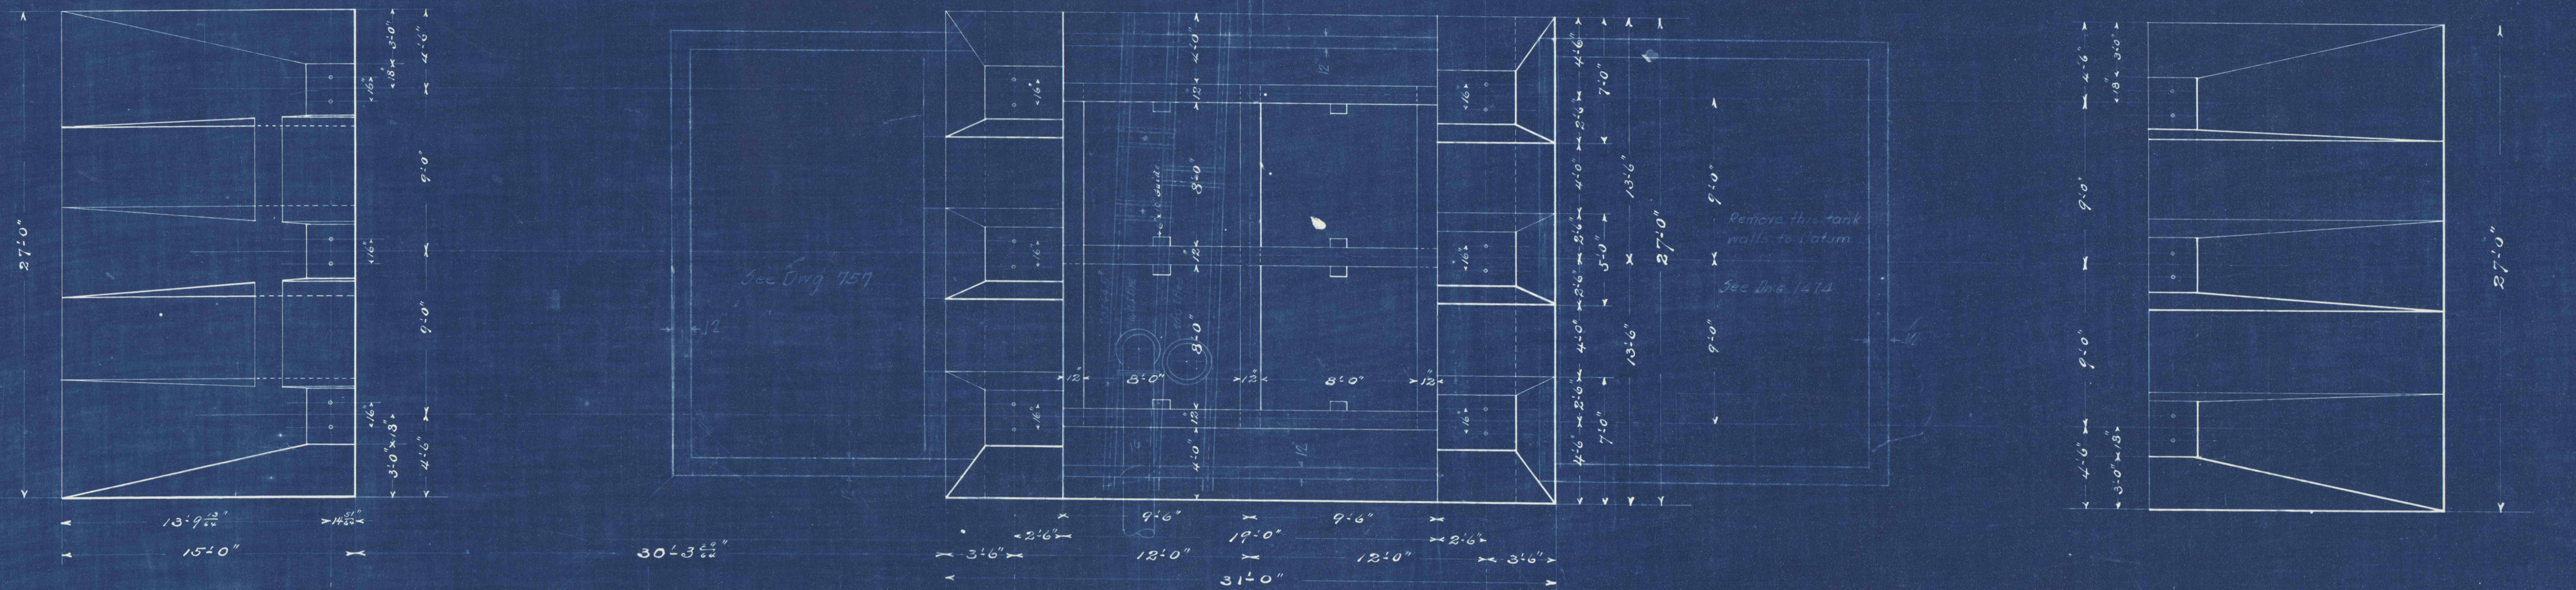

CONCRETE PIERS FOR TWIN HEAD FRAME AT
WATER SHAFT - COLLIERY NO. 14
LEHIGH COAL & NAVIGATION COMPANY

DRAWN BY: _____ TRACED BY: _____ CHECKED BY: _____
 DATE - 2-18-1907 SCALE - $\frac{1}{4}'' = 1'$
 REVISED: _____

DWG-301