
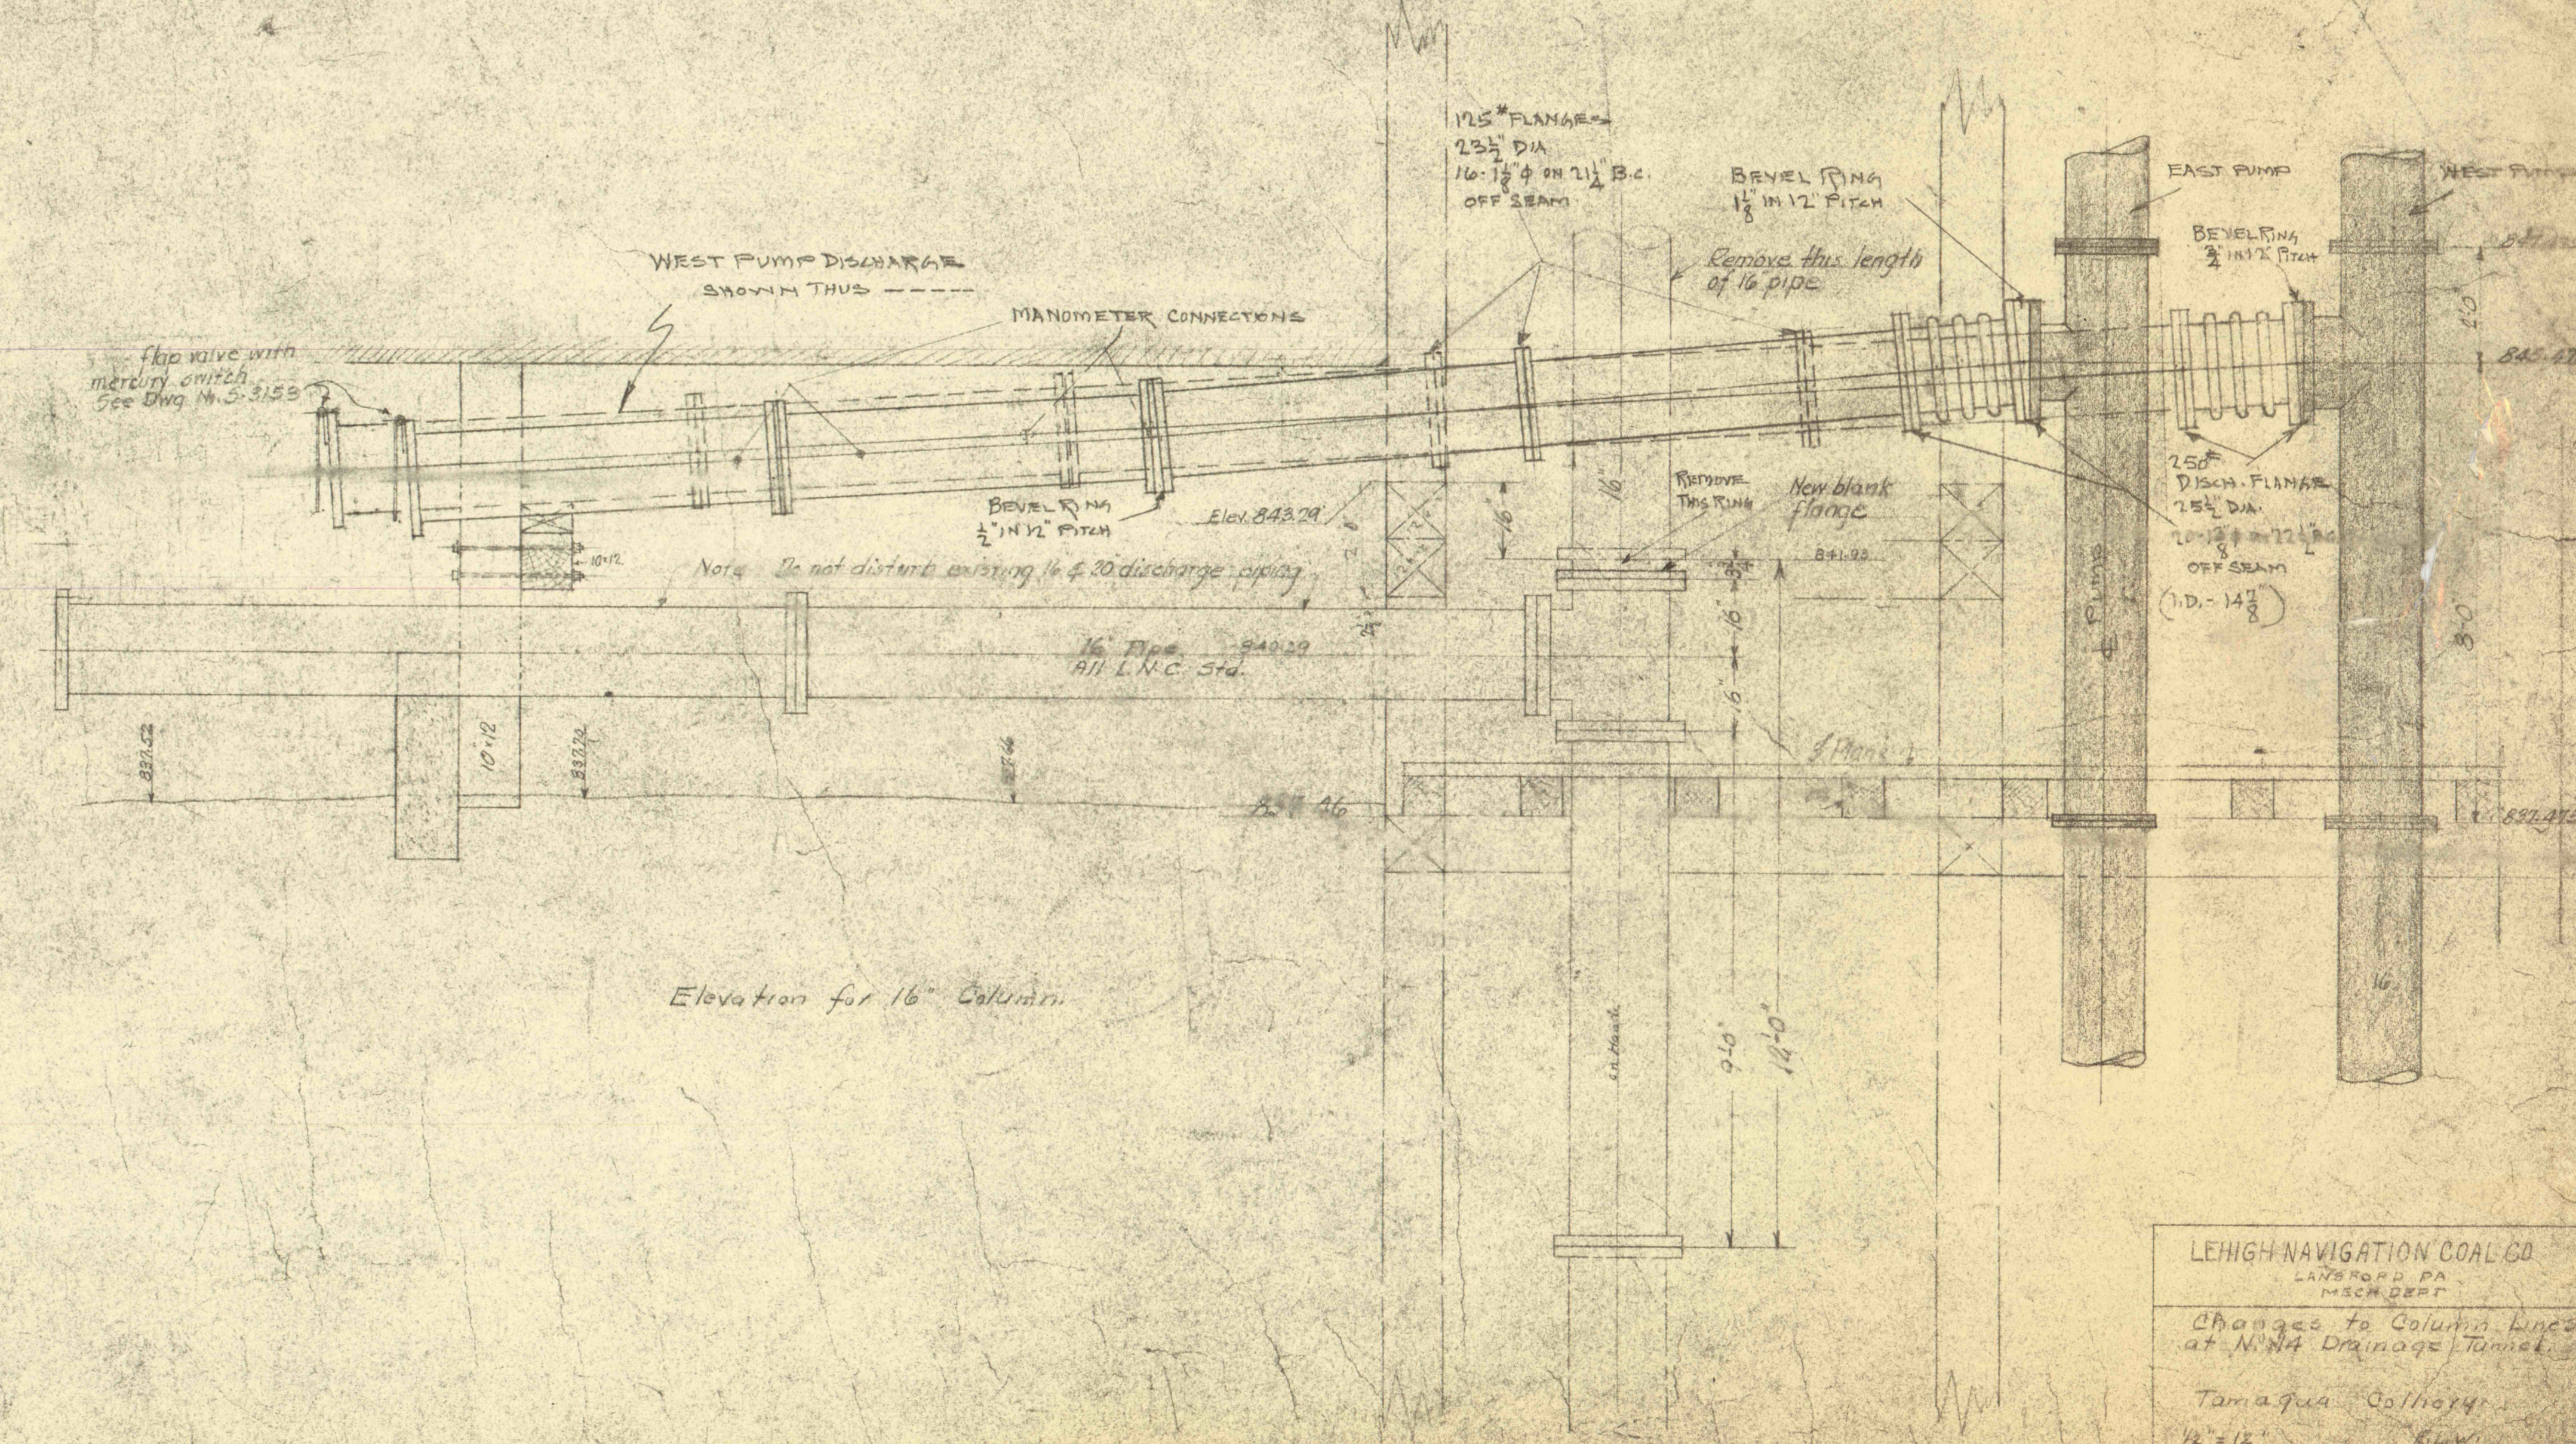


Place 3 plank floor on 8x8 sills over four compartments. All plank and sills to be treated.

NEW 90° EL. ON HAND - L.C. & N. CO.

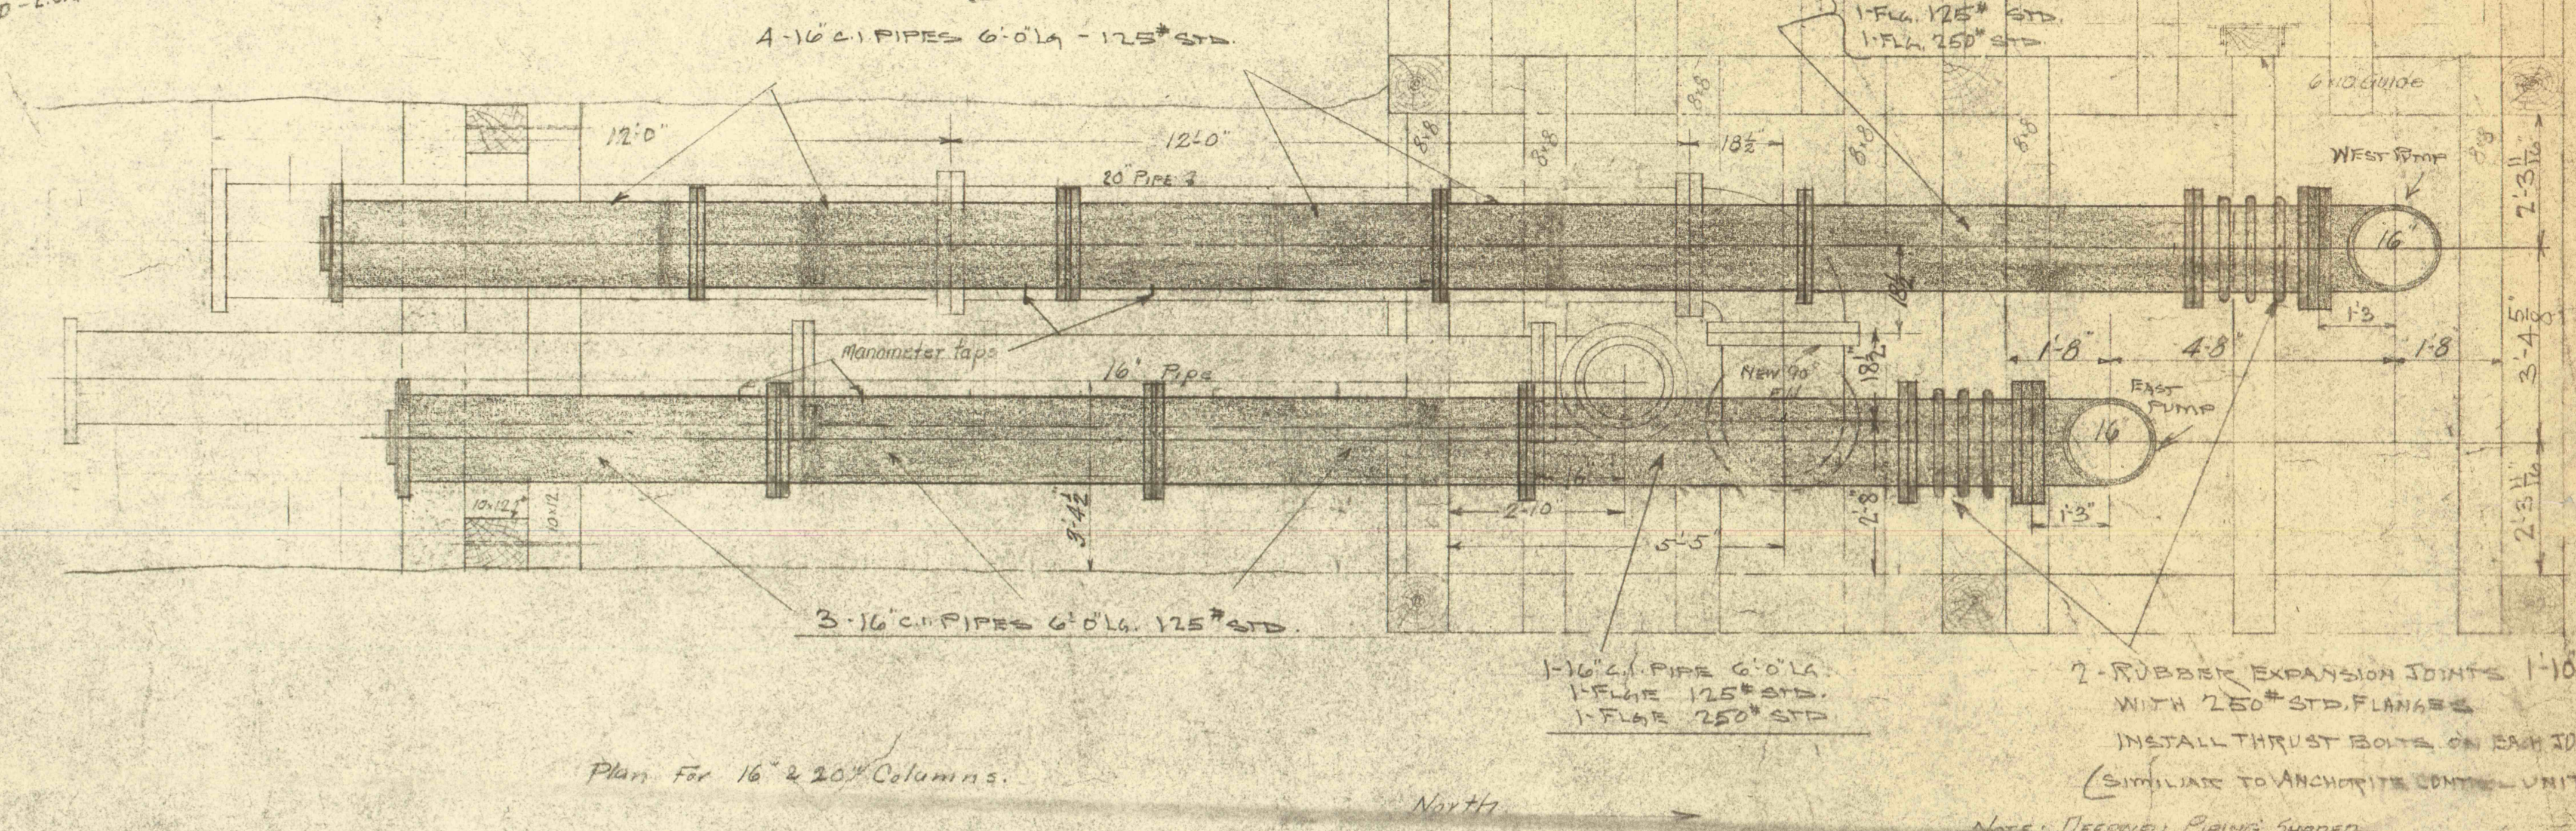

LEHIGH NAVIGATION COAL CO
 LANSFORD, PA.
 Changes to Column Lines at N.W. Drainage Tunnel
 Tamaqua Colliery
 12-12-11
 11-12-11
 Rev. 2-5-58
 Rev. 8-7-58
 Rev. 10-15-58
 Rev. 6-3-59
 3887