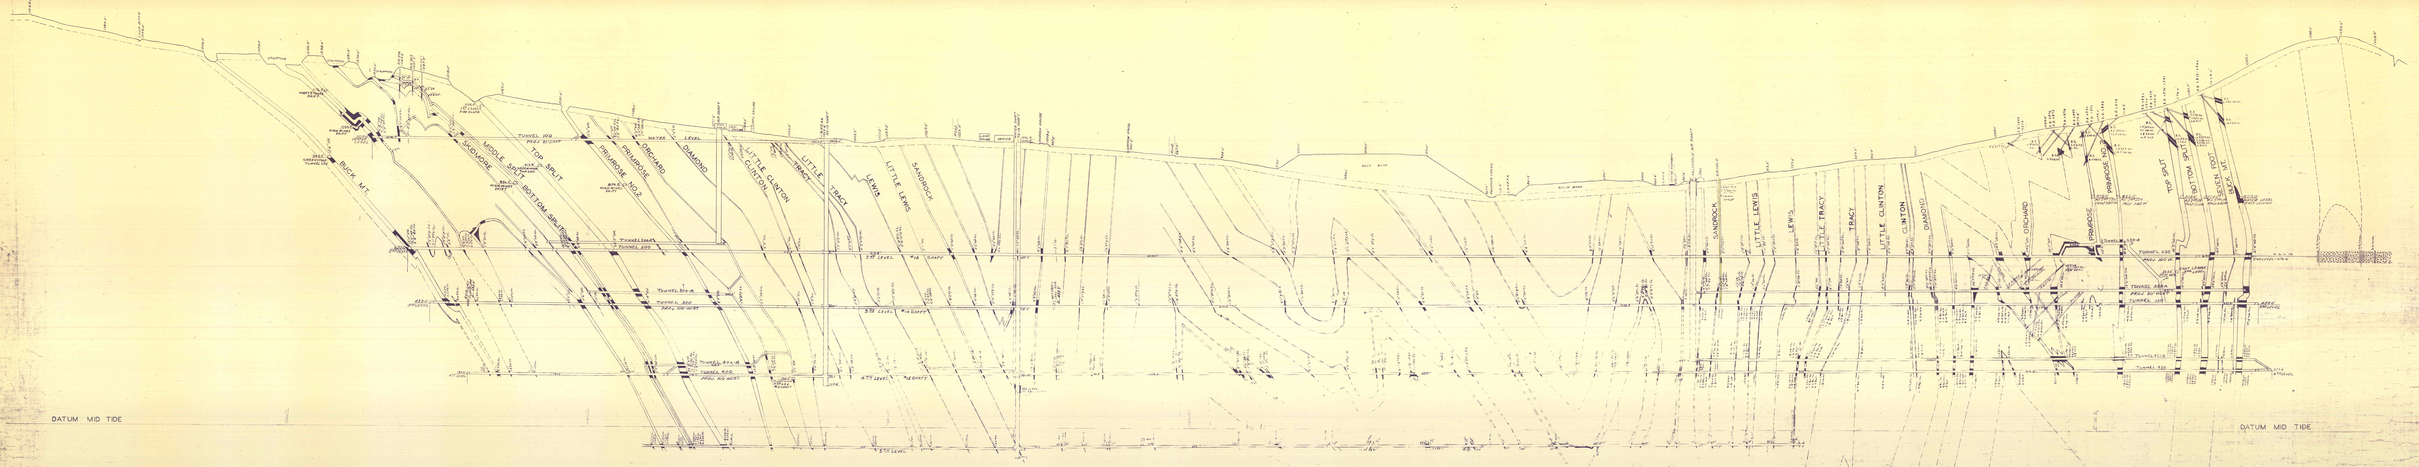

CROSS SECTION O-P

80' W. OF NO.14 SHAFT

SCALE 1"=100' MAY, 1930

W.S. RAUSCH, MIN. ENG'R.