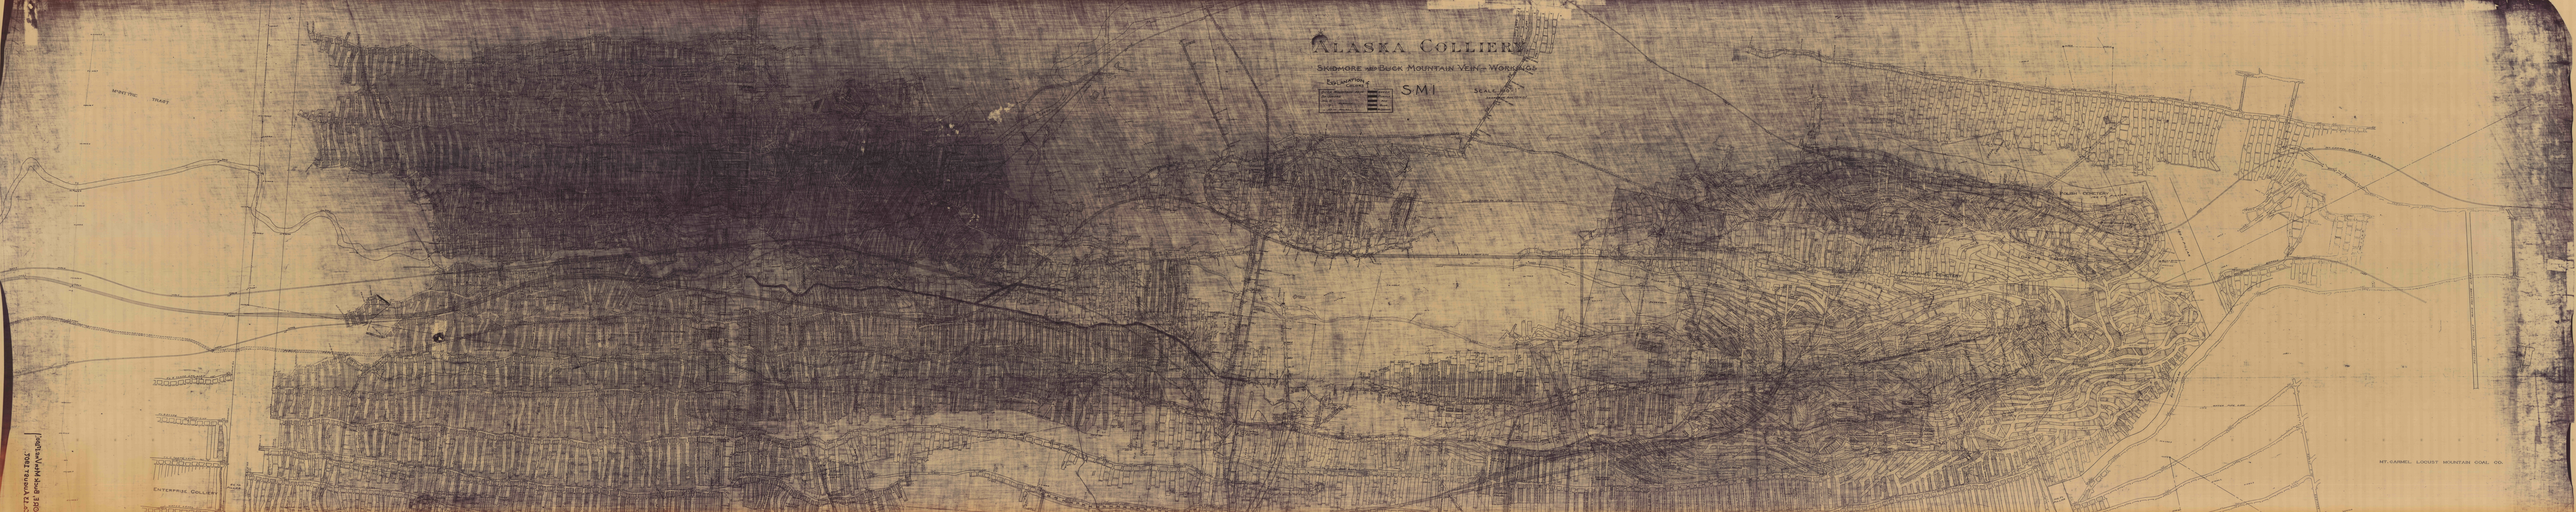
ALASKA COLLIERY
SKIDMORE AND BUCK MOUNTAIN VEINS WORKINGS
SMI
MYRTLE TRACT
ENTERPRISE COLLIERY
MT. CARMEL, LOCUST MOUNTAIN COAL CO.