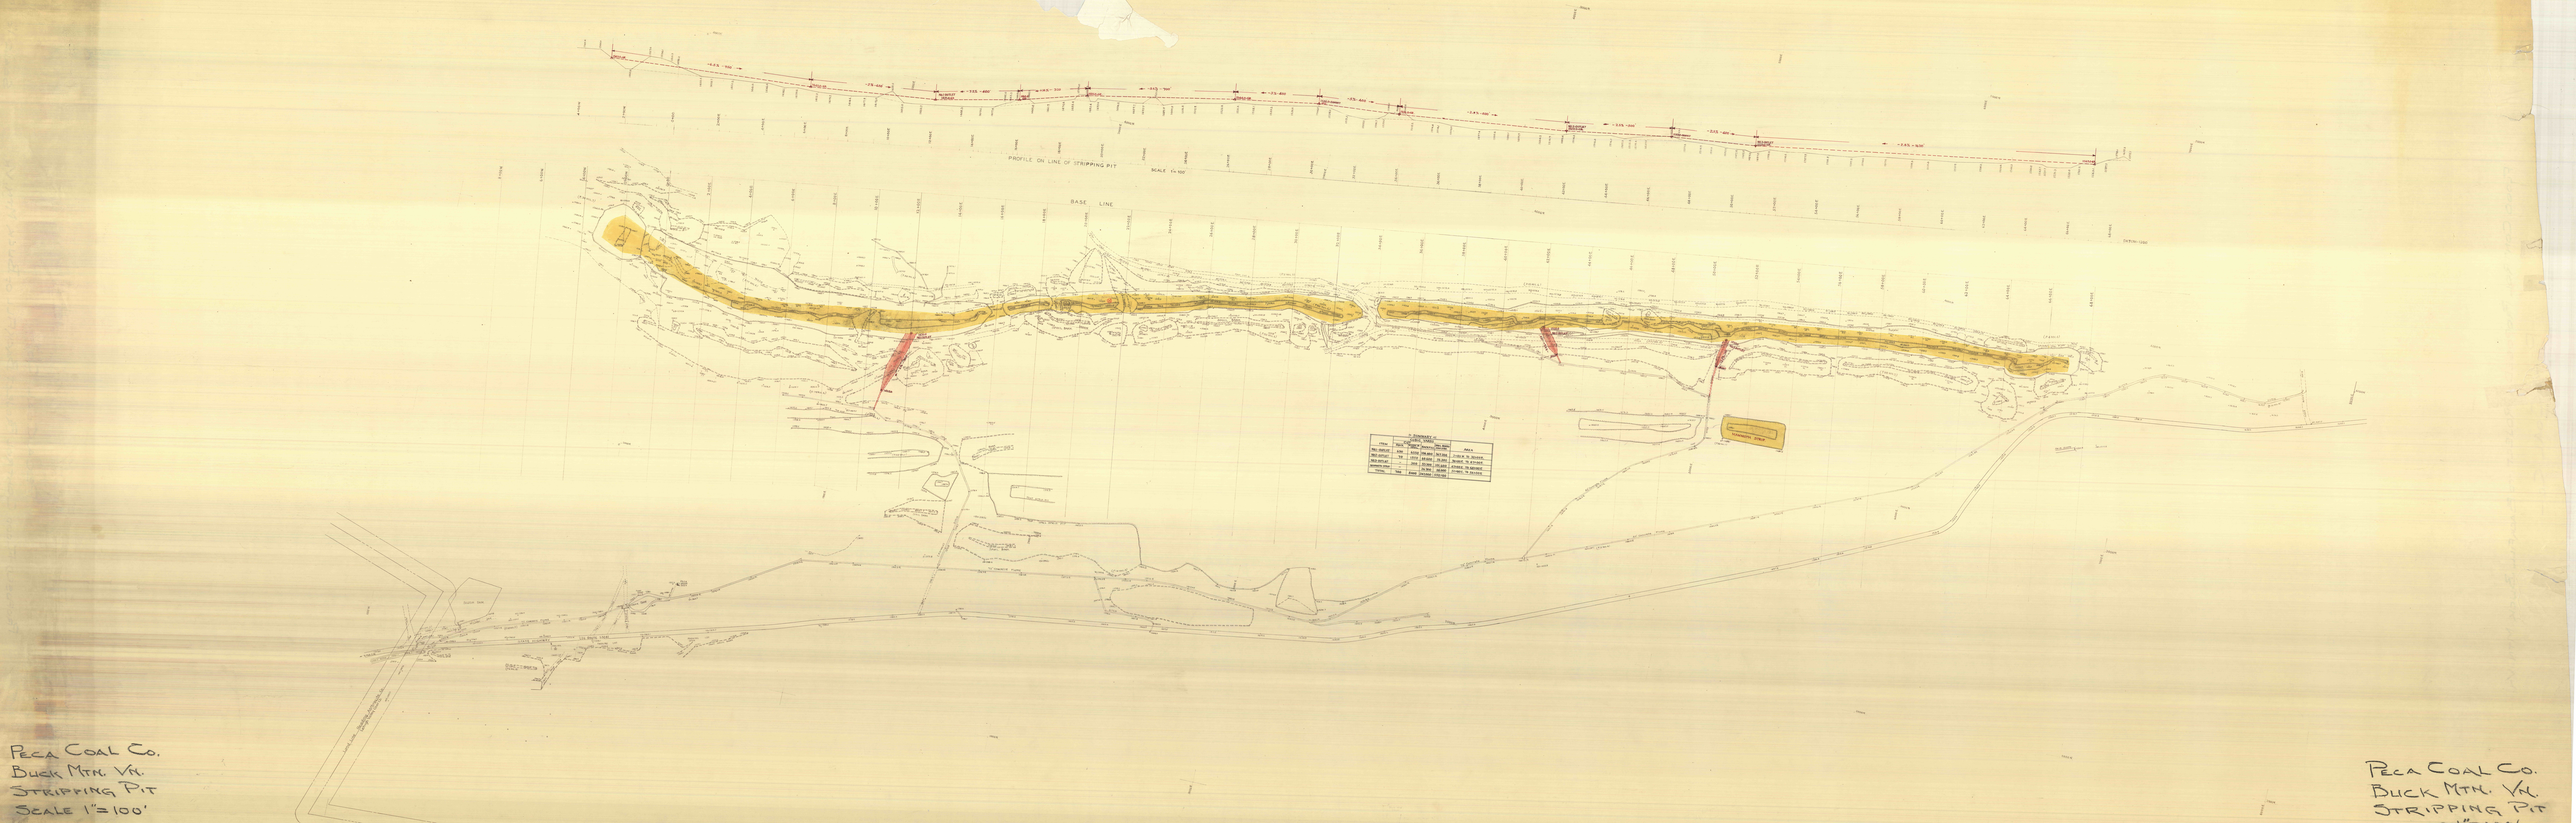

PECA COAL CO.
BUCK MTN. VA.
STRIPPING PIT
SCALE 1"=100'

PECA COAL CO.
BUCK MTN. VA.
STRIPPING PIT