

S.2000

OAK

ST

ST

SIXTH ST

HICKORY

MARKET

ALLEY


BARRIER PILLAR

SEVENTH

WESTERN MIDDLE FLD.
SAYRE COLL'Y. 1-100
MIDDLE SPLIT VN.
BOTTOM
MT. CARMEL TWP.
NORTHUMBERLAND Co. Pa.

EIGHTH ST

REFERENCE:
SEE RELIANCE
COLLY. R-5TAG.
#7-VEN. SKIDMARE VN.

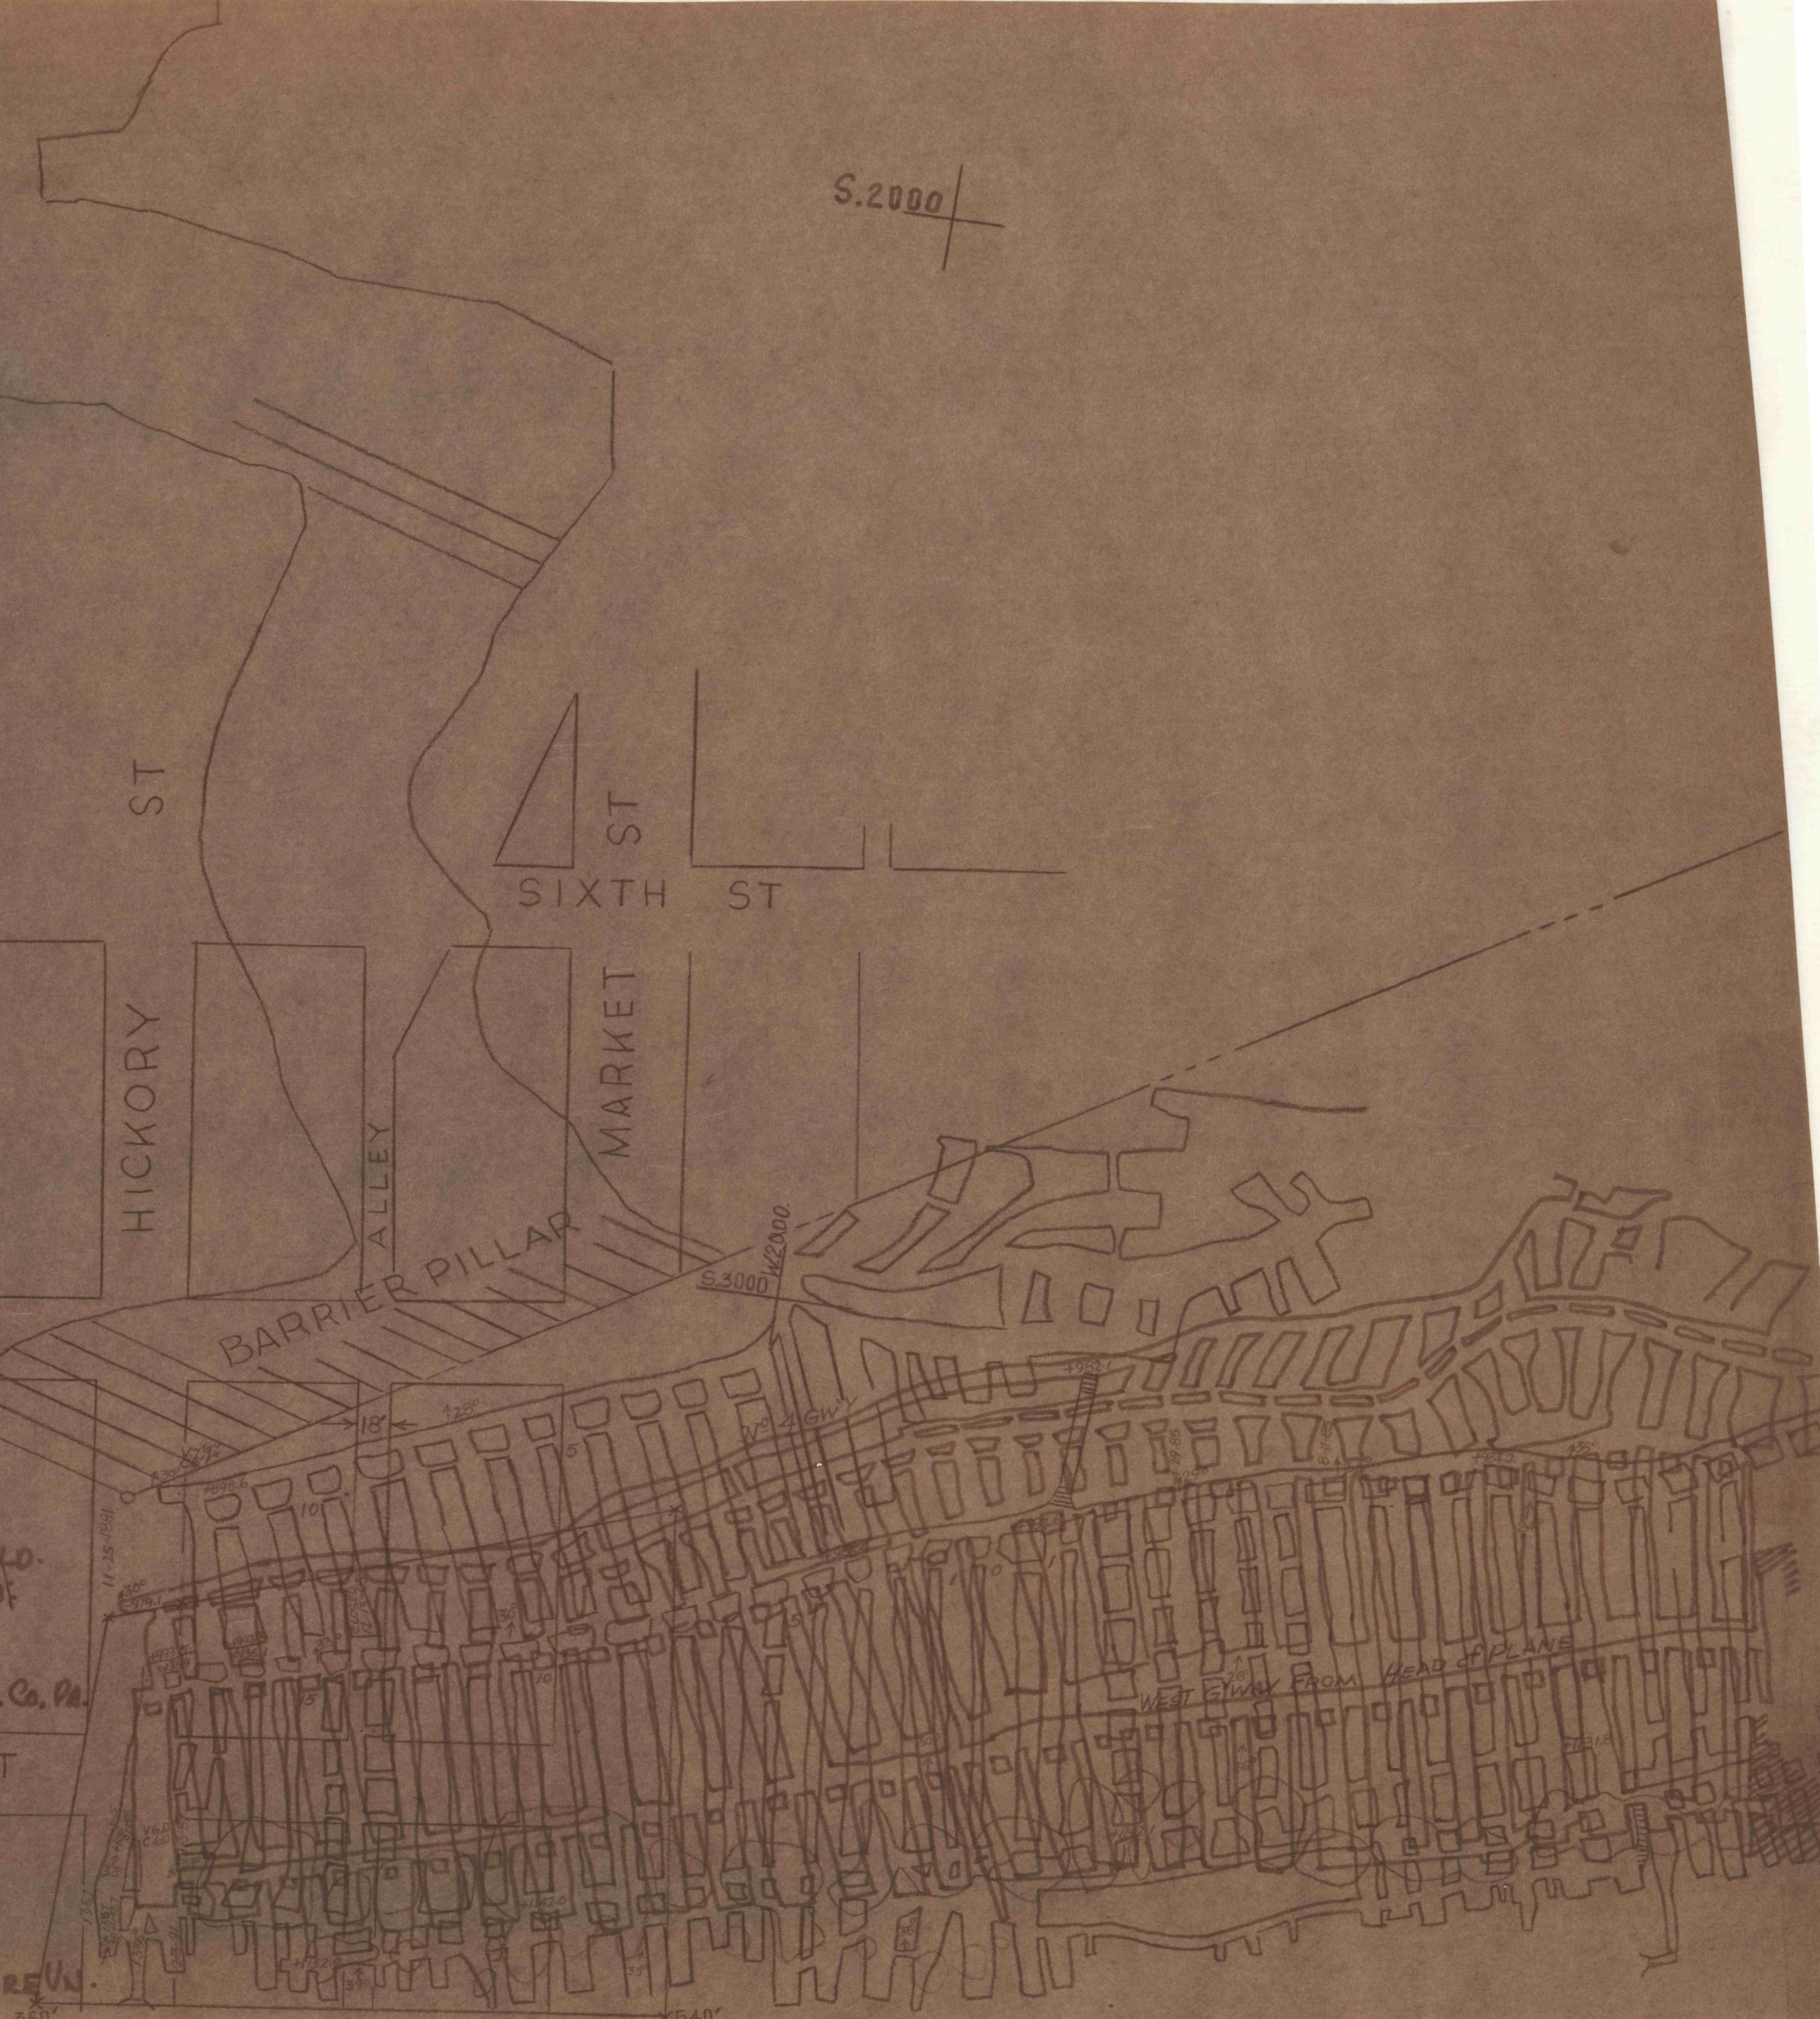

360'

540'