

S.2000

OAK

ST

ST

SIXTH ST

HICKORY

MARKET

ALLEY


BARRIER PILLAR

SEVENTH

EIGHTH ST

WESTERN MIDDLE FLD.
SAYRE COLL'Y. 1:100
MIDDLE SPLIT VN.
BOTTOM
MT. CARMEL TWP.
NORTHUMBERLAND Co. PA.

REFERENCE:
SEE RELIANCE
COLLY. R-5TAG.
#7-VEN. SKIDMORE VN.

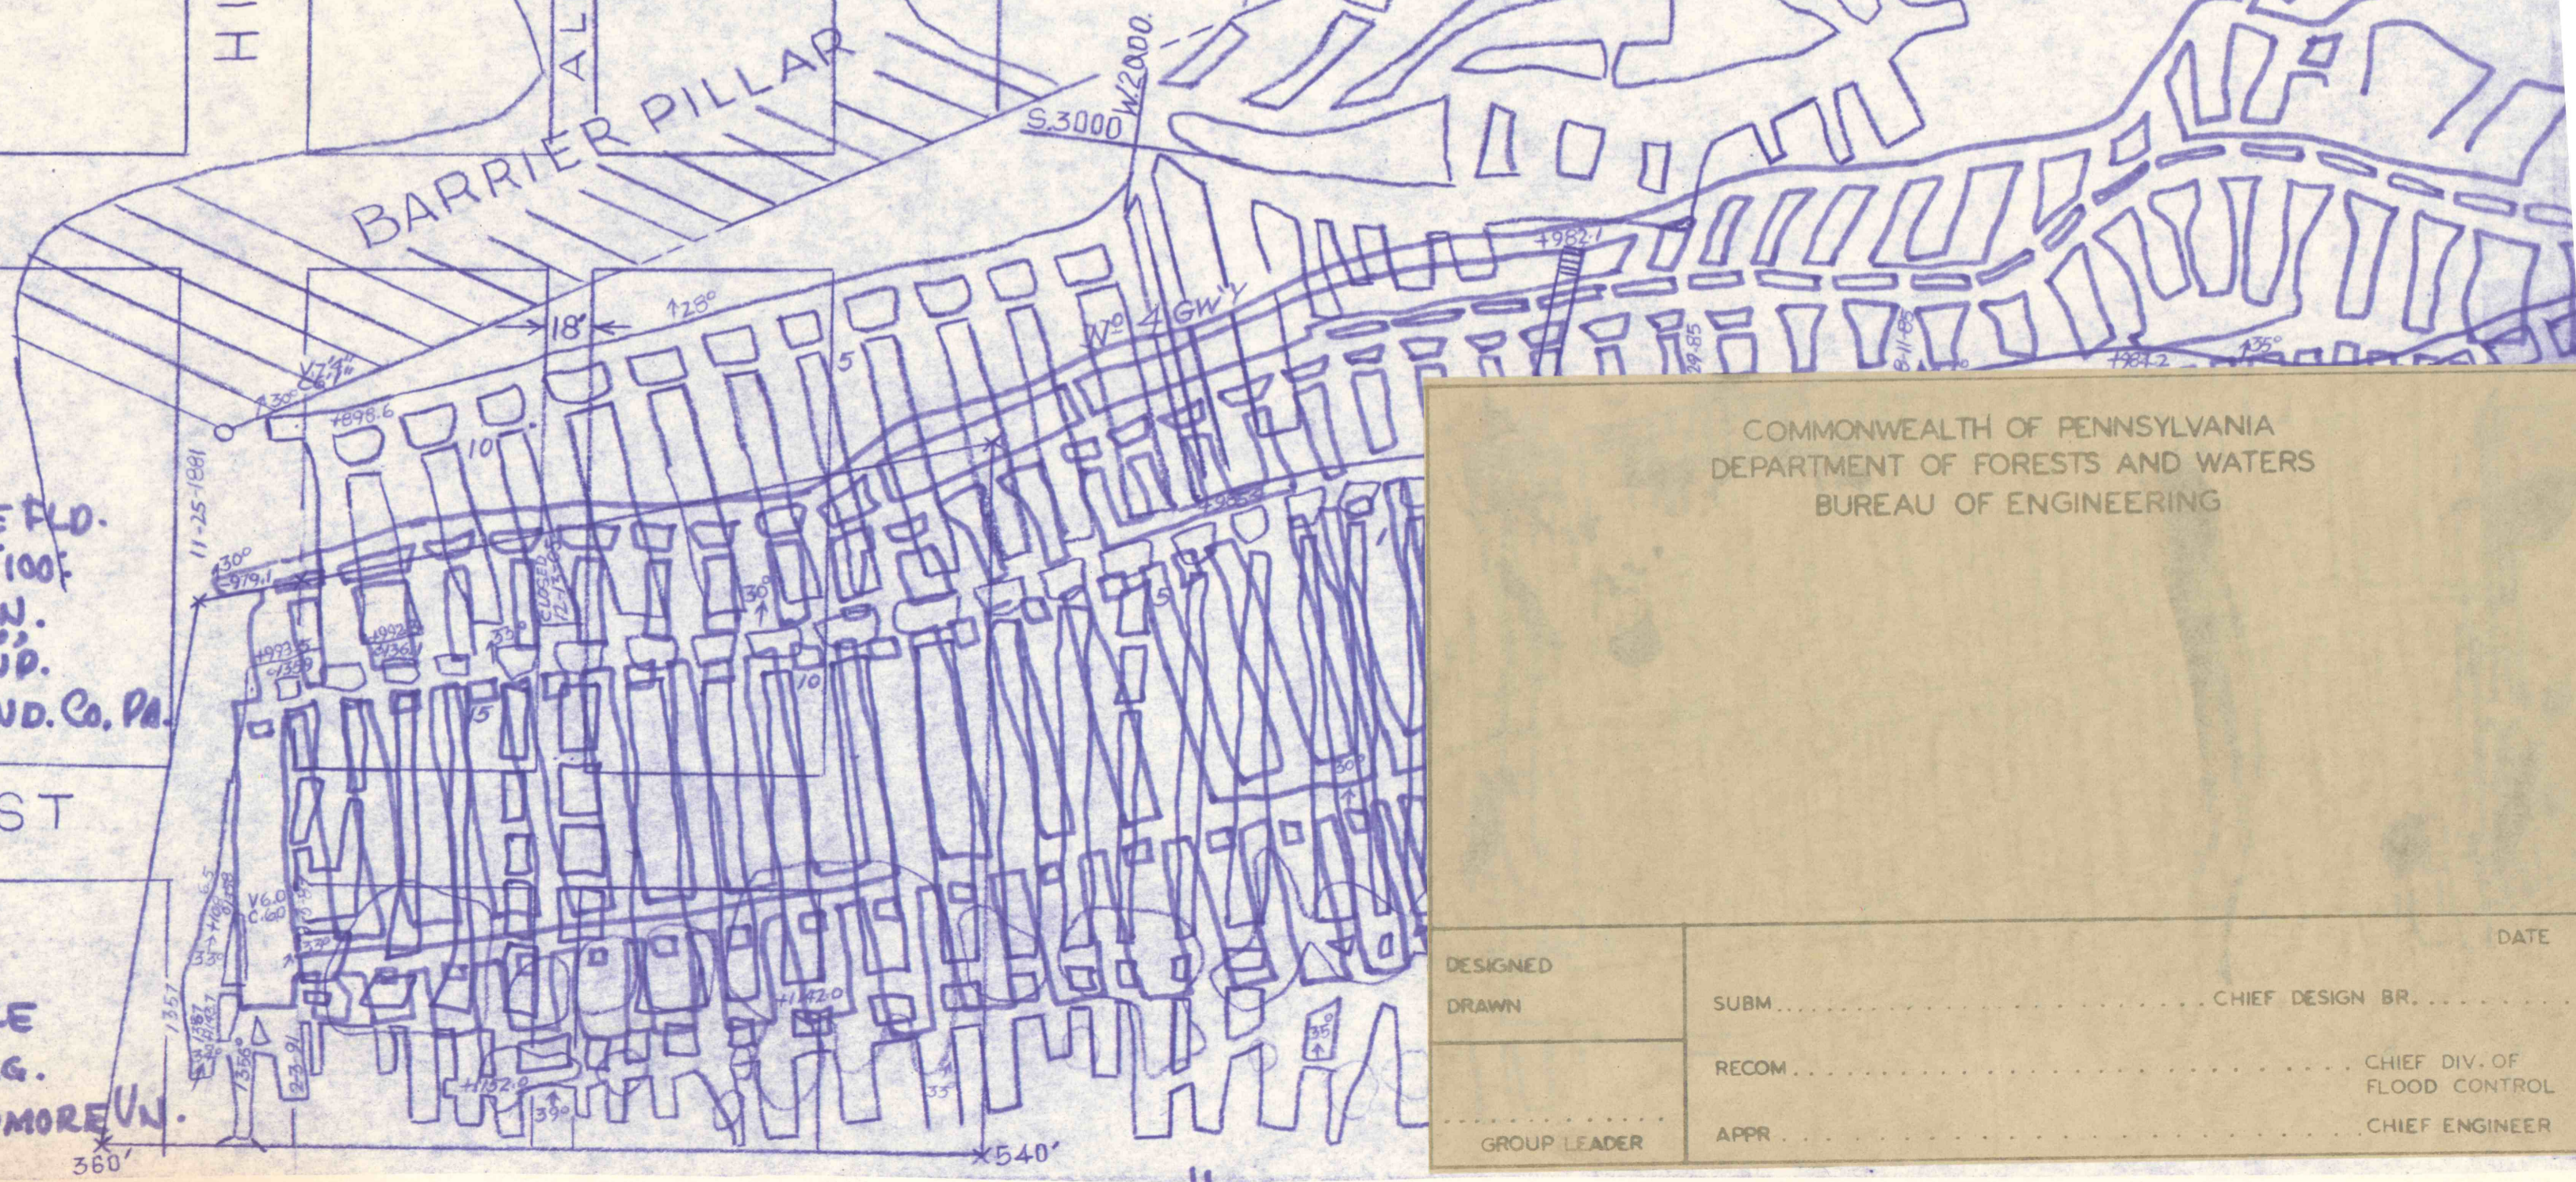

COMMONWEALTH OF PENNSYLVANIA
DEPARTMENT OF FORESTS AND WATERS
BUREAU OF ENGINEERING

DESIGNED	DATE
DRAWN	SUBM..... CHIEF DESIGN BR.....
GROUP LEADER	RECOM..... CHIEF DIV. OF FLOOD CONTROL
	APPR..... CHIEF ENGINEER