


CO.

# HUDSON COAL CO. 'ALGONQUIN'

H.C.Co. 44,000 Volt Steel Tower Line

LEHIGH VALLEY COAL CO.

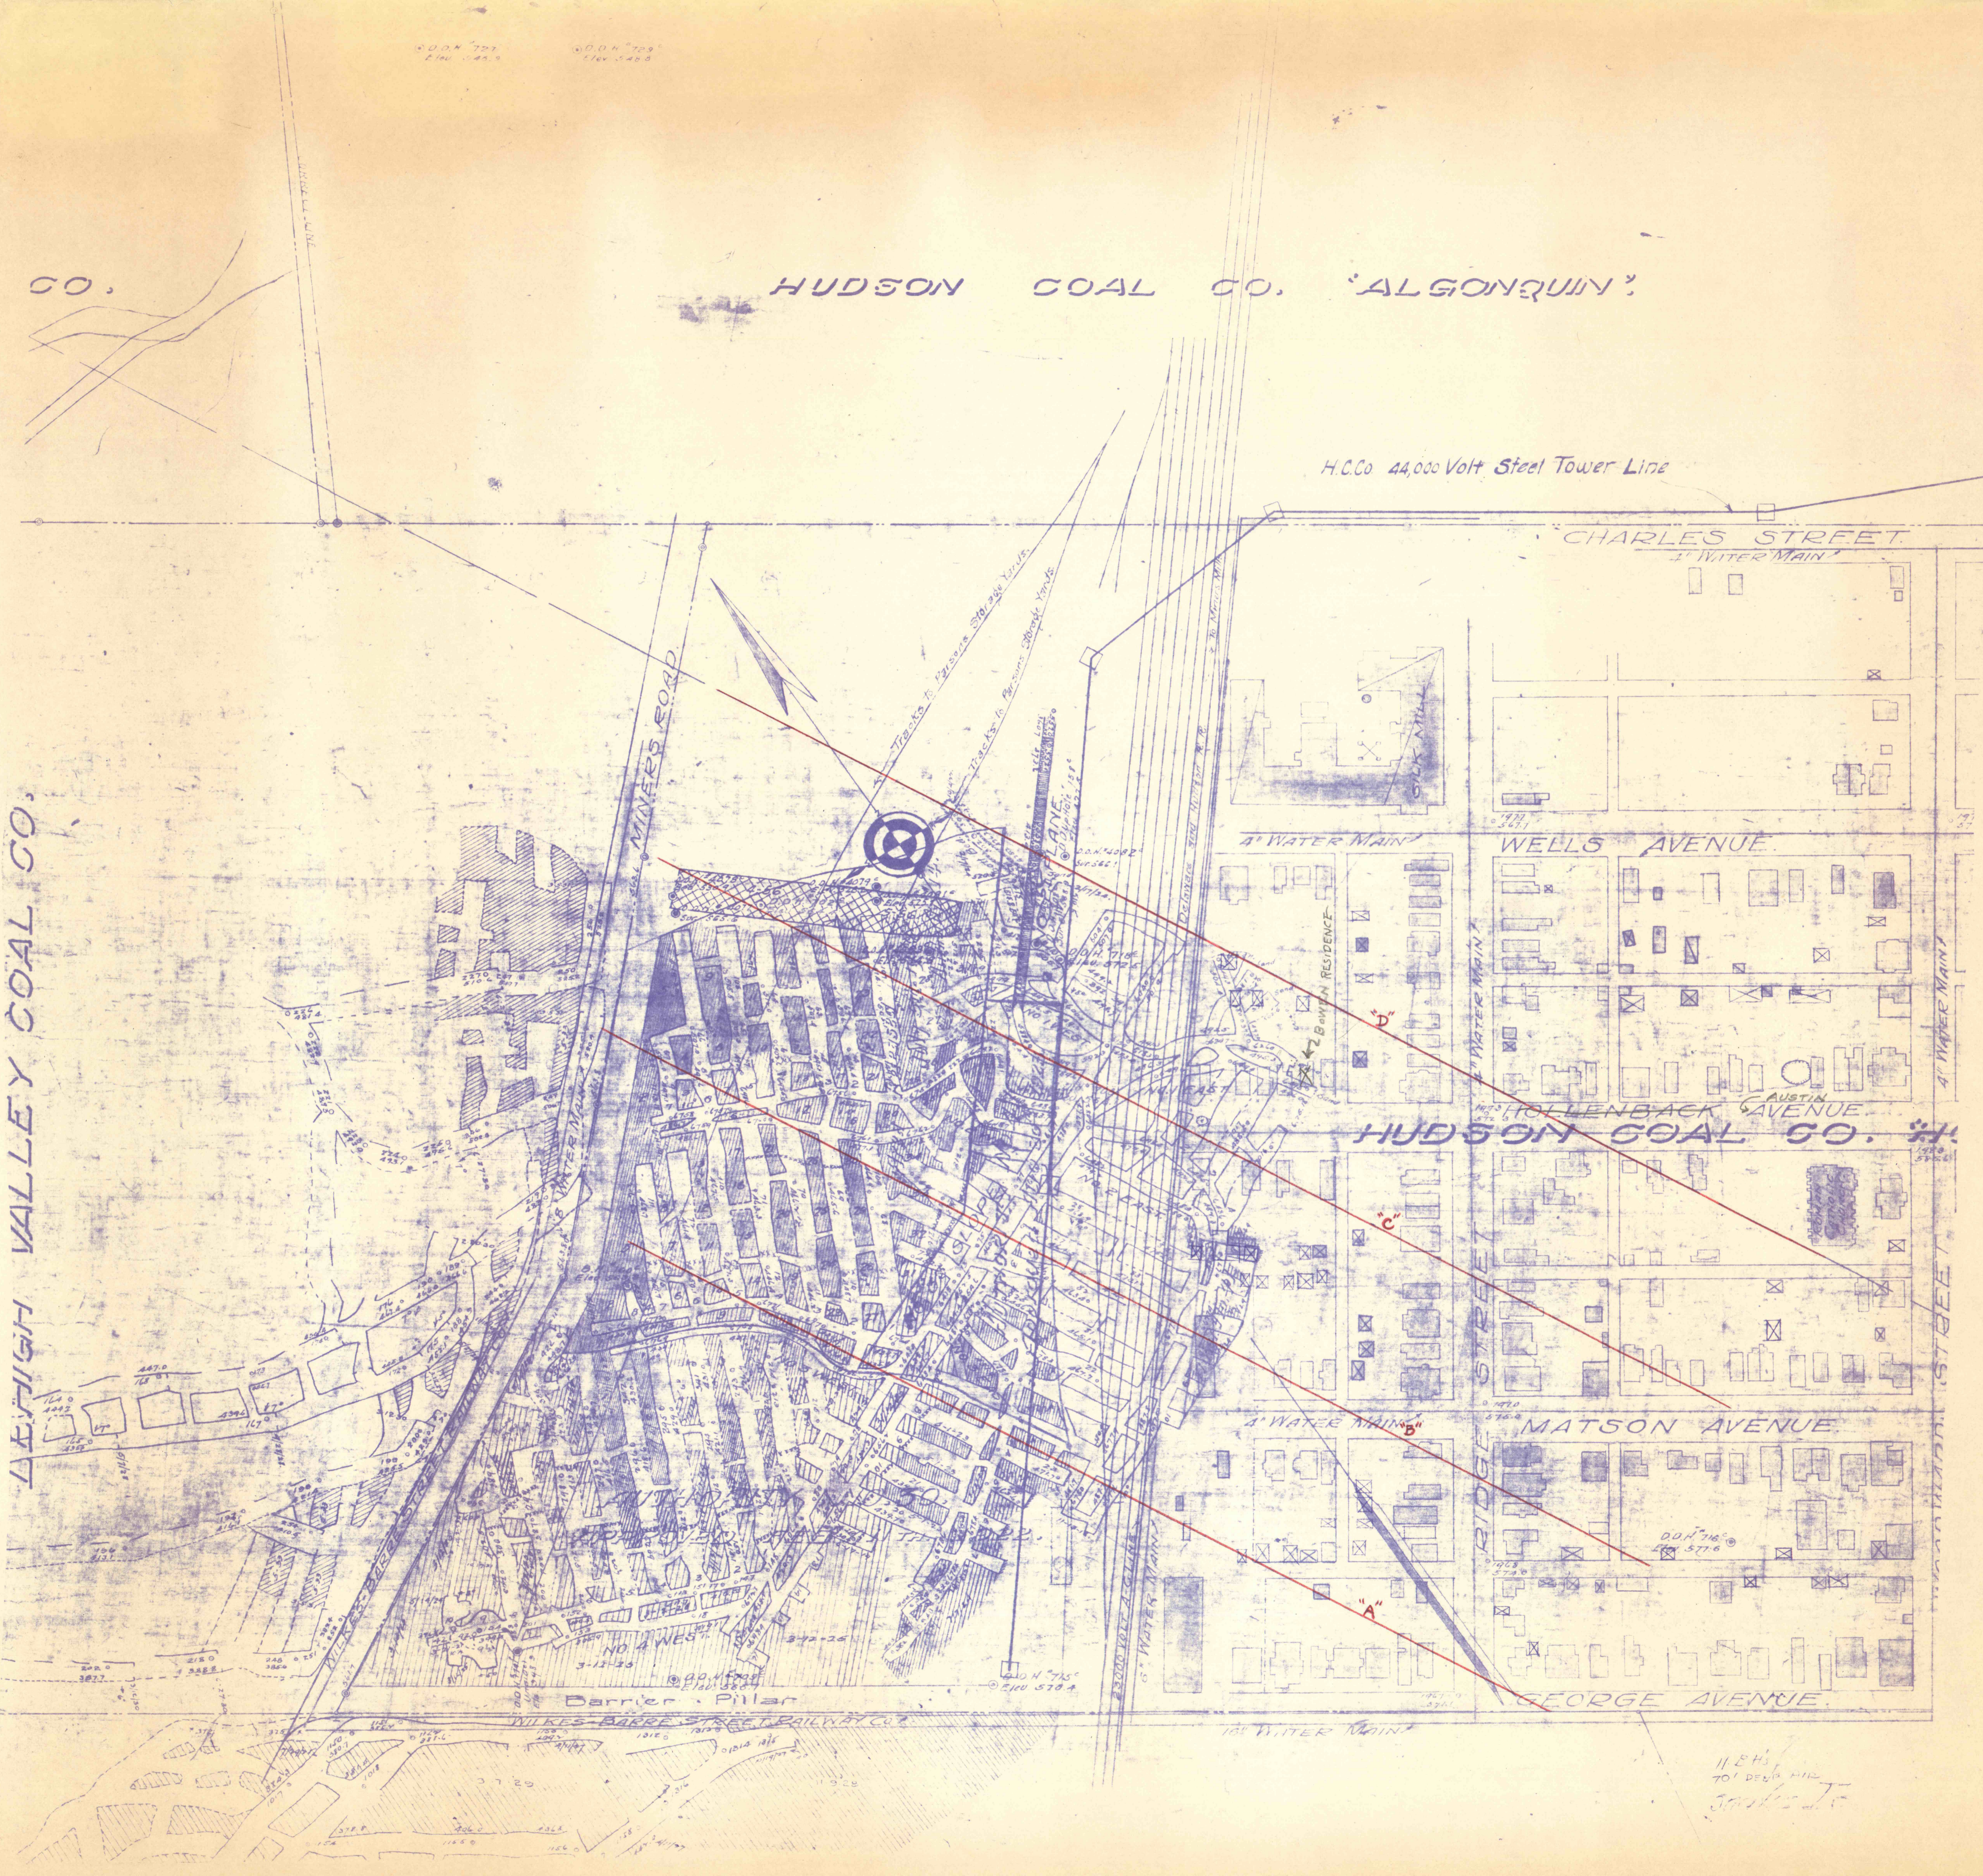

CHARLES STREET  
1" WATER MAIN

4" WATER MAIN

WELLS AVENUE

HUDSON COAL CO.

MATSON AVENUE

GEORGE AVENUE

11.543  
70' DEEP  
