

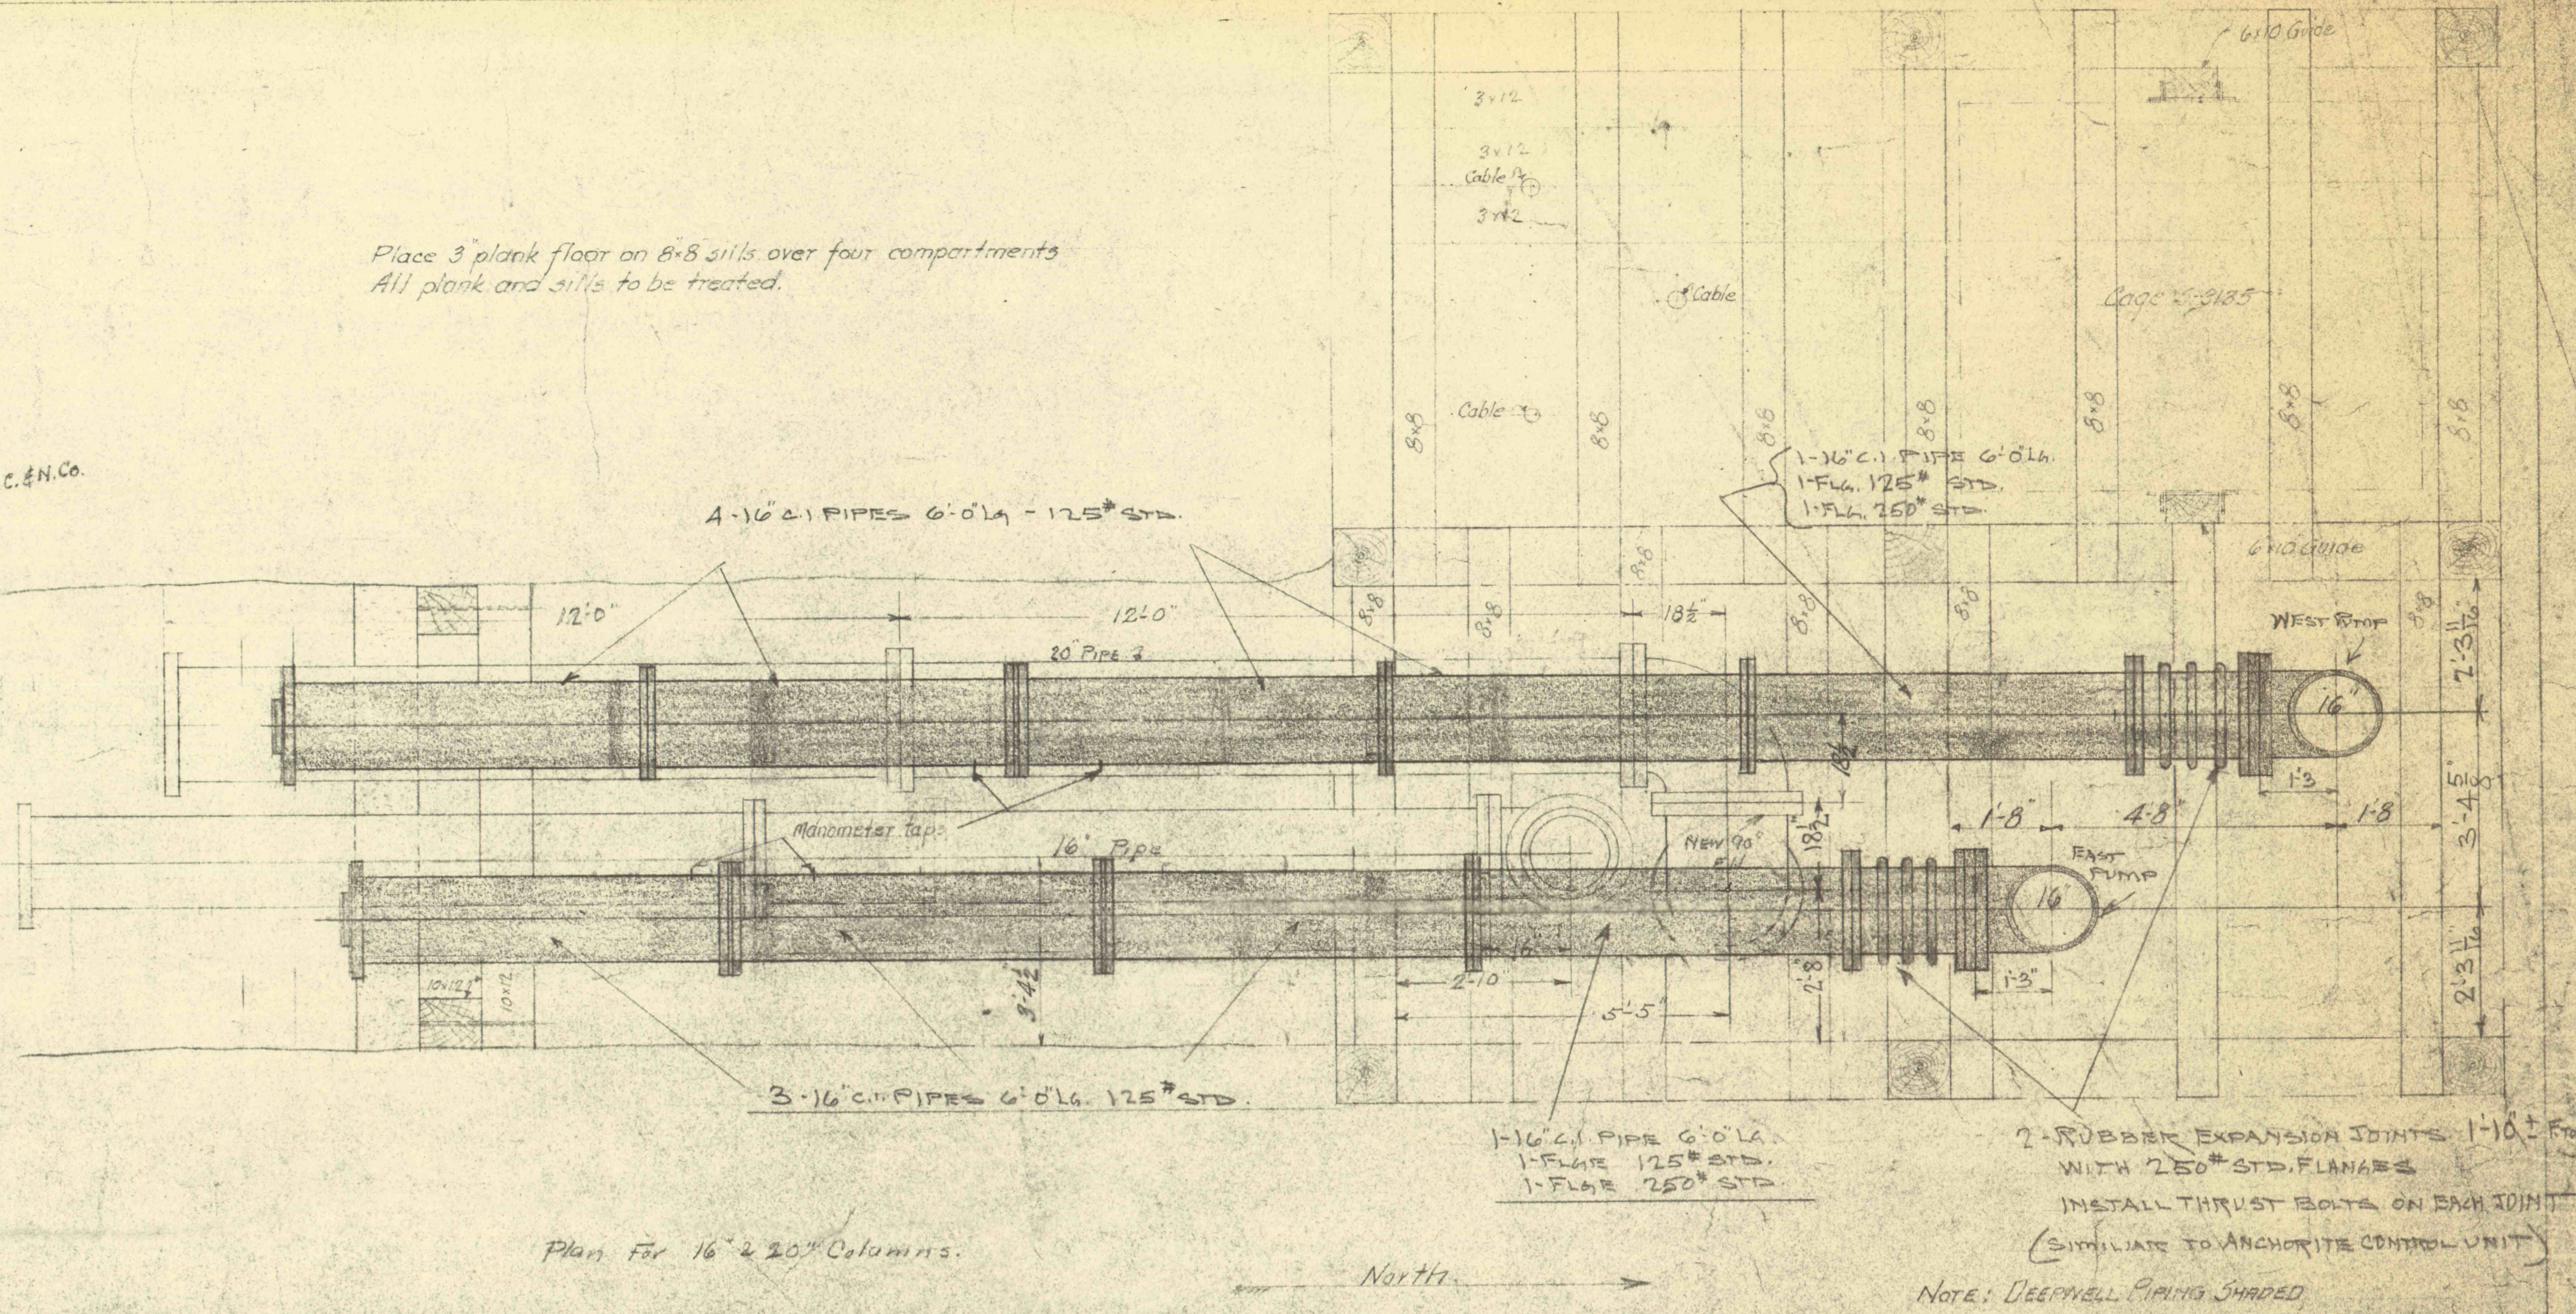


NEW 20" ELL.  
ON HAND - L.C. & N. CO.

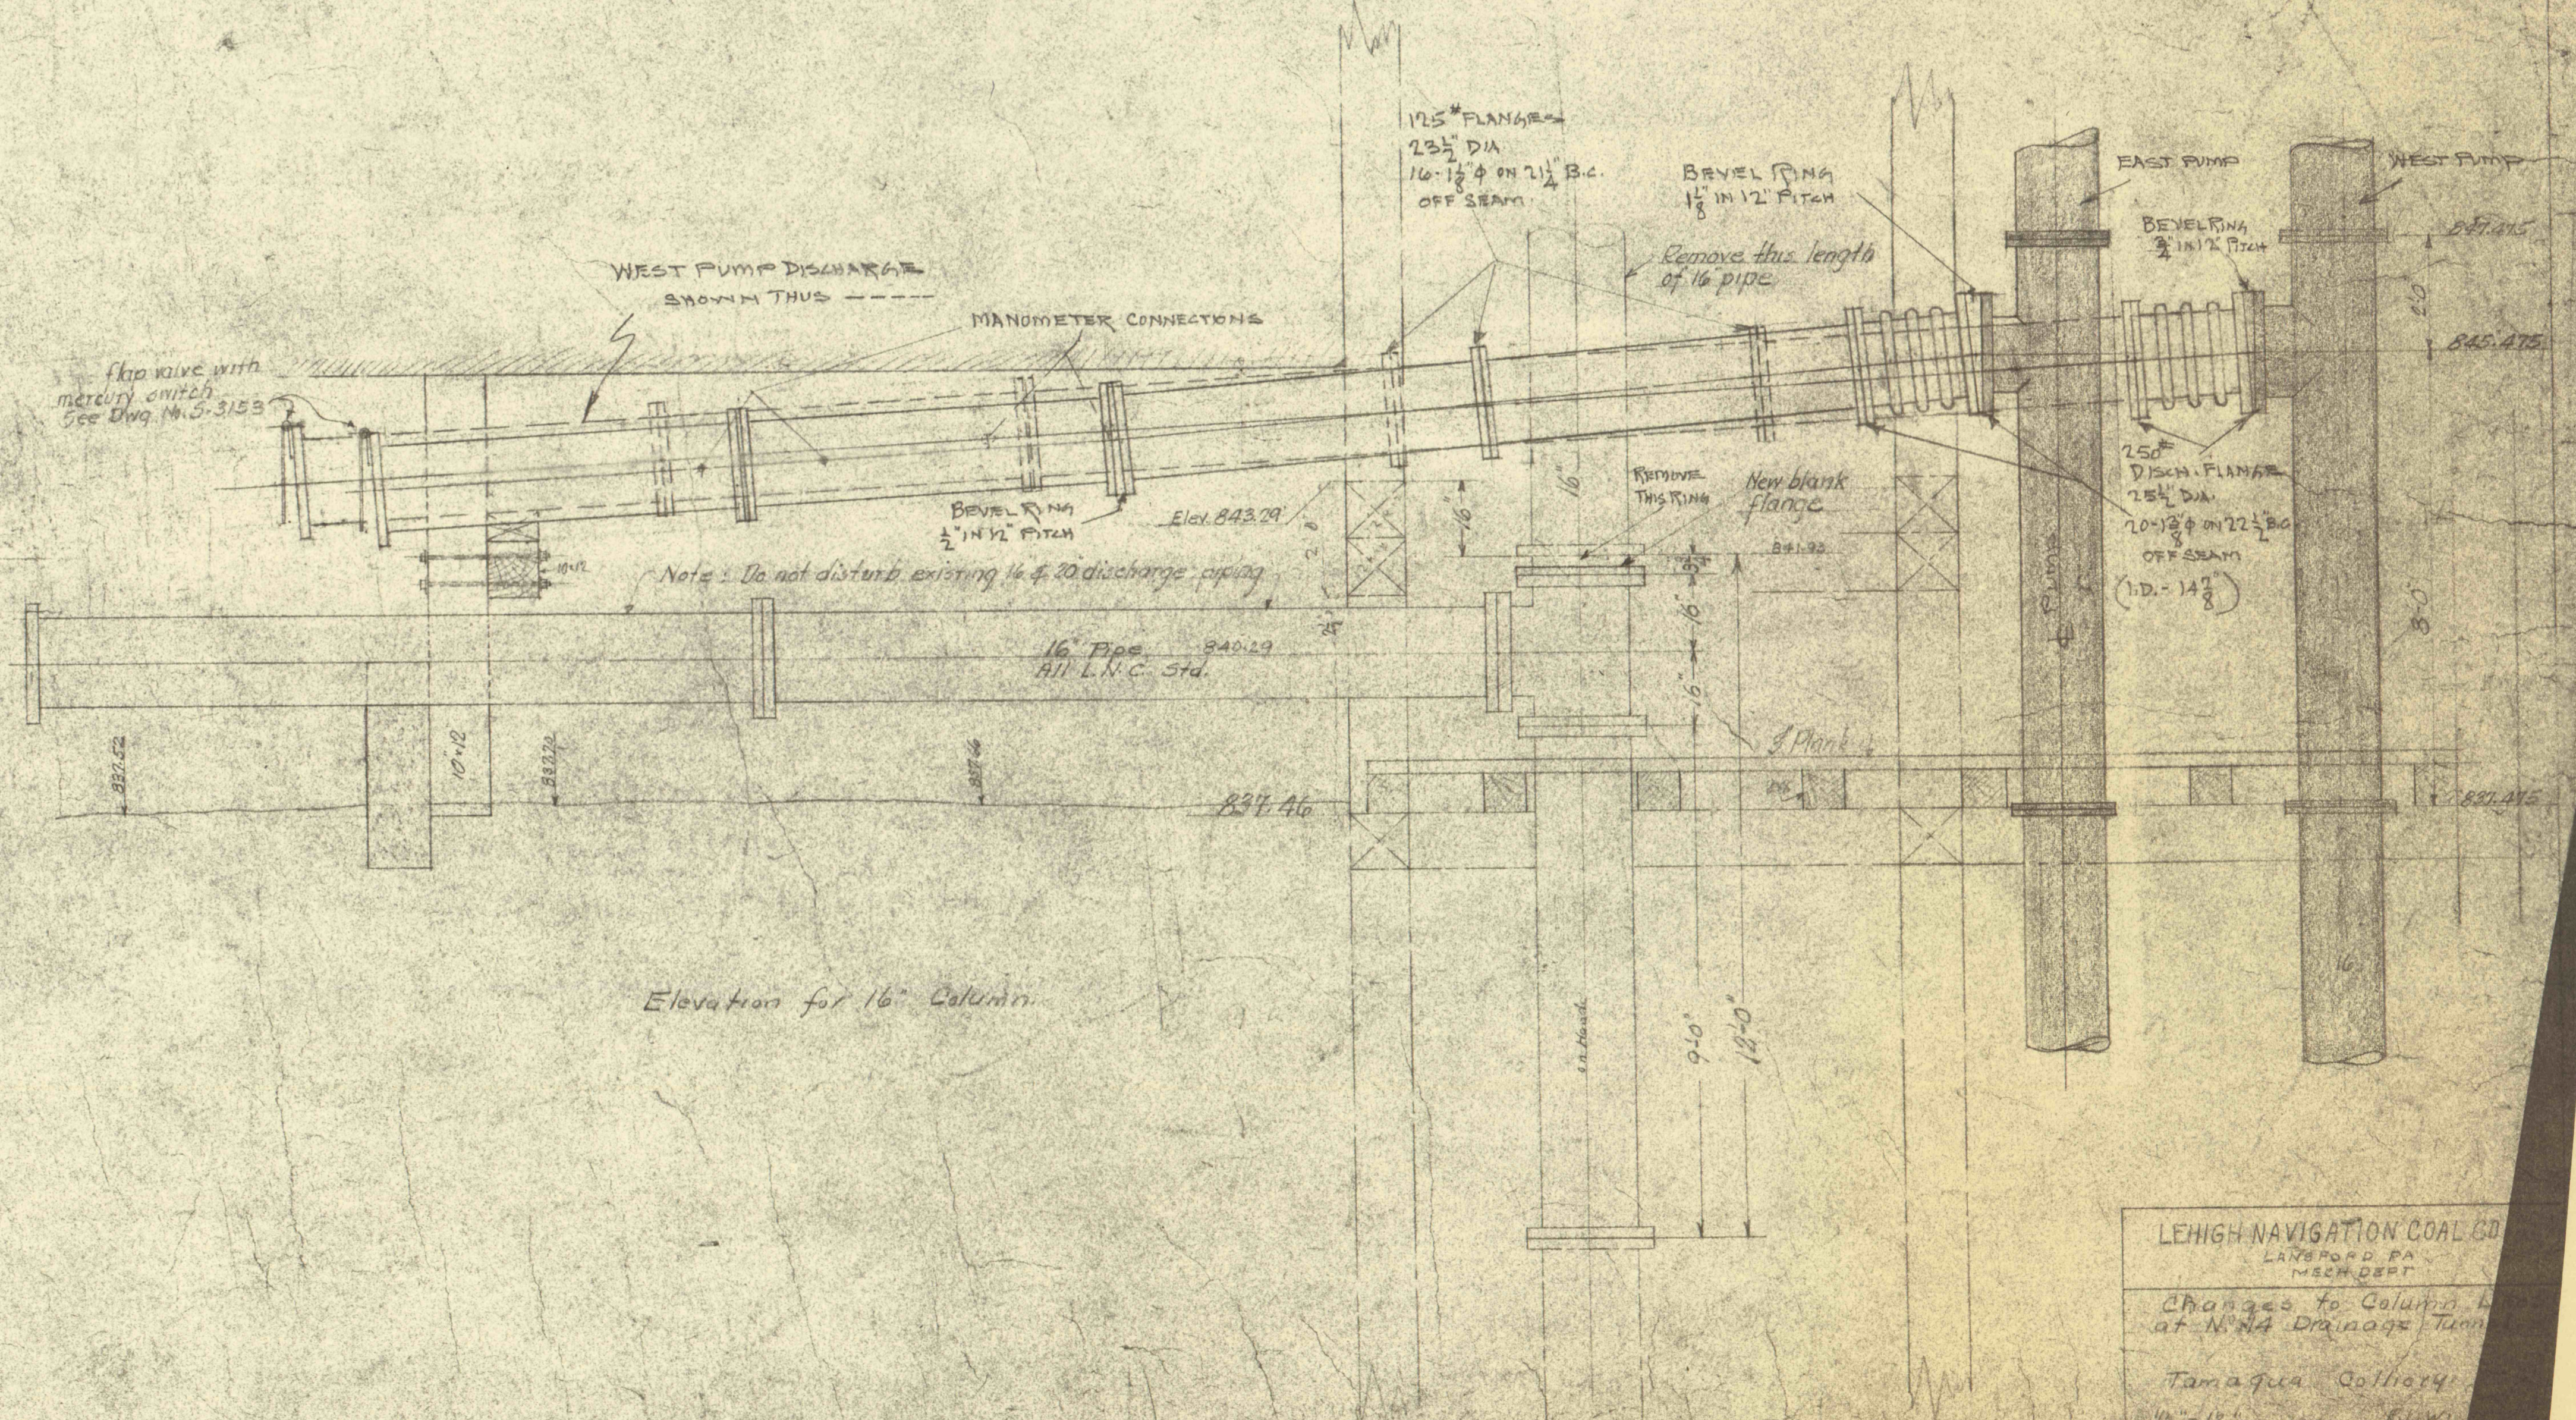

Plan for 16" & 20" Columns.

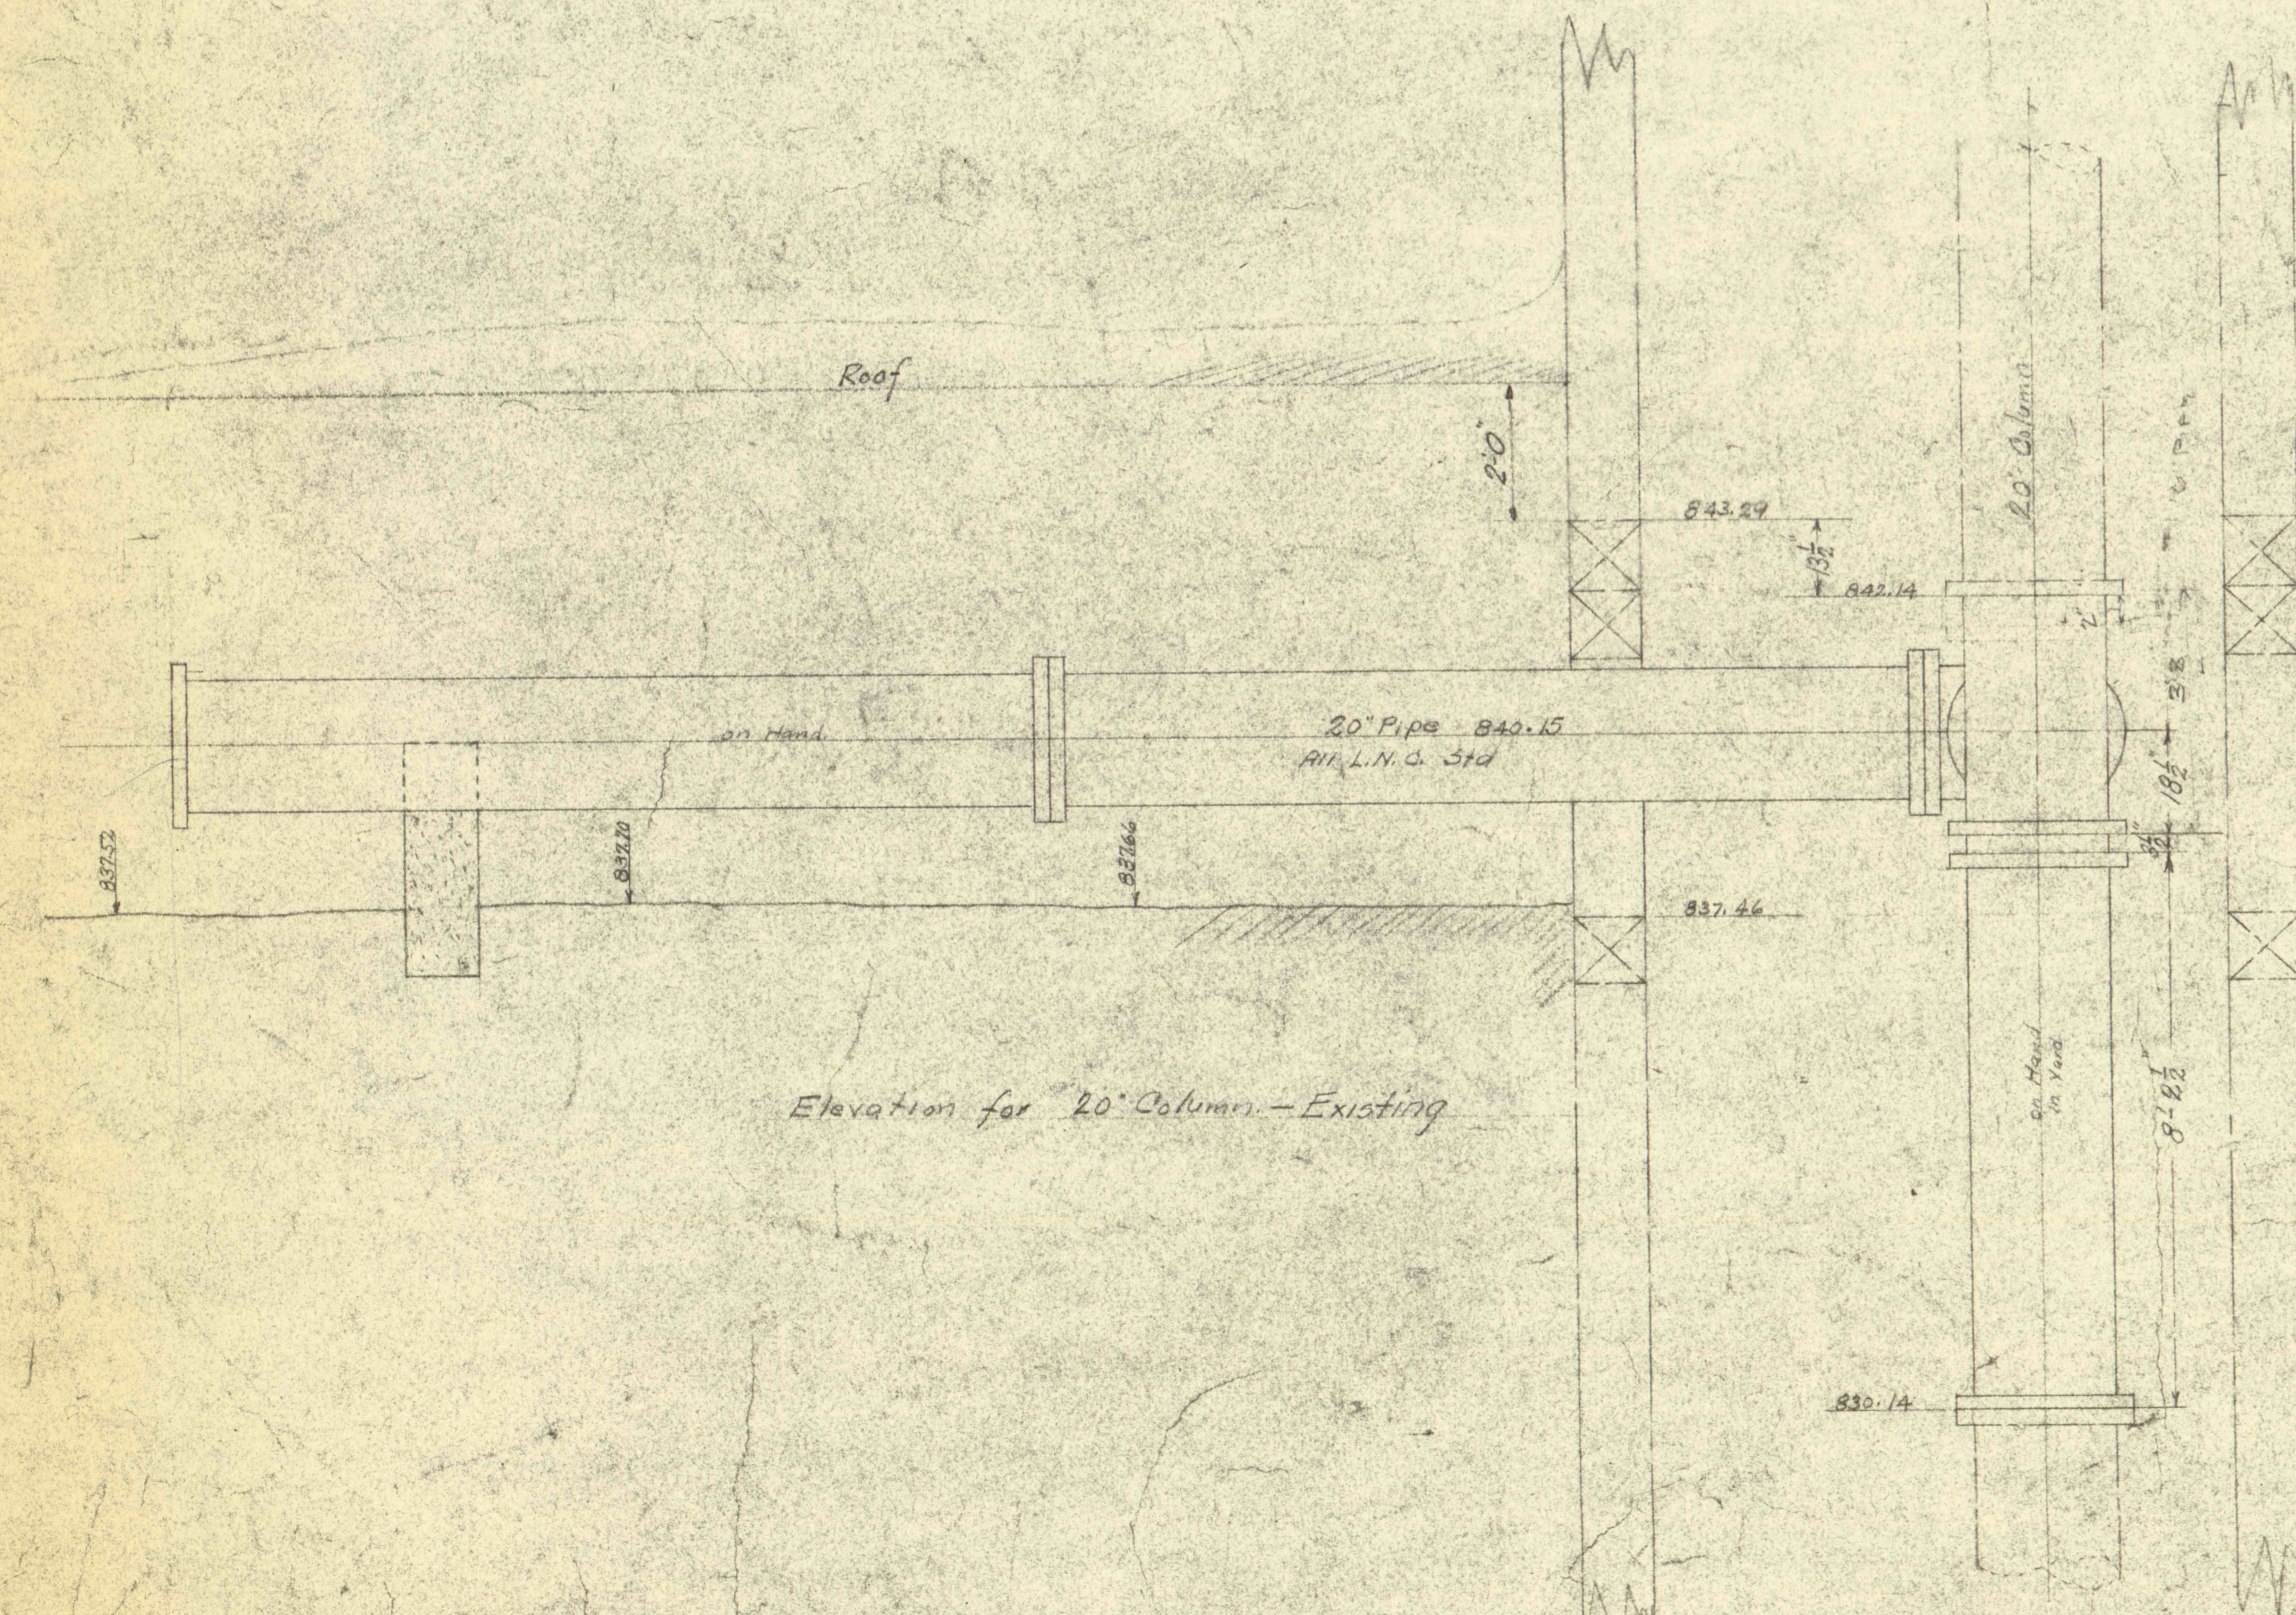

Elevation for 16" Column

LEHIGH NAVIGATION COAL CO  
LANEPORT PA  
MACH DEPT  
Changes to Column 16  
at N.W. Drainage Tunnel  
Tamaqua Colliery  
11-12-41  
REV 2-5-55  
REV 5-7-58  
REV 10-15-58  
REV 6-8-59