


Scale 100' = 1"

Note:  
This section is according to  
in Annual Report for 1897.

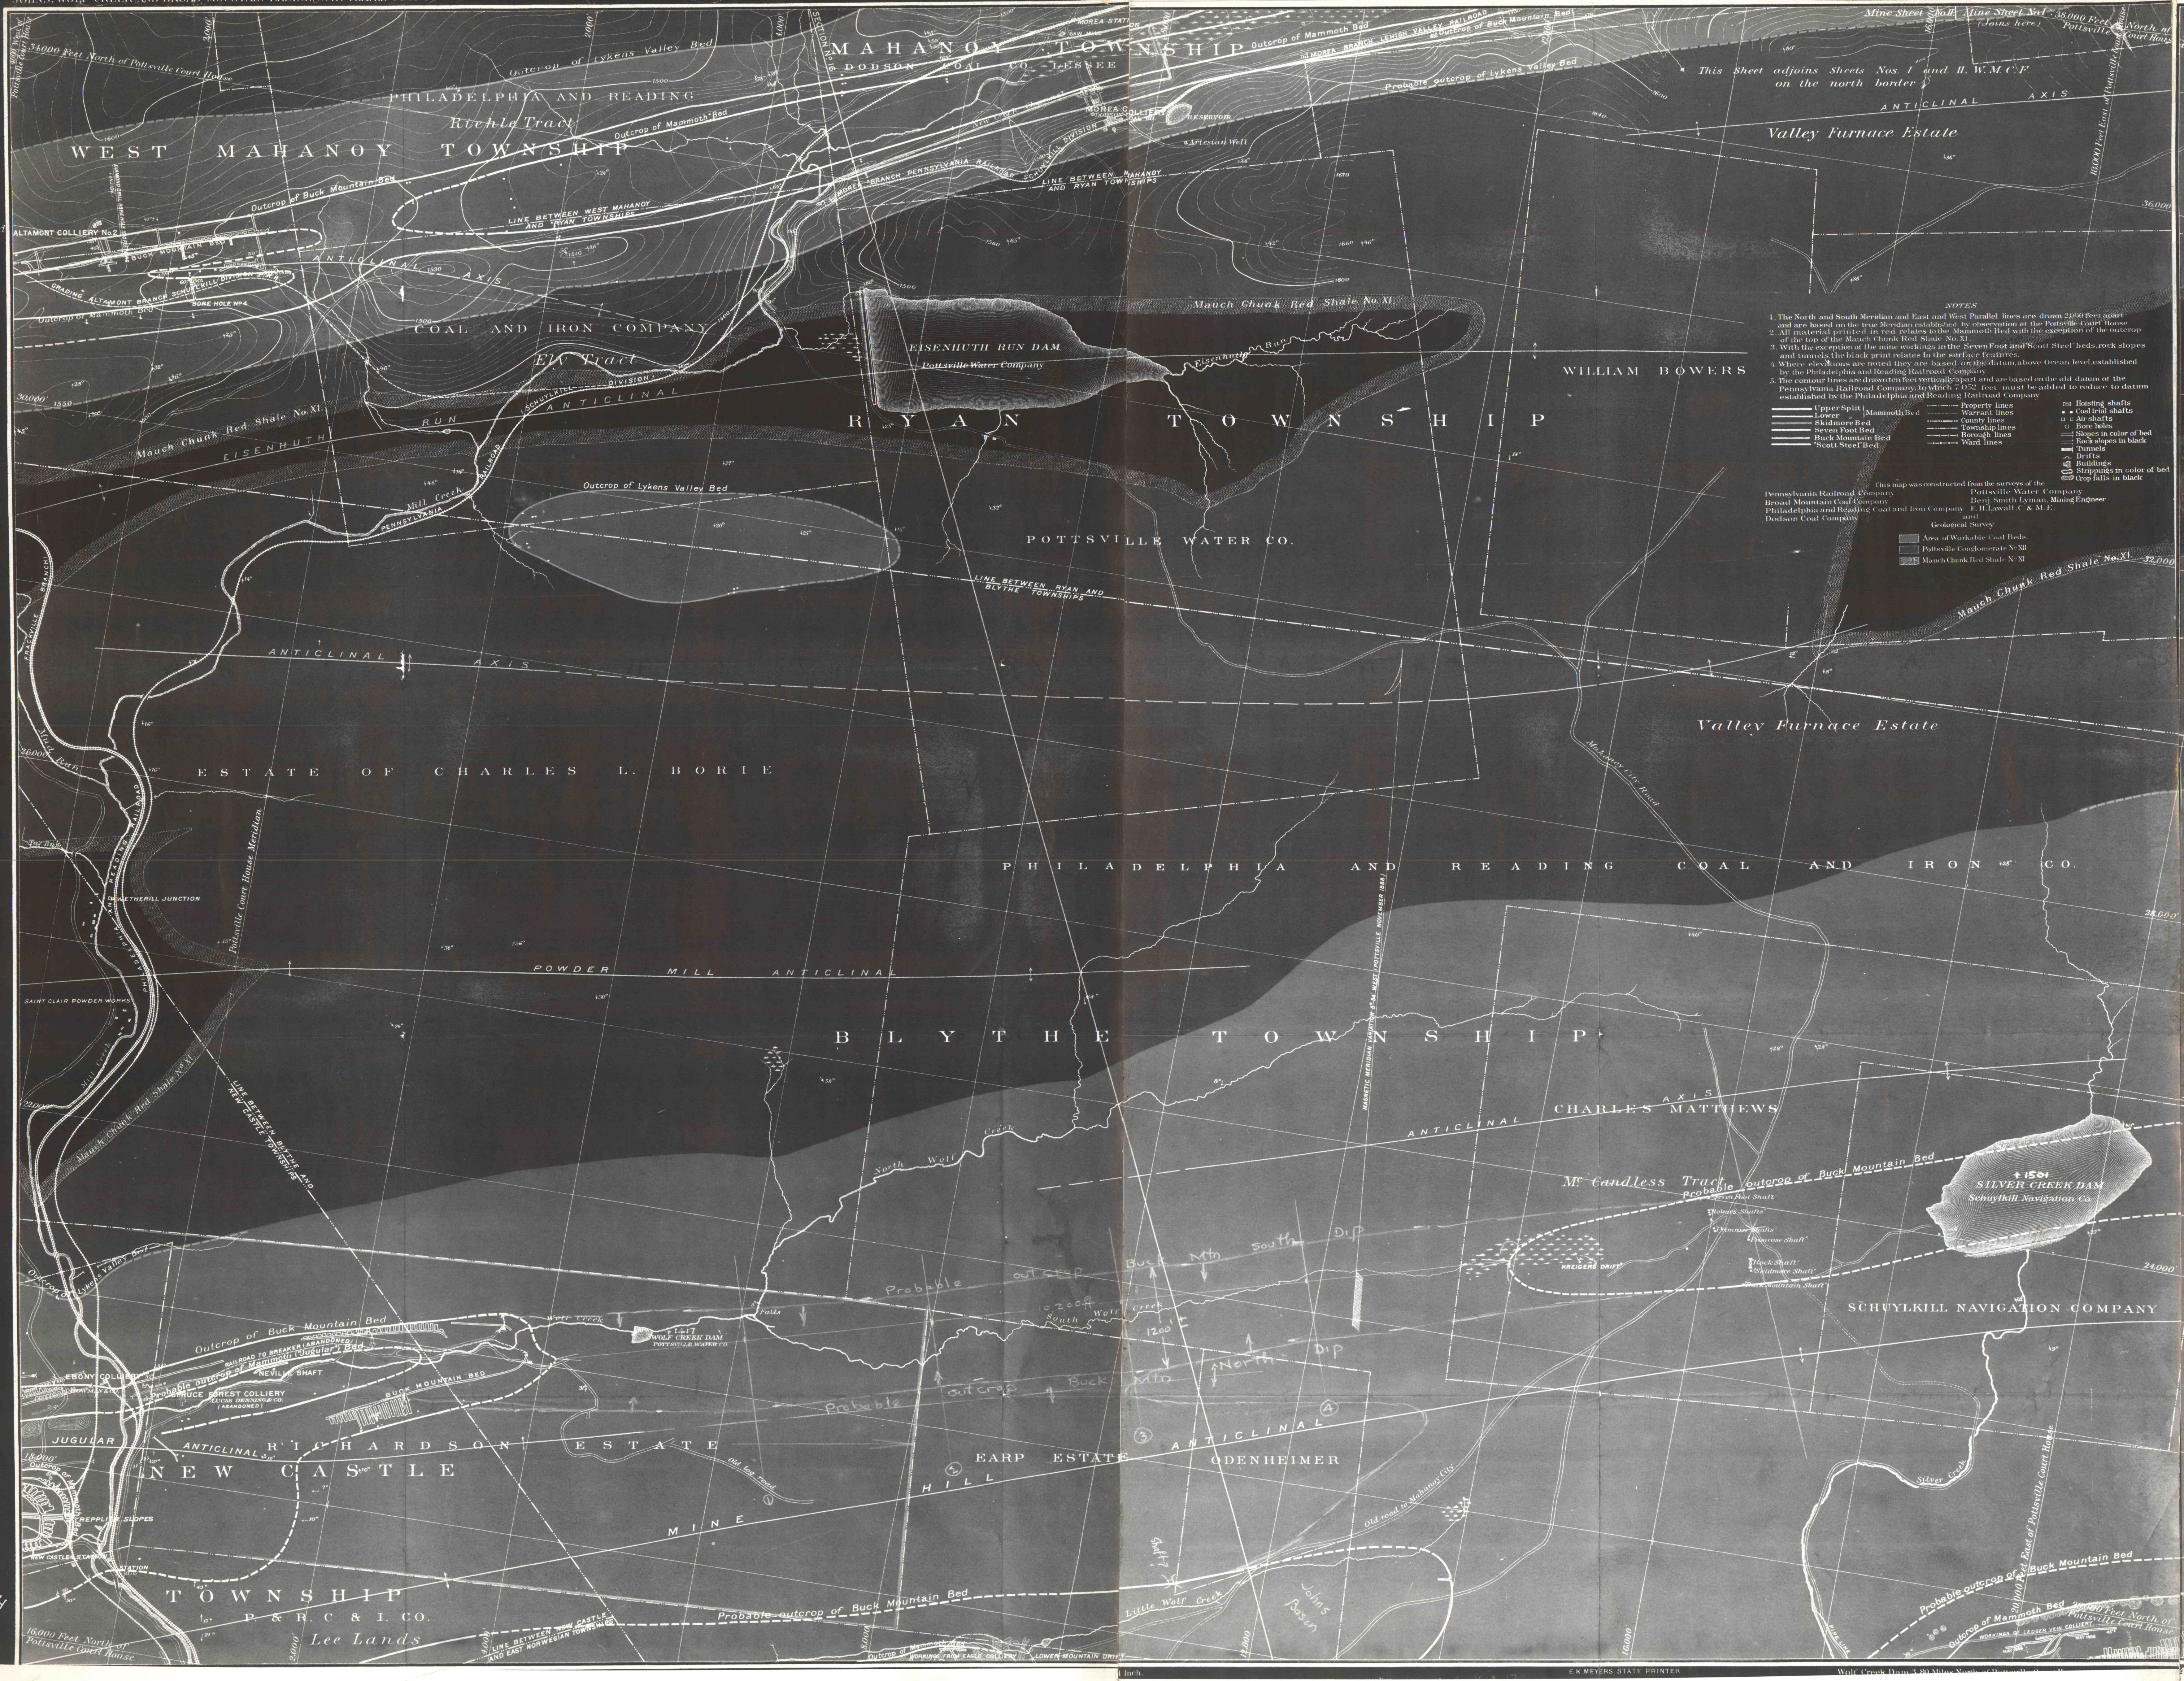


NOTES

4. Where elevations are noted they are based on the datum above Ocean level established by the Philadelphia and Reading Coal and Iron Company.


Geological Survey  
Pottsville Water Company

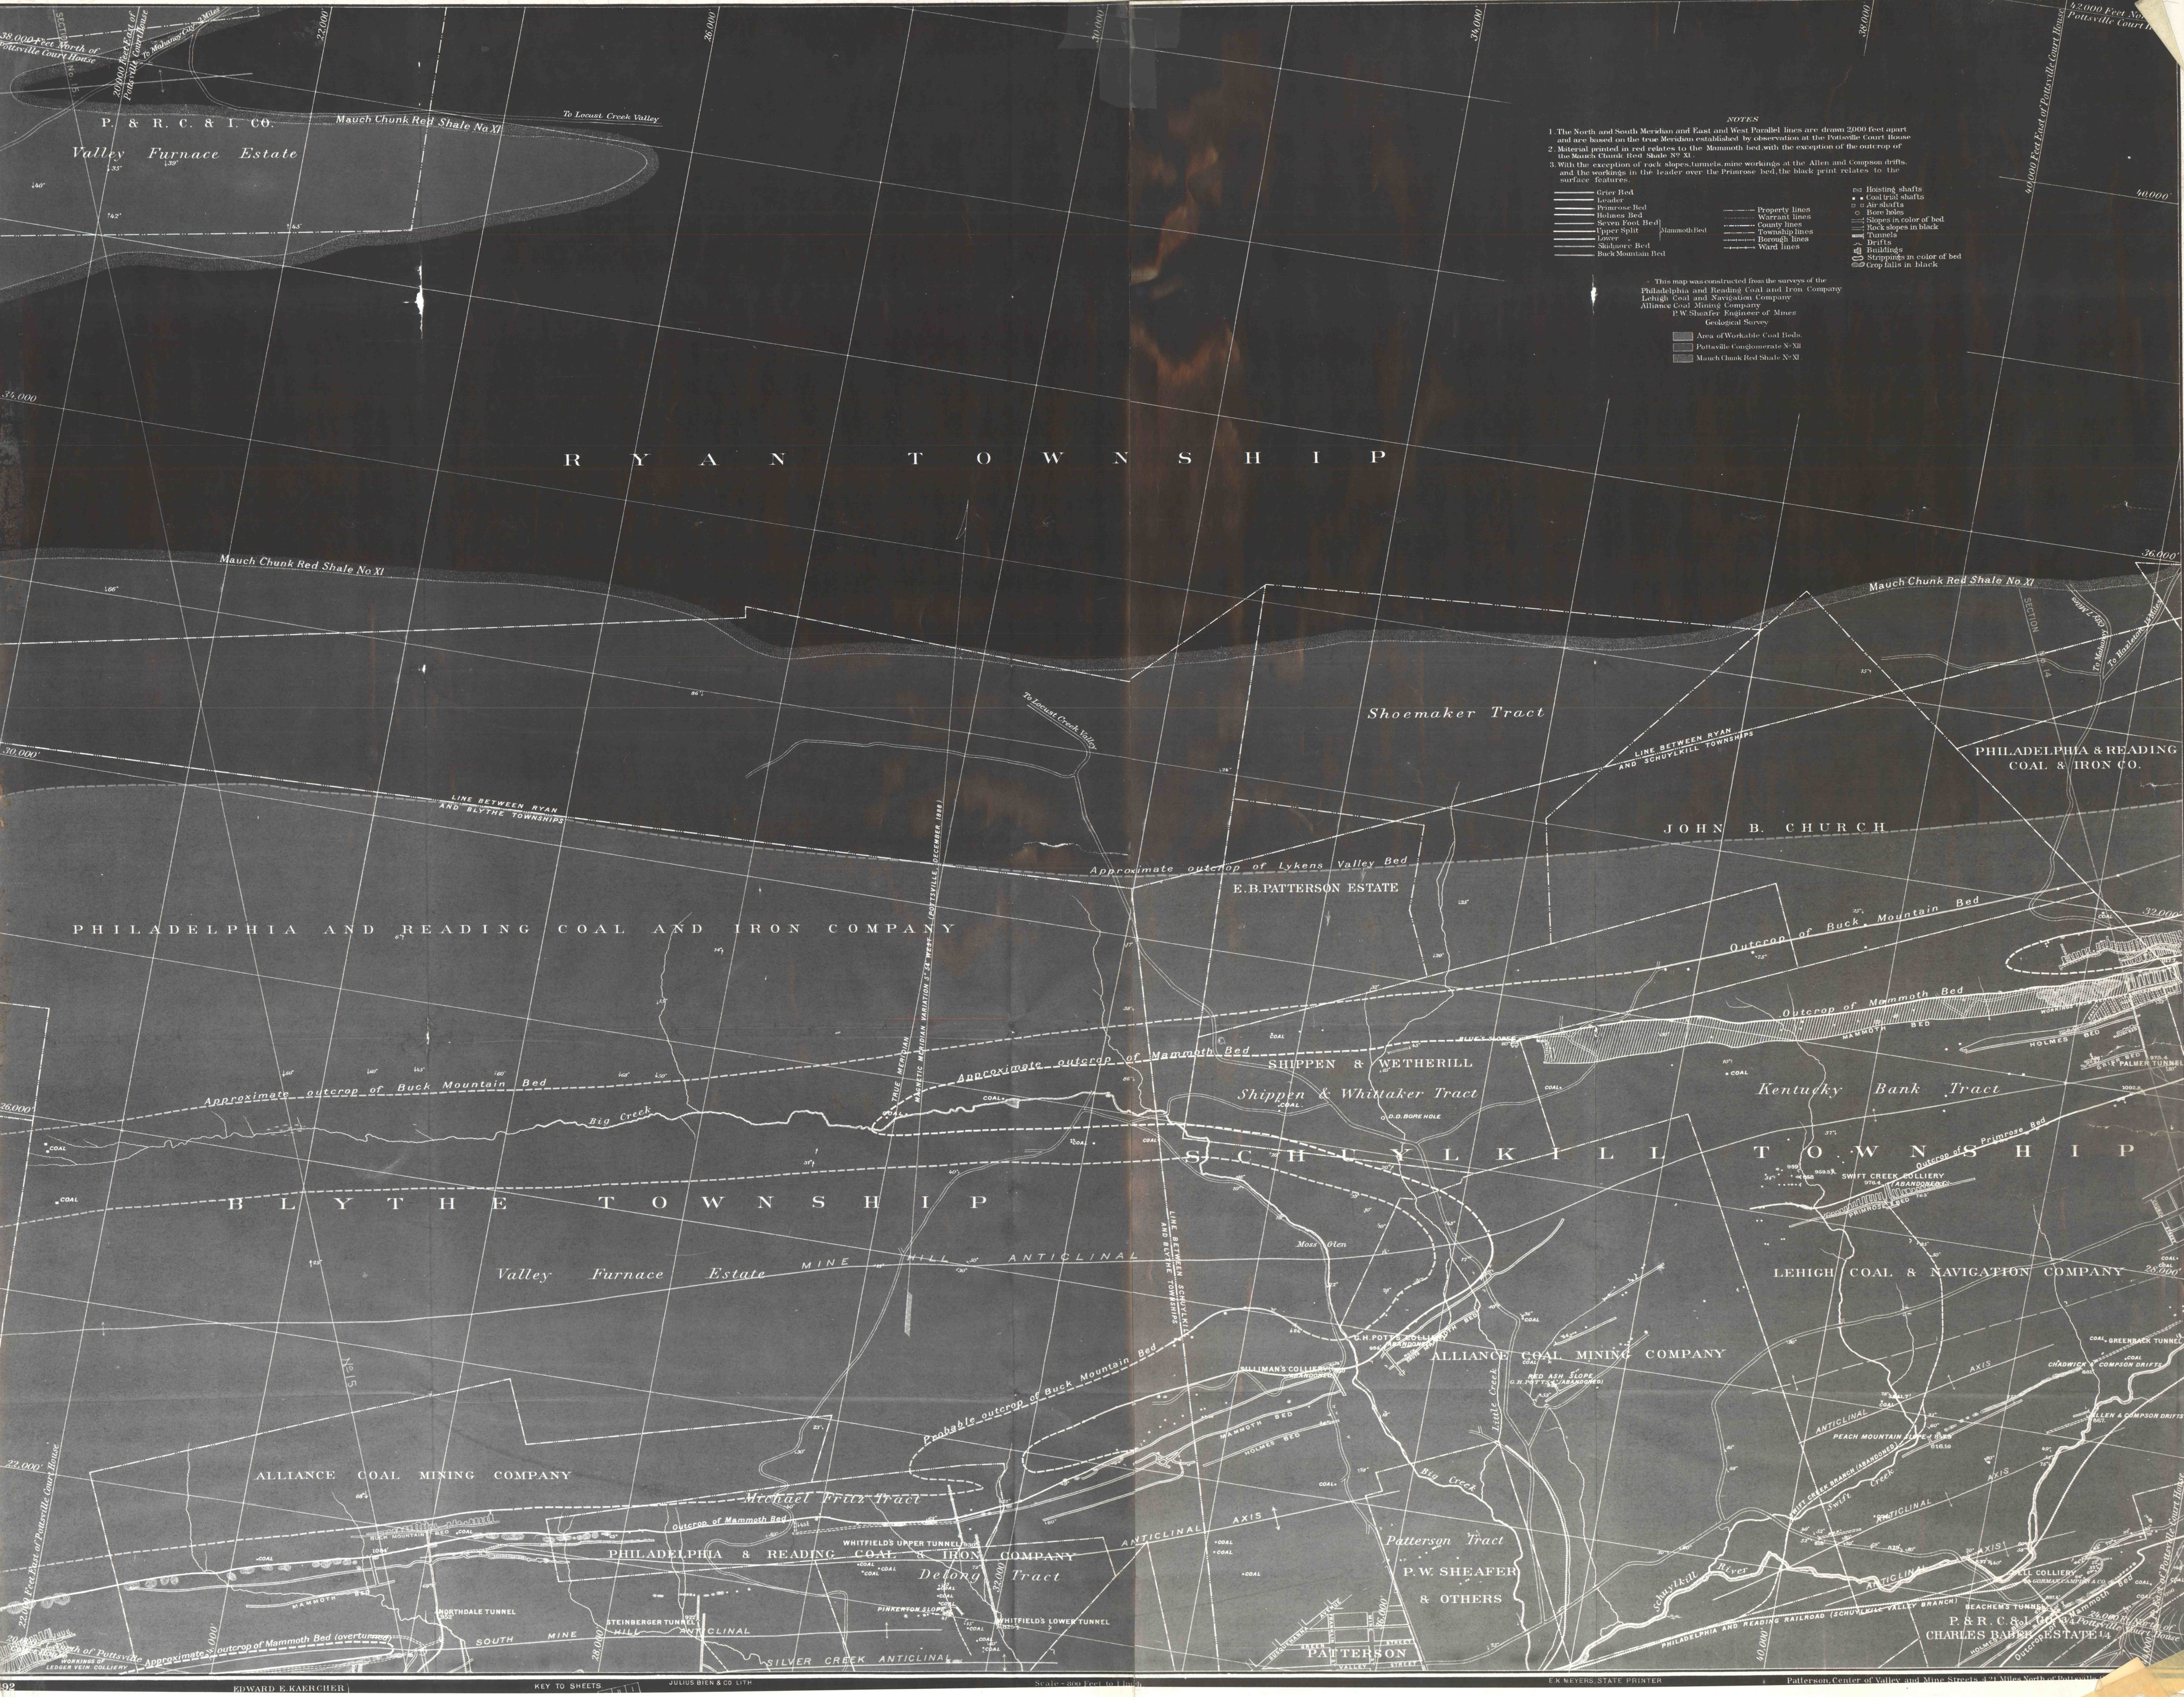








