

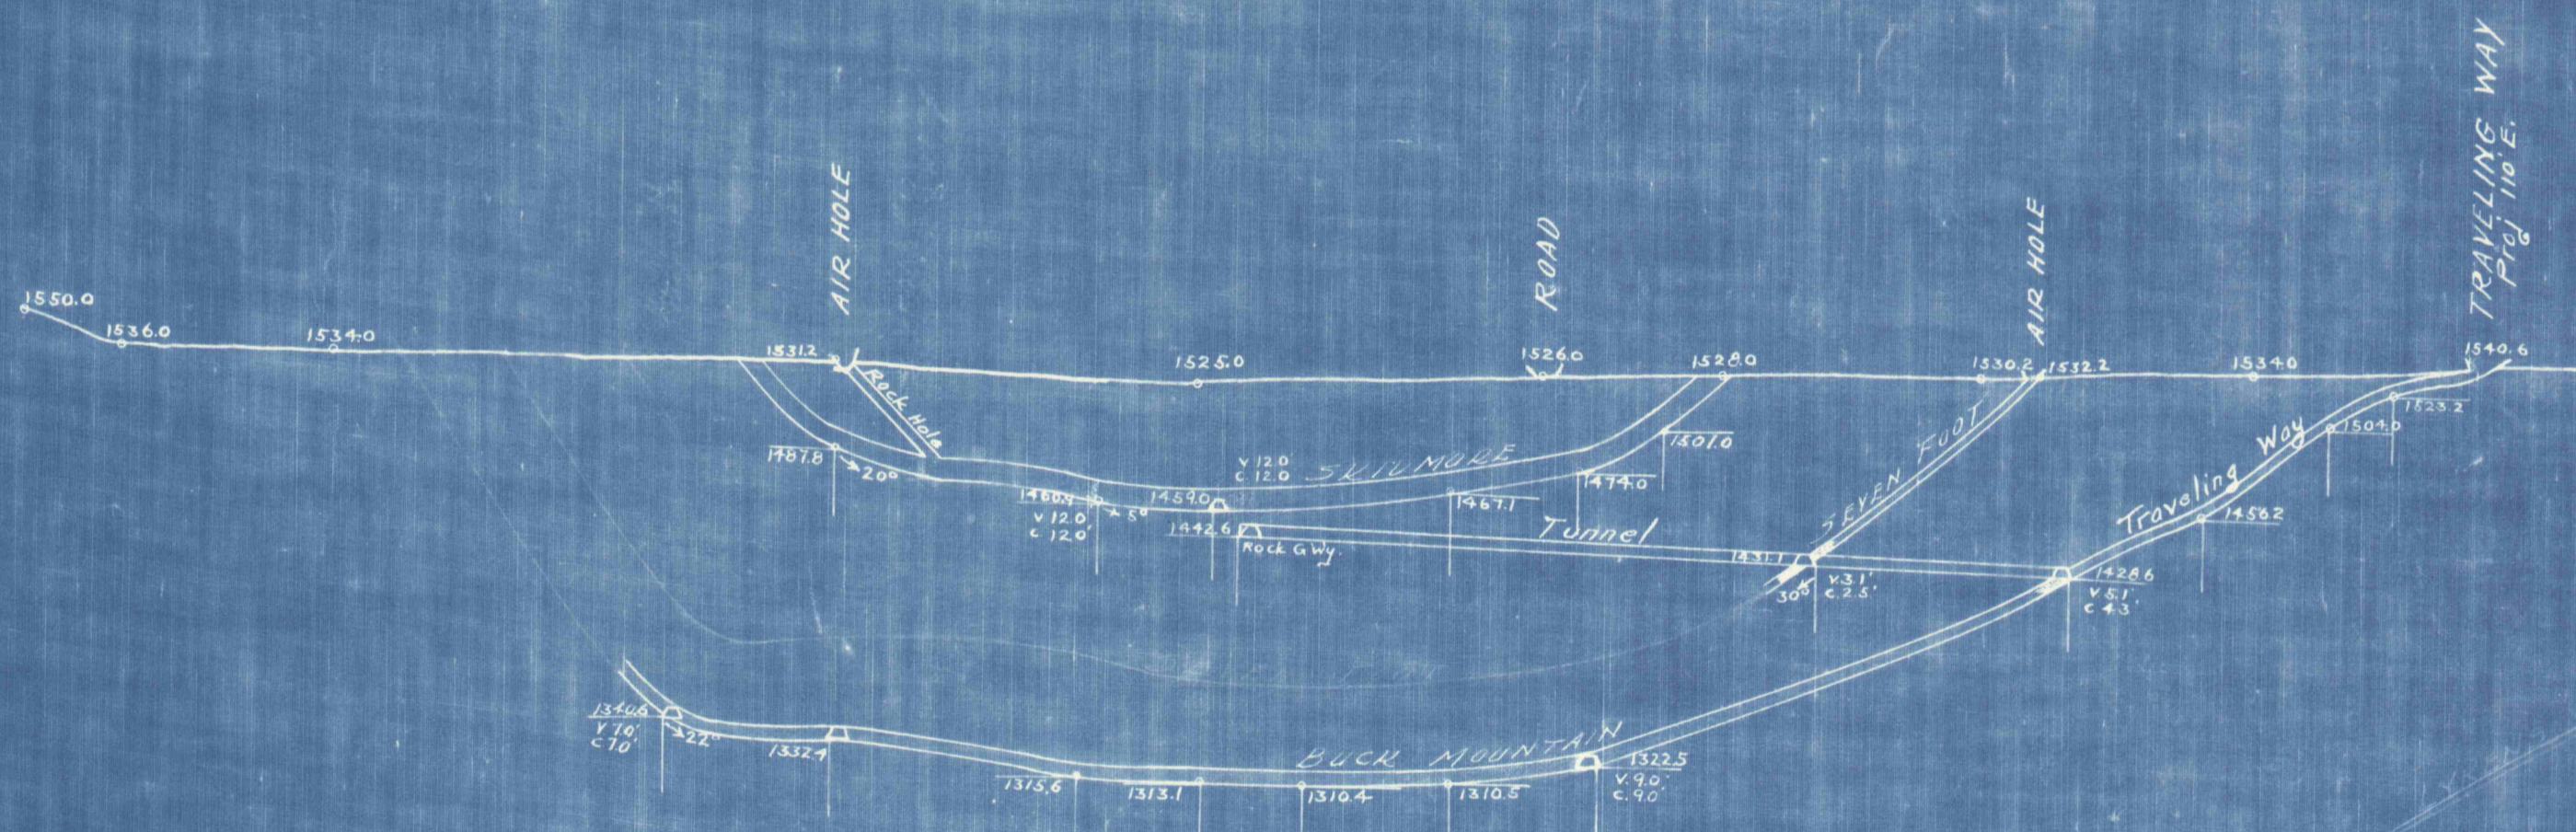


NO. 1 CROSS-SECTION
Through Main Slope.

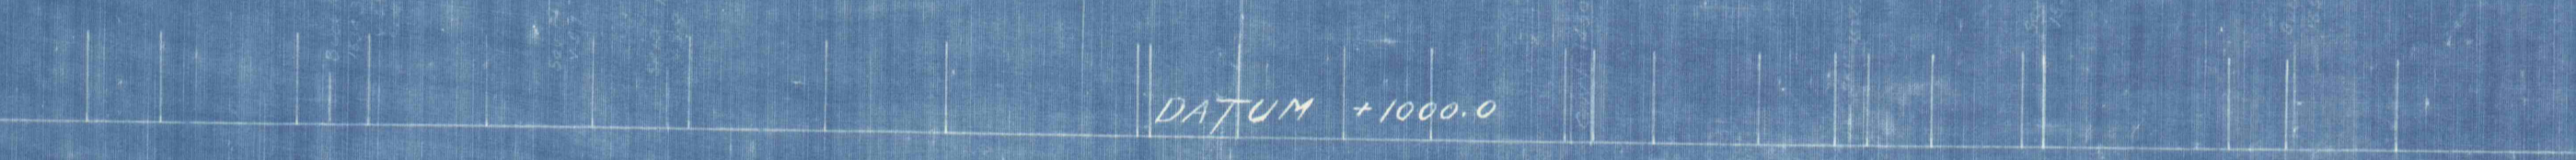

NO. 2 CROSS-SECTION
300' West of Main Slope.

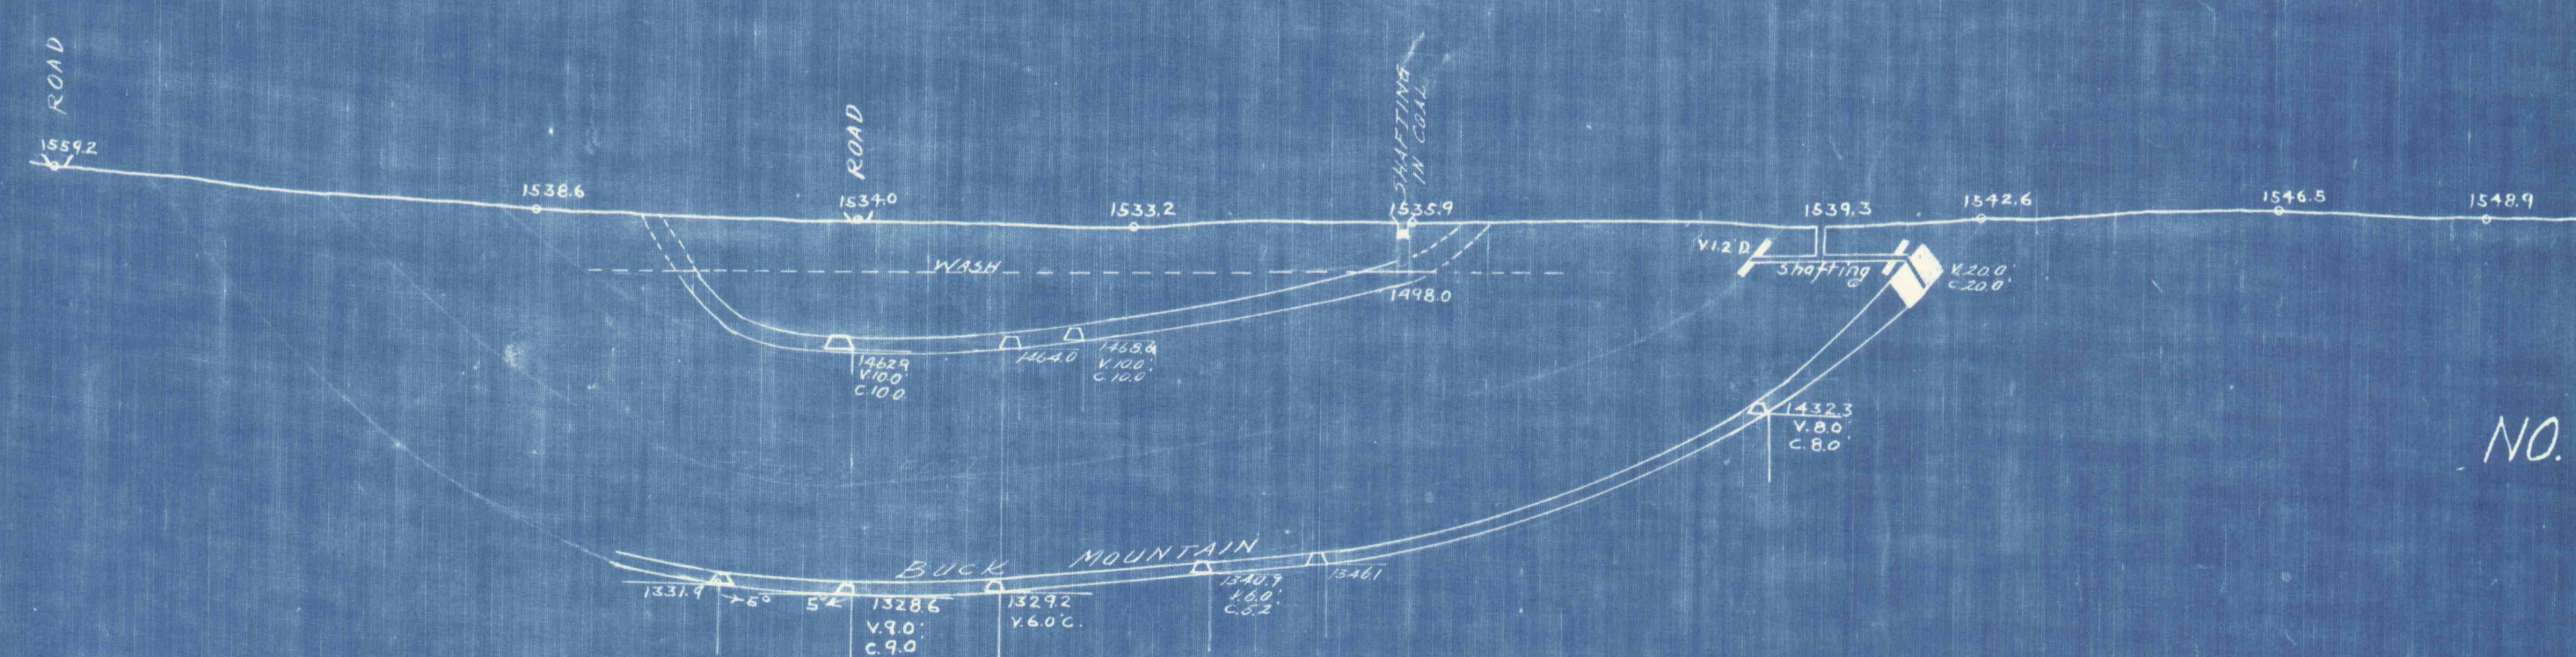

NO. 3 CROSS-SECTION
650' West of Main Slope.

U

AY 27, 1921