




Look East SECTION 0400E&W Datum 1000 Scale 100'

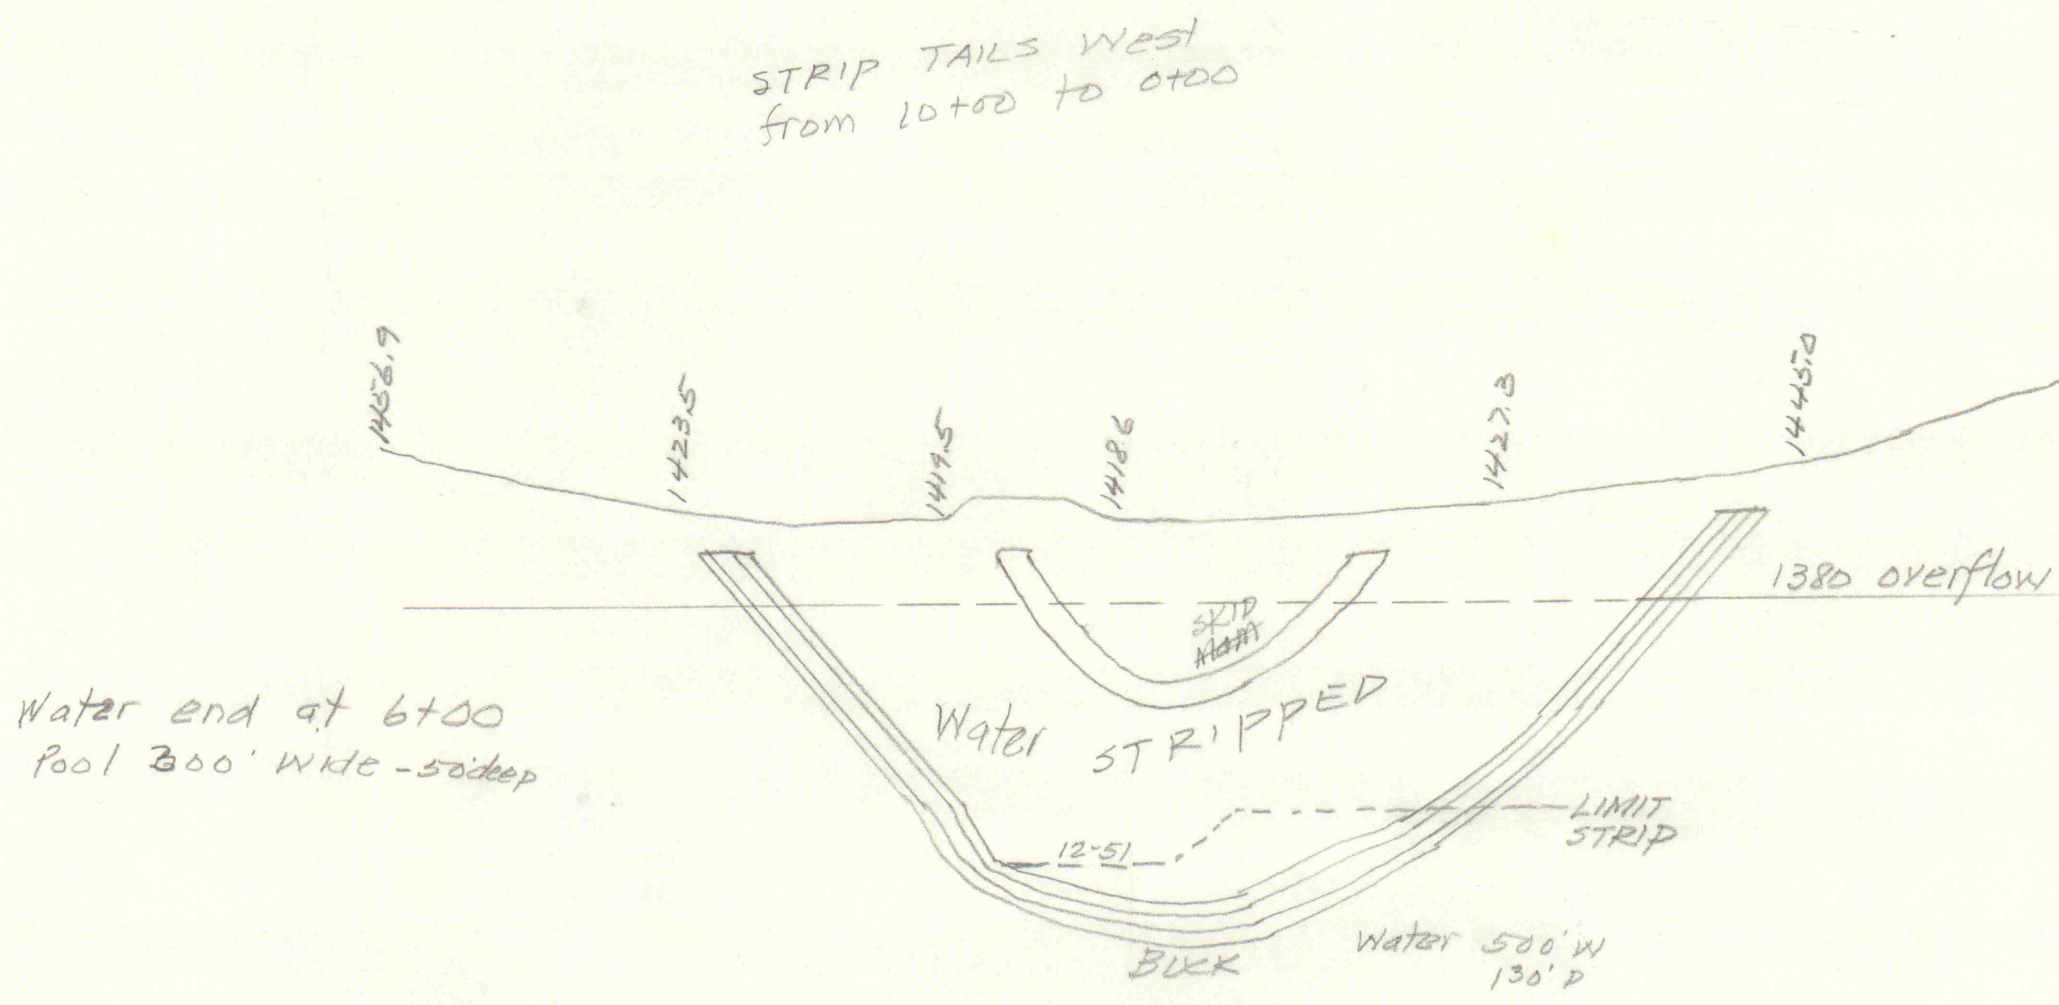

Look East SECTION 10+00 EAST Datum 1000 - 100'

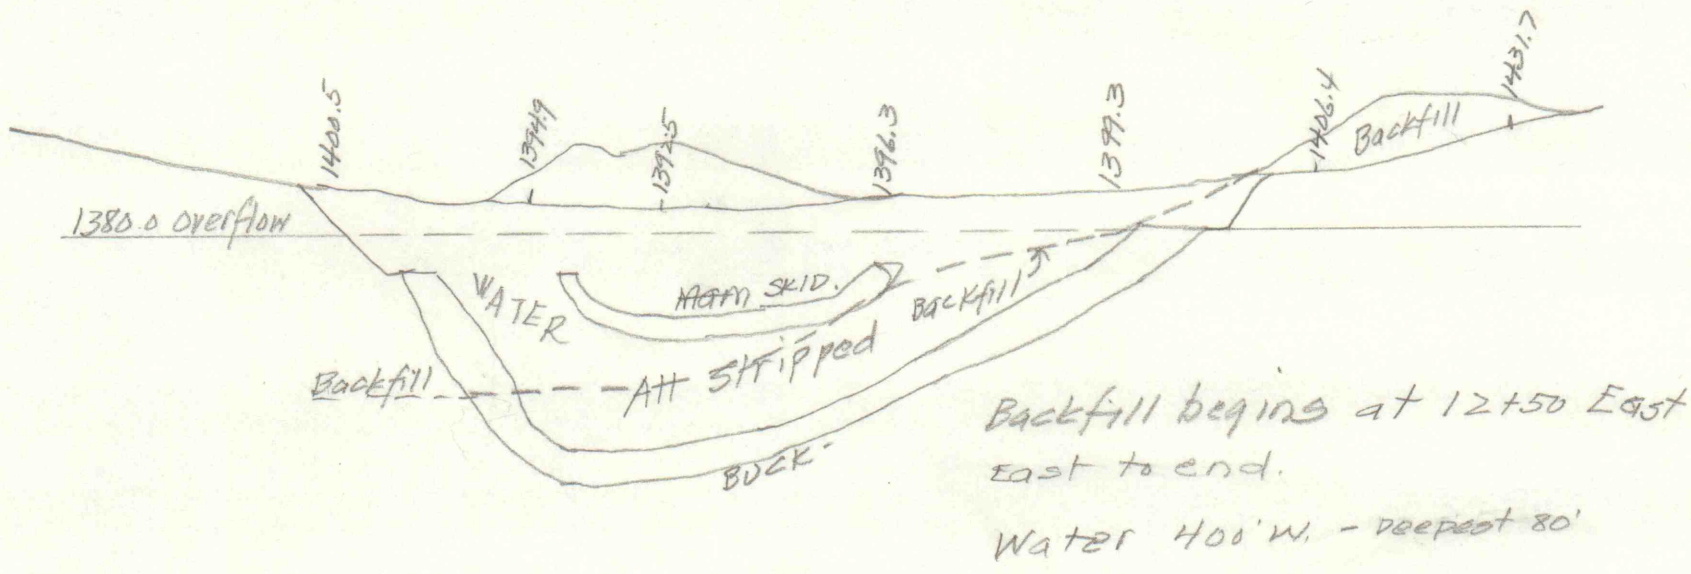

Look East SECT. 20+00 Datum 1000' 100'

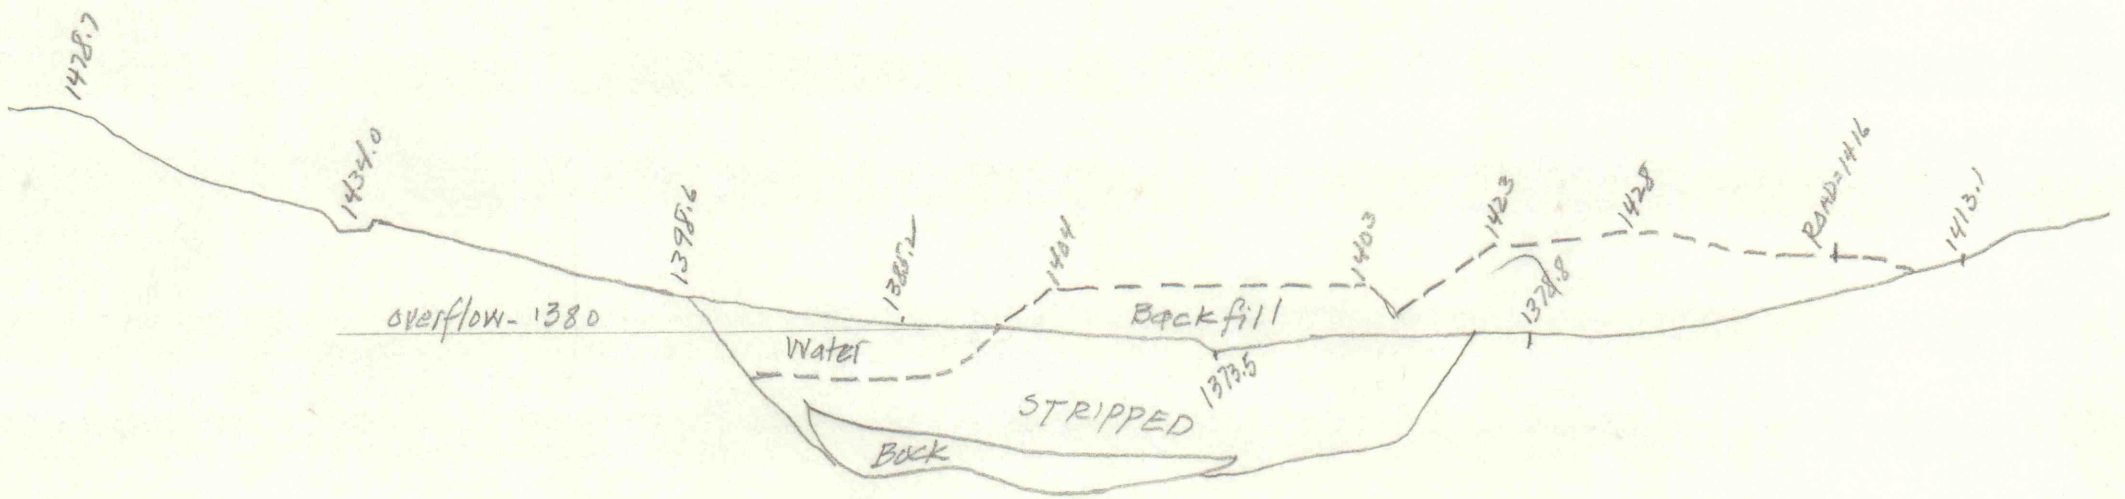

Look East. Sect 30+00 Datum 1000 Strip end at 32+00 overflow - 1380.0

