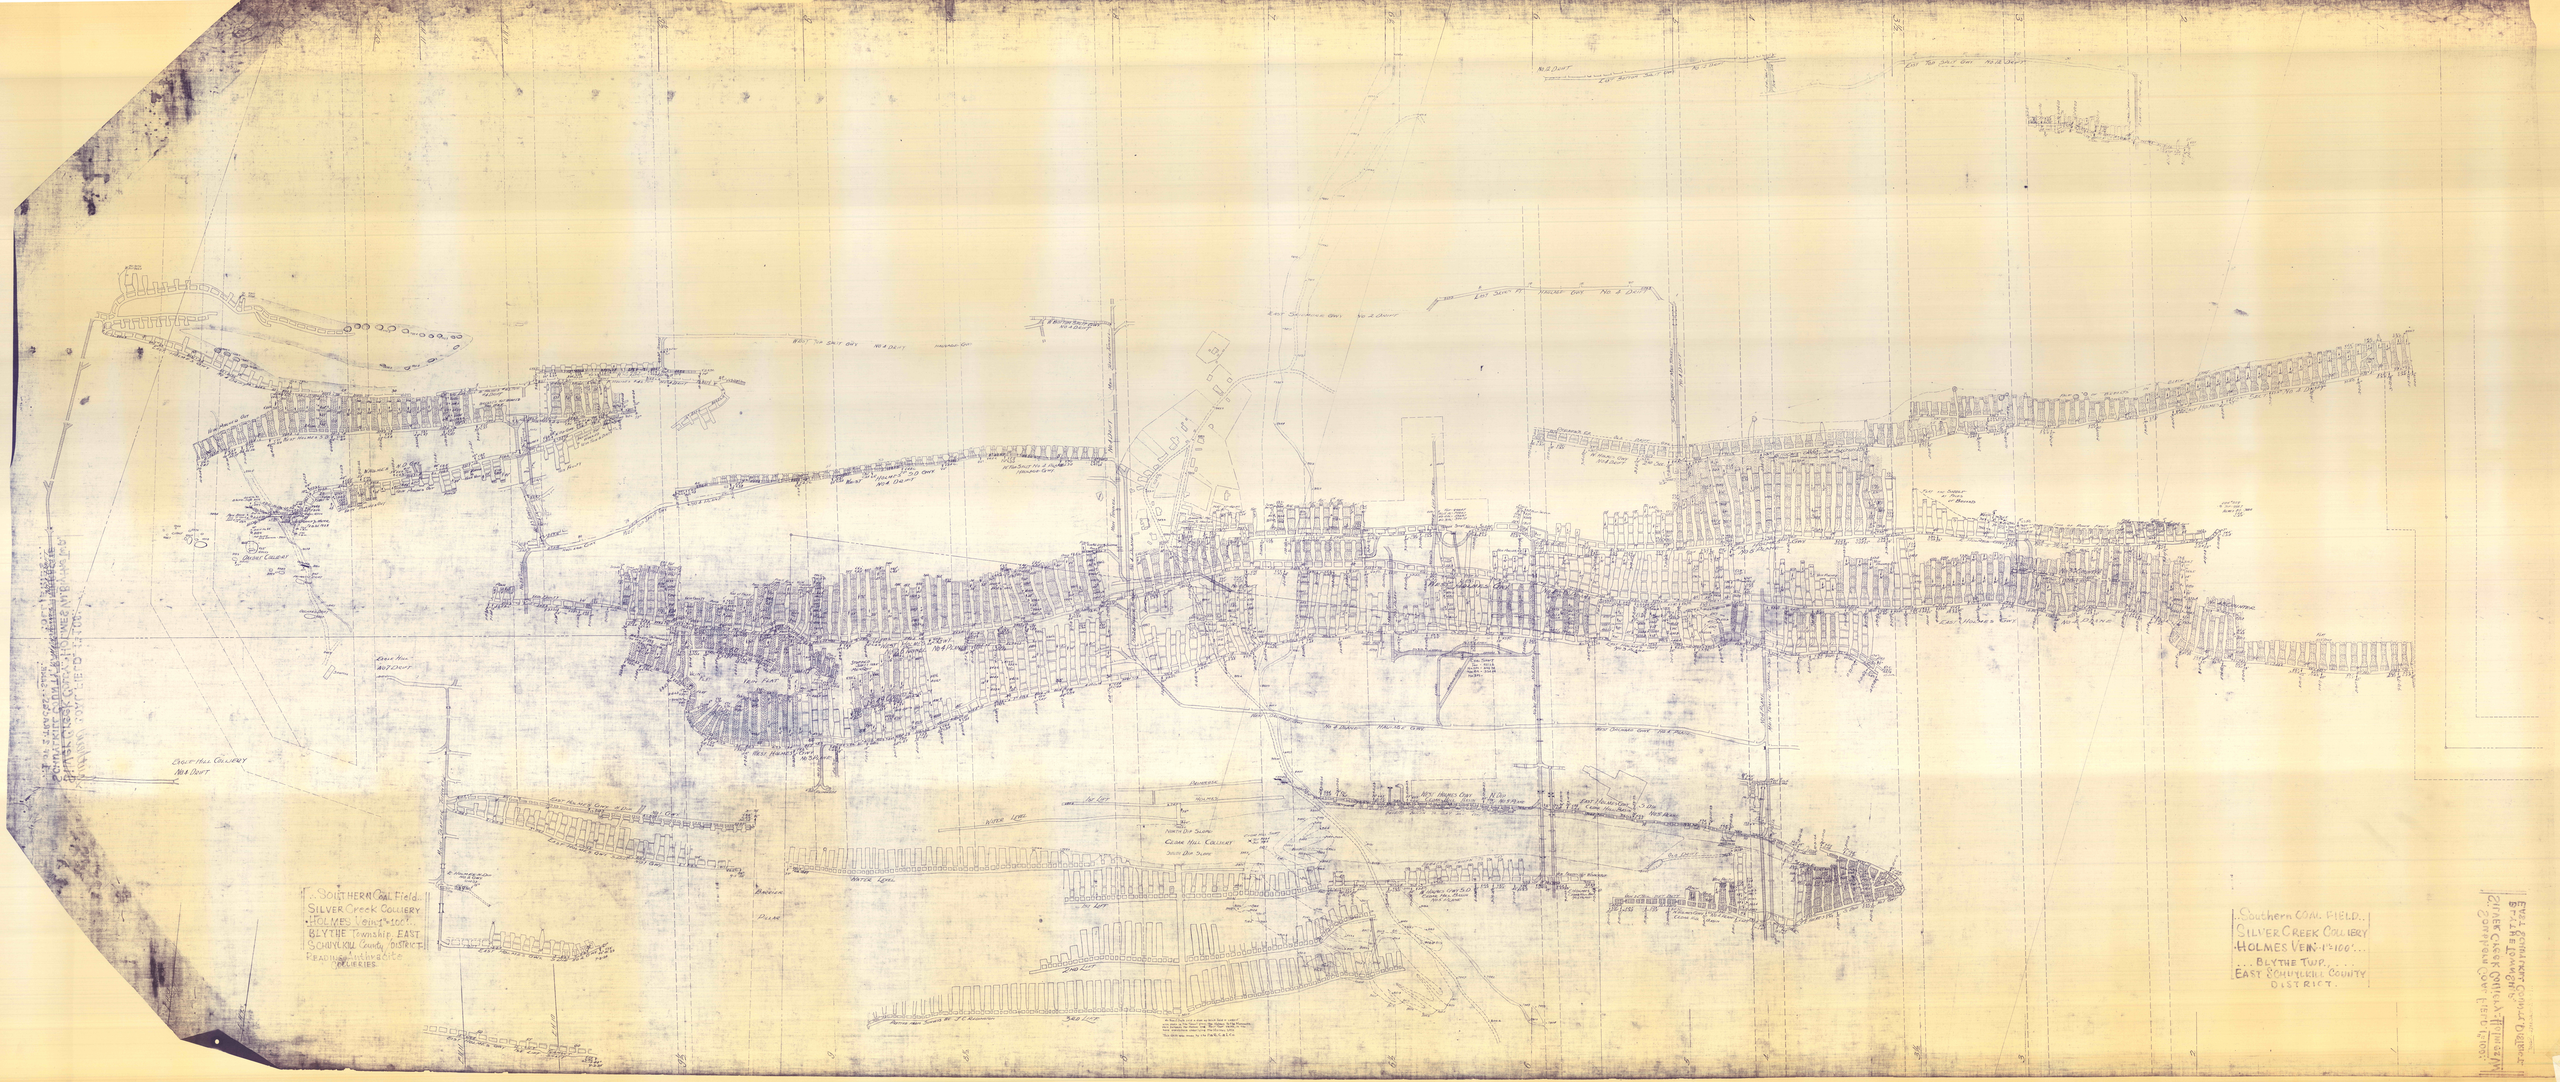

Southern Coal Field.
Silver Creek Colliery
Holmes Vein 1 to 100
Blythe Township, East
Schuylkill County, District
Reading Railway Co's
Collieries
Eagle Hill Colliery
No 4 Dept
Silver Creek Colliery
No 4 Dept
Cedar Hill Colliery
Water Level
Holmes Vein
Southern Coal Field.
Silver Creek Colliery
Holmes Vein 1 to 100
Blythe Twp.
East Schuylkill County
District.