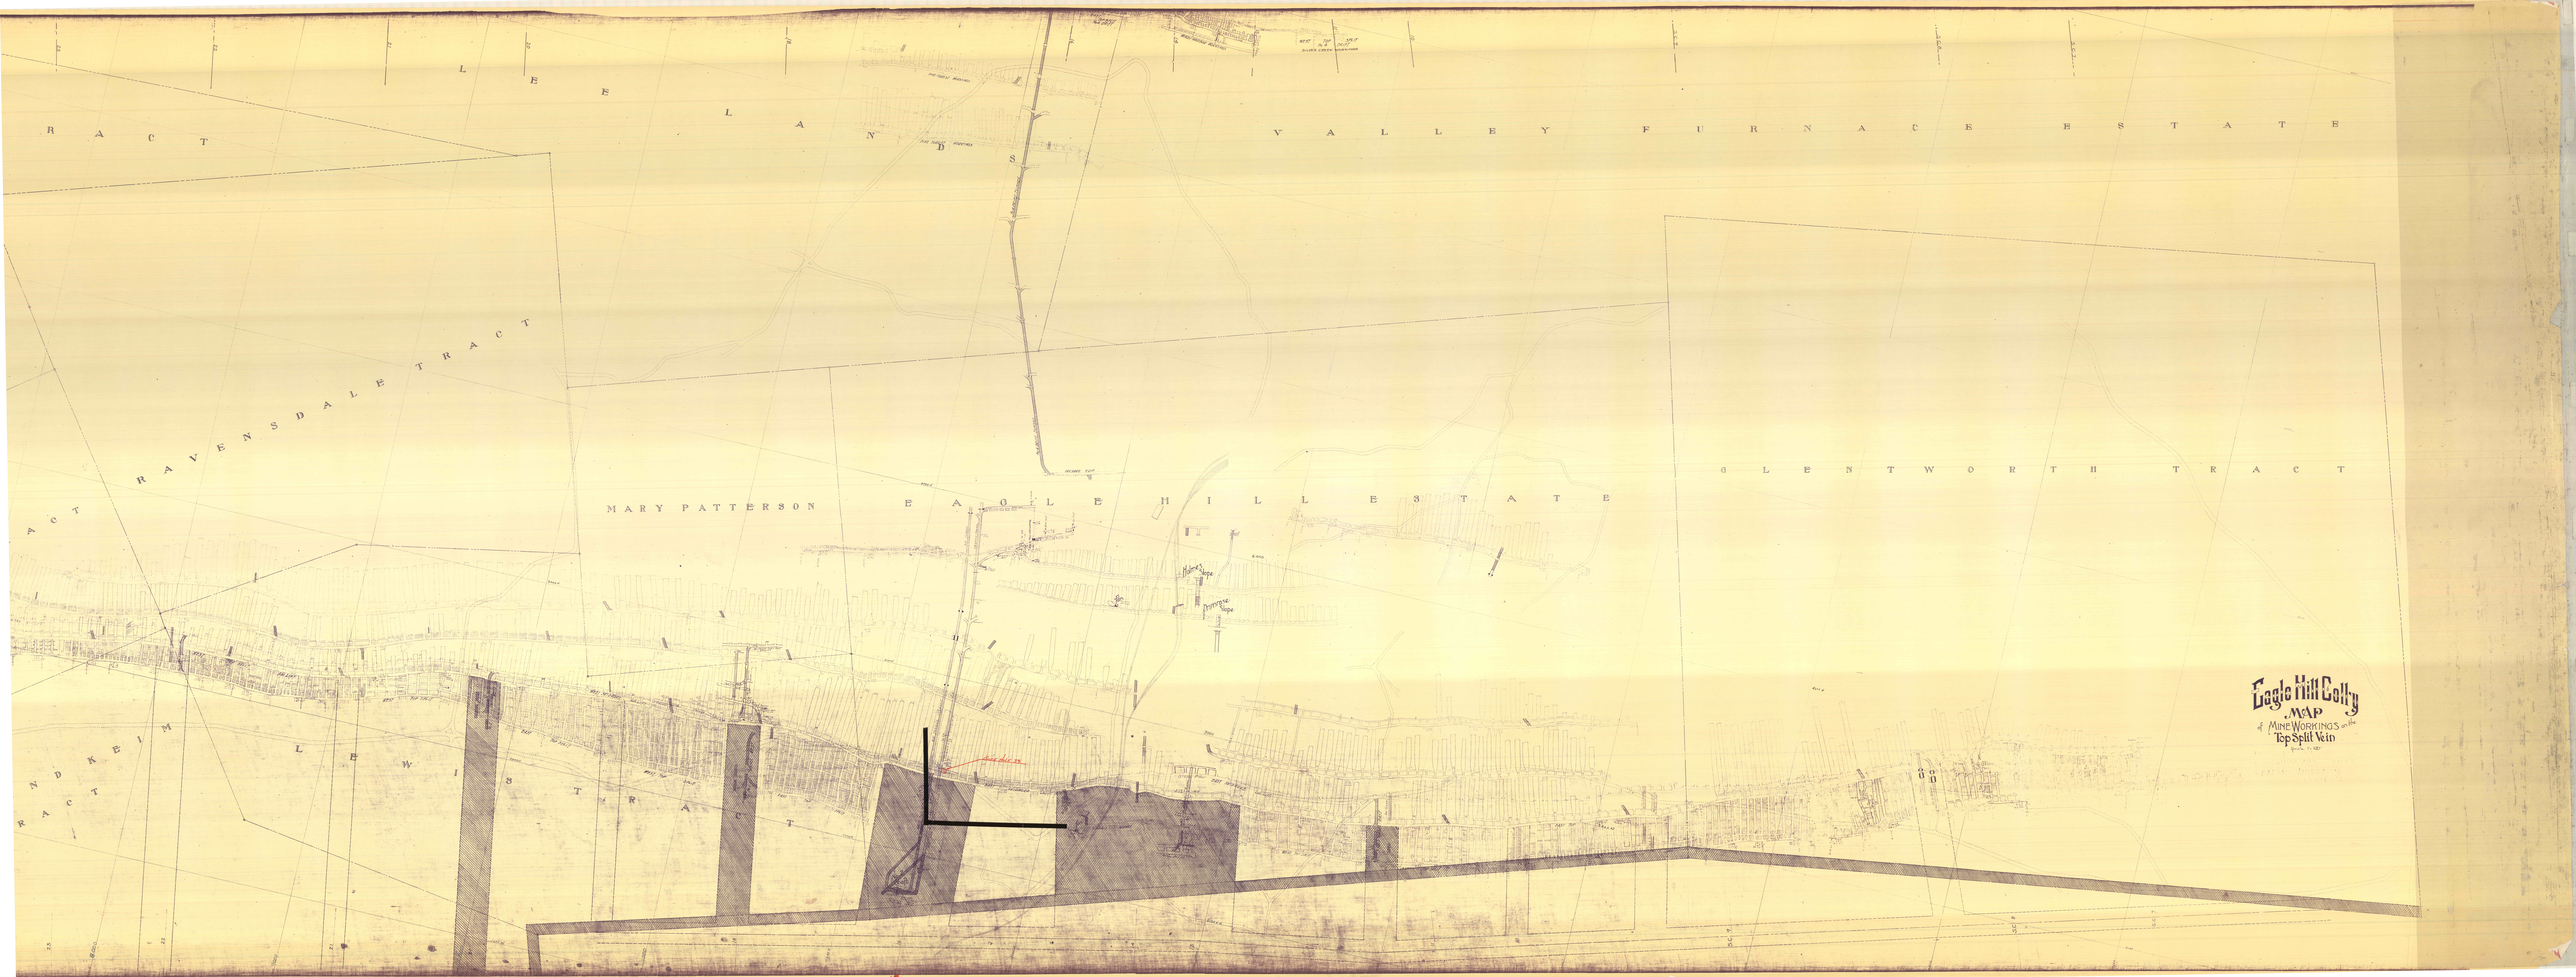
L E E L A N D S
V A L L E Y F U R N A C E E S T A T E
R A C T
R A V E N S D A L E T R A C T
MARY PATTERSON E A G L E H I L L E S T A T E
G L E N T W O R T H T R A C T
L E W I S T R A C T
Eagle Hill Colly
MAP
of MINE WORKINGS on the
Top Split Vein