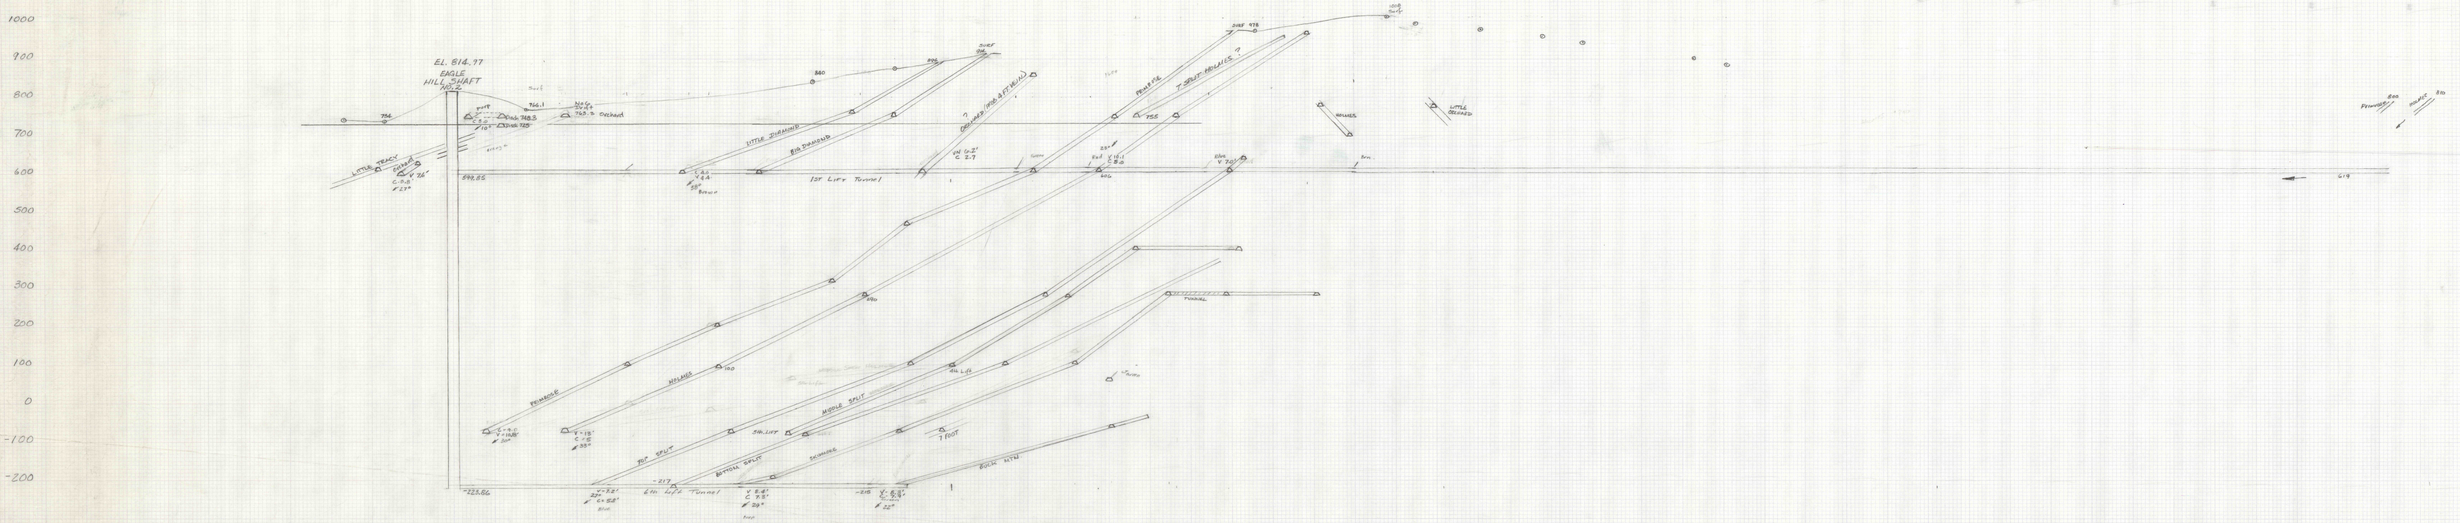

HOLMES SLOPE FILLED WITH SLUSH EL 819.1