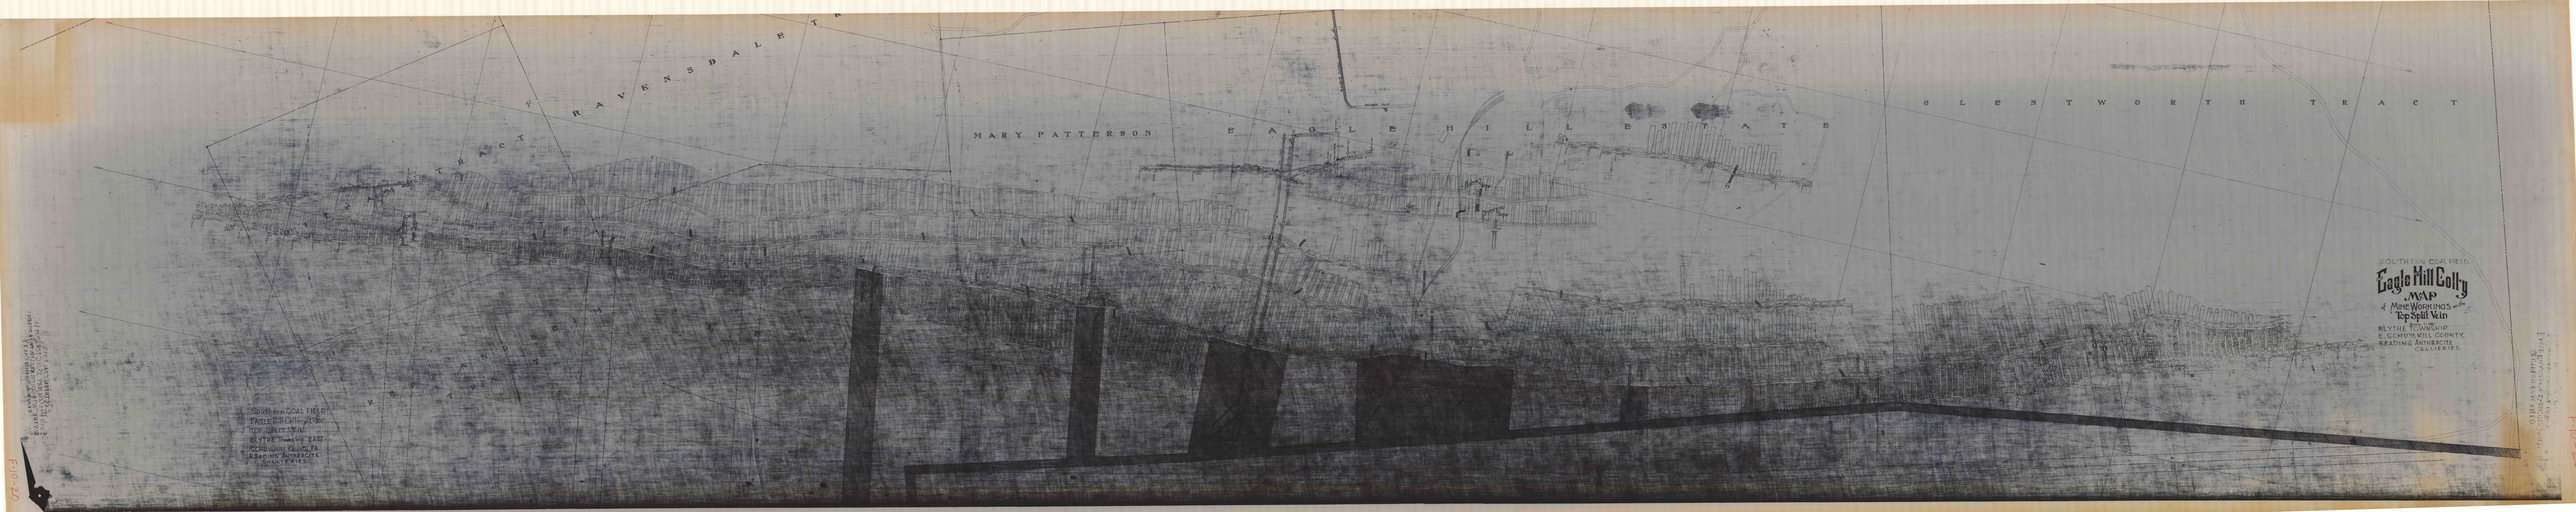
TRACT
RAVENSDALE
MARY PATTERSON
EAGLE HILL ESTATE
GLENTWORTH TRACT
Southern COAL FIELD
Eagle Hill Colliery
MAP
of Mine Workings on the
Top Split Vein
BLYTHE TOWNSHIP
SCHUYLKILL COUNTY
READING ANTHRACITE
COLLIERIES
Southern COAL FIELD
EAGLE Hill Colliery
TOP SPLIT VEIN
BLYTHE Township EAST
SCHUYLKILL County, Pa
READING ANTHRACITE
COMPANY