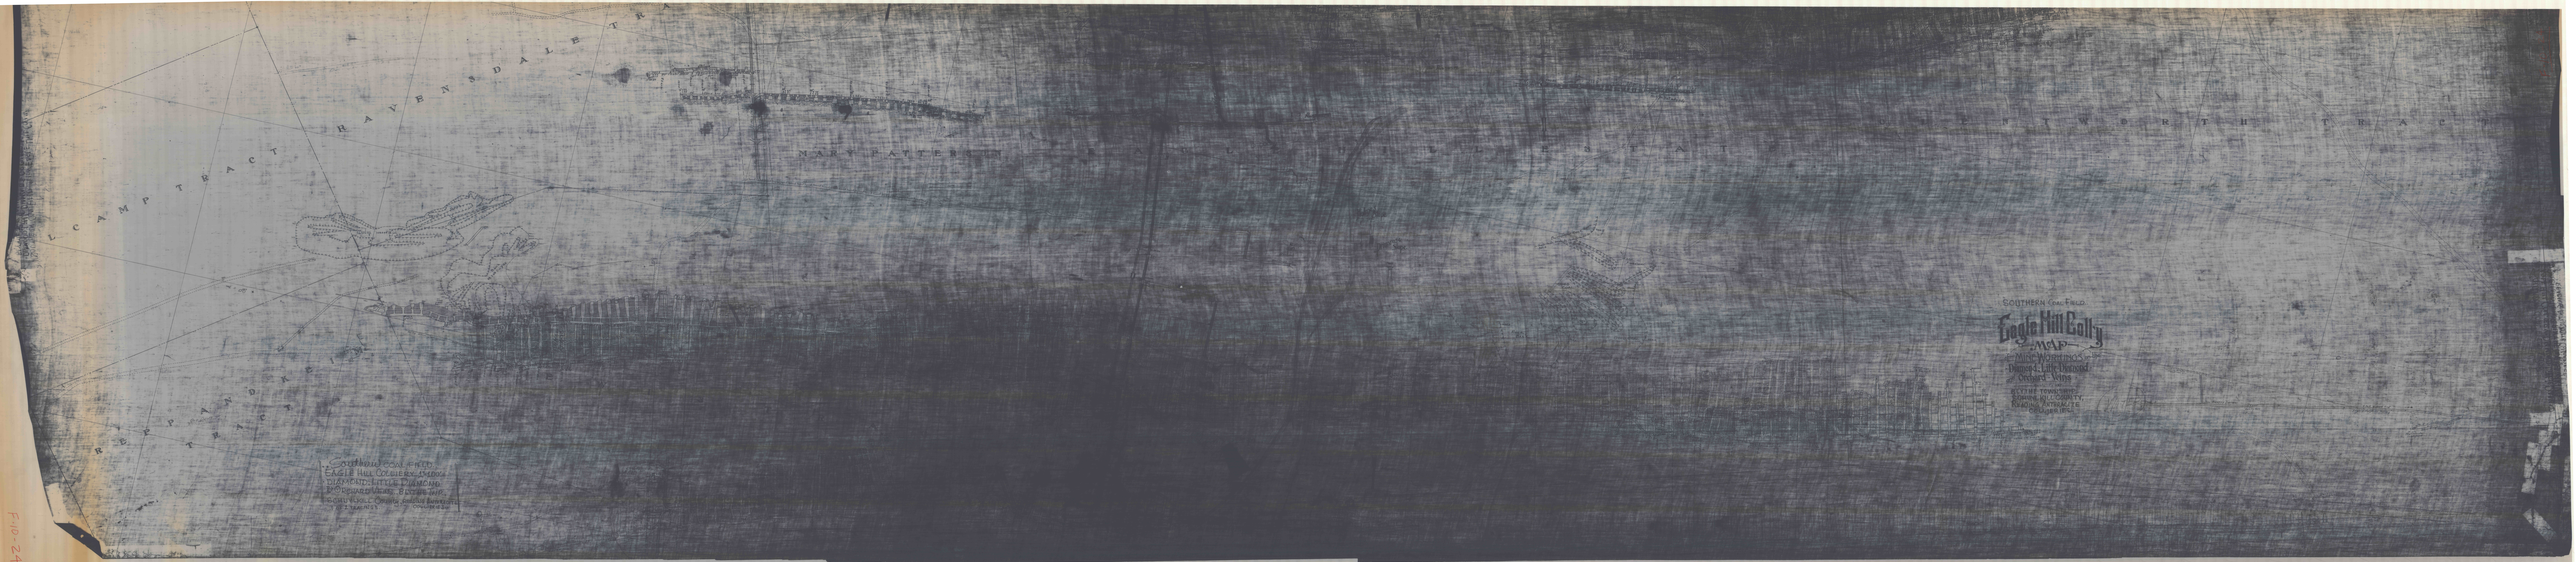
CAMP TRACT
HAVENSDALE TRACT
REPPLIER TRACT
NEWPORT TRACT
SOUTHERN COAL FIELD
Eagle Hill Colly
MAP
Mine Workings
Diamond Little Diamond
Orchard View
SCALE 200 FEET TO THE INCH
EAGLE HILL COLLIERY COMPANY
DIAMOND, LITTLE DIAMOND
& ORCHARD VIEW SEAMS
SOUTH POOL, CAMP & NEWPORT
TRACTS
PENNSYLVANIA

F10-24