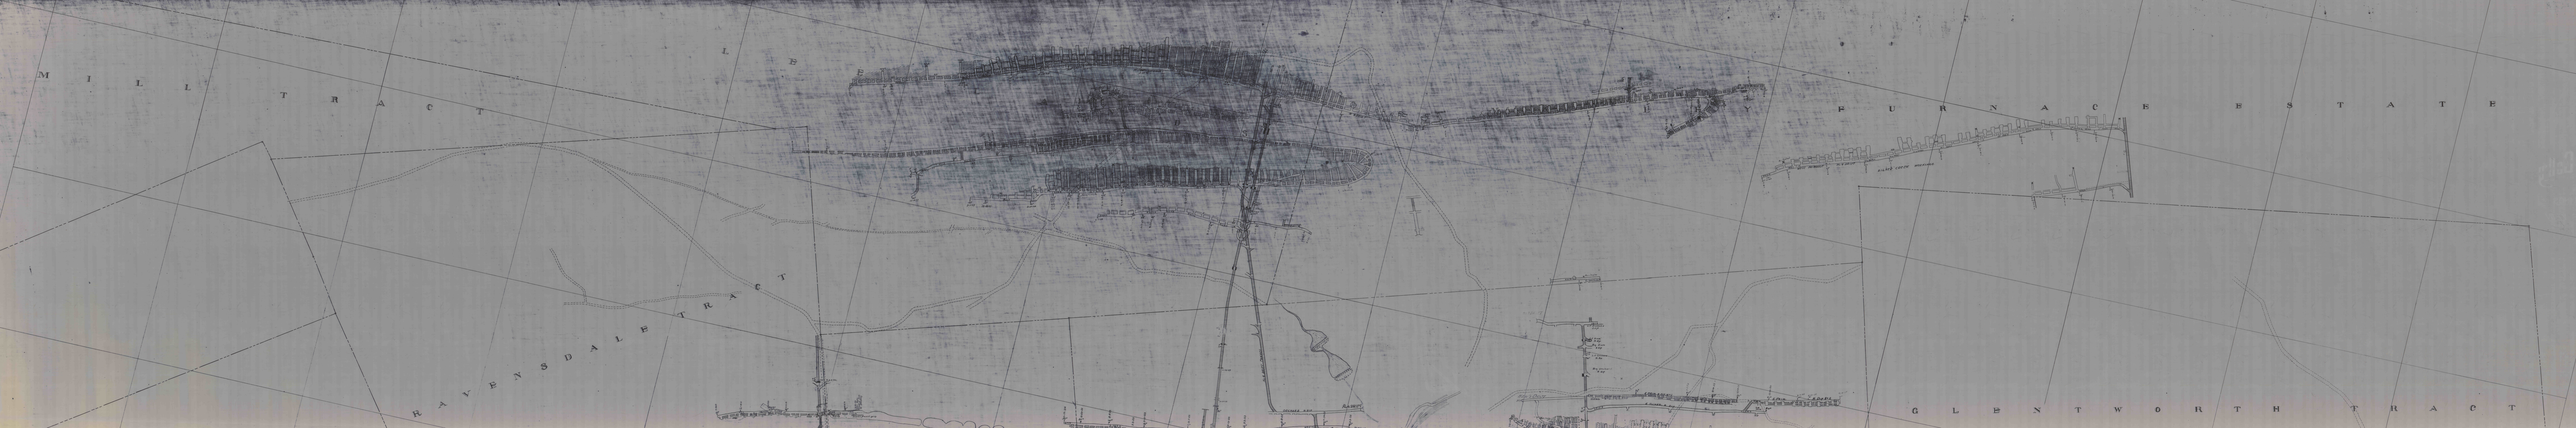
M I L L T R A C T
R A V E N S D A L E T R A C T
F U R N A C E E S T A T E
G L E N T W O R T H T R A C T