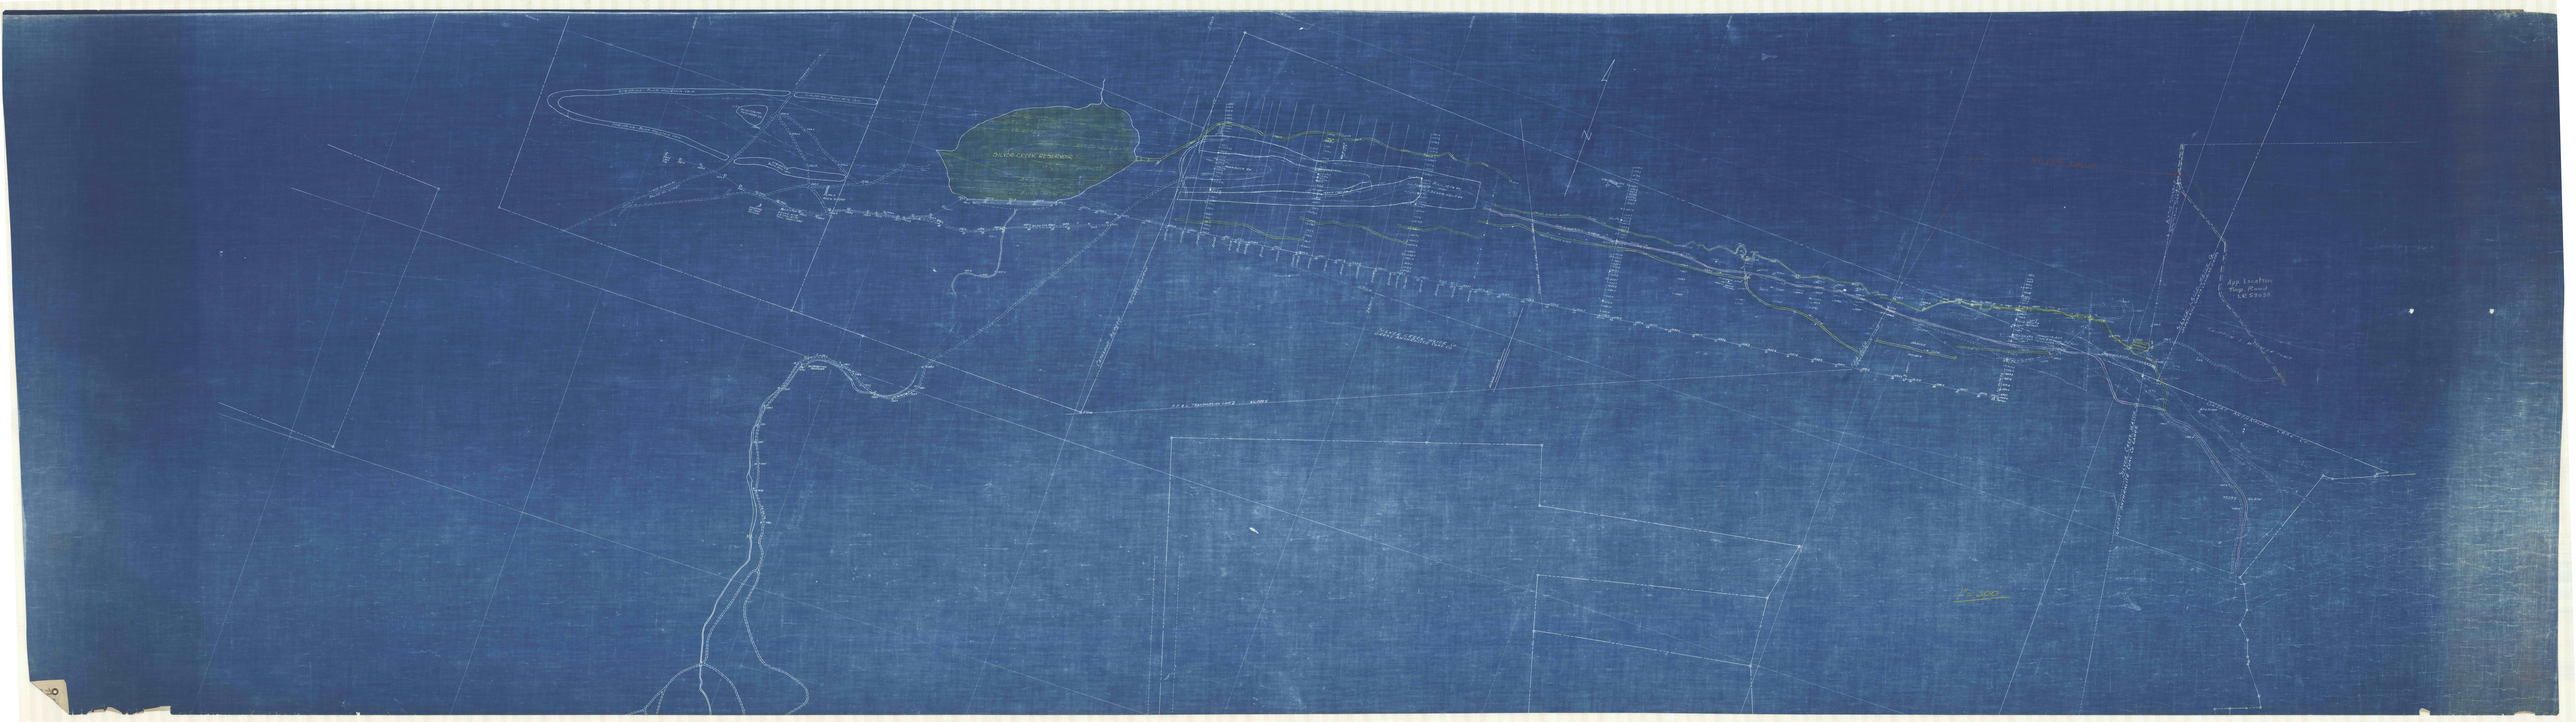
SILVER CREEK RESERVOIR
N
App. Location
Prop. Pipeline
T.&E. 57+00
25,000