


3000 SOUTH






1000 SOUTH

1000 SOUTH

CLARK COAL CO.

ARL COAL CO.

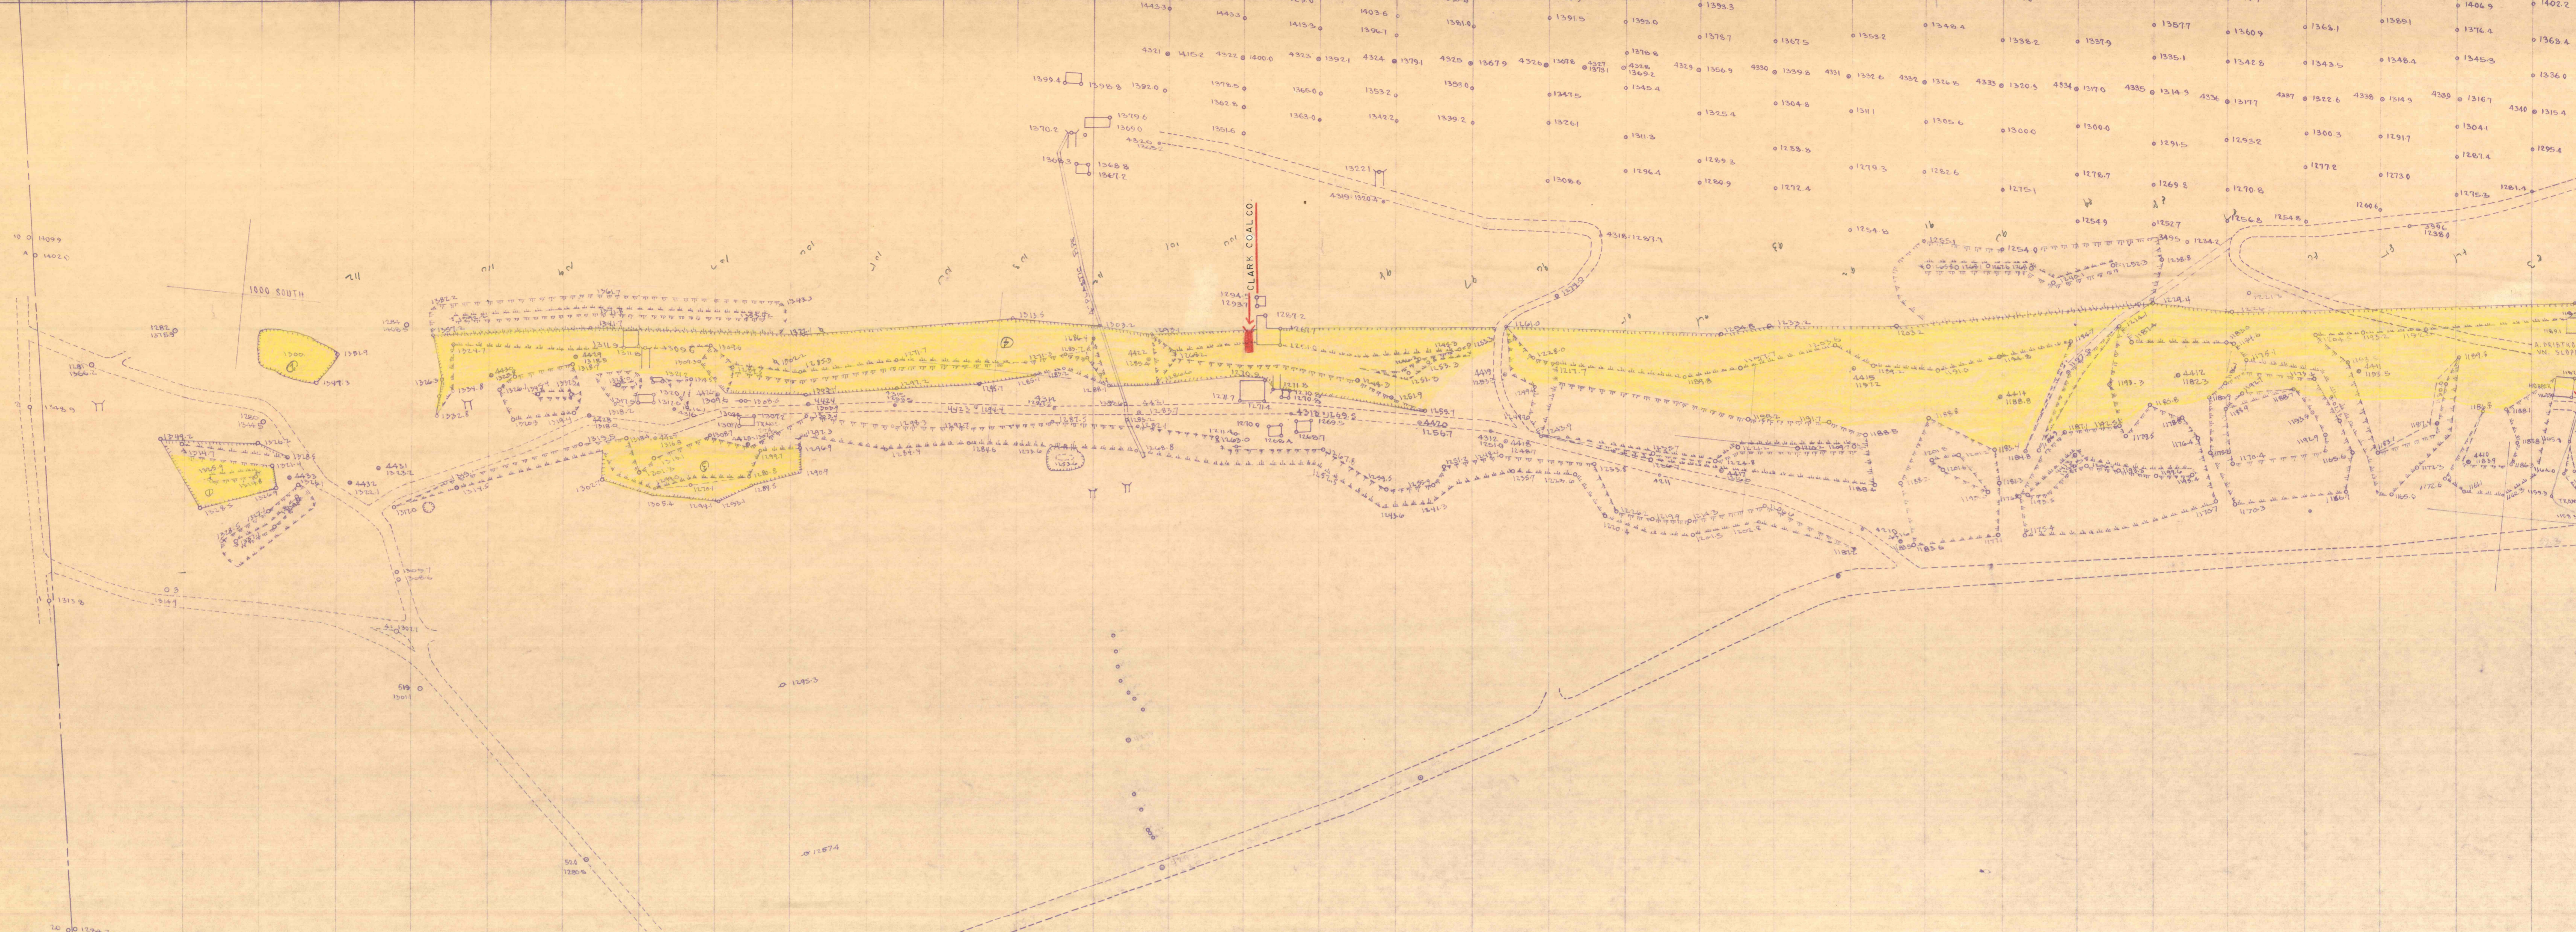

