


NOTE:
 AREA SHOWN HAS BEEN DECLAIEMD SINCE MAPPING.
 CONTRACTOR SHALL MAKE VISIBL INSPECTION OF AREA
 SINCE CONTOURS MAY NOT REFLECT ACTUAL CONDITIONS.

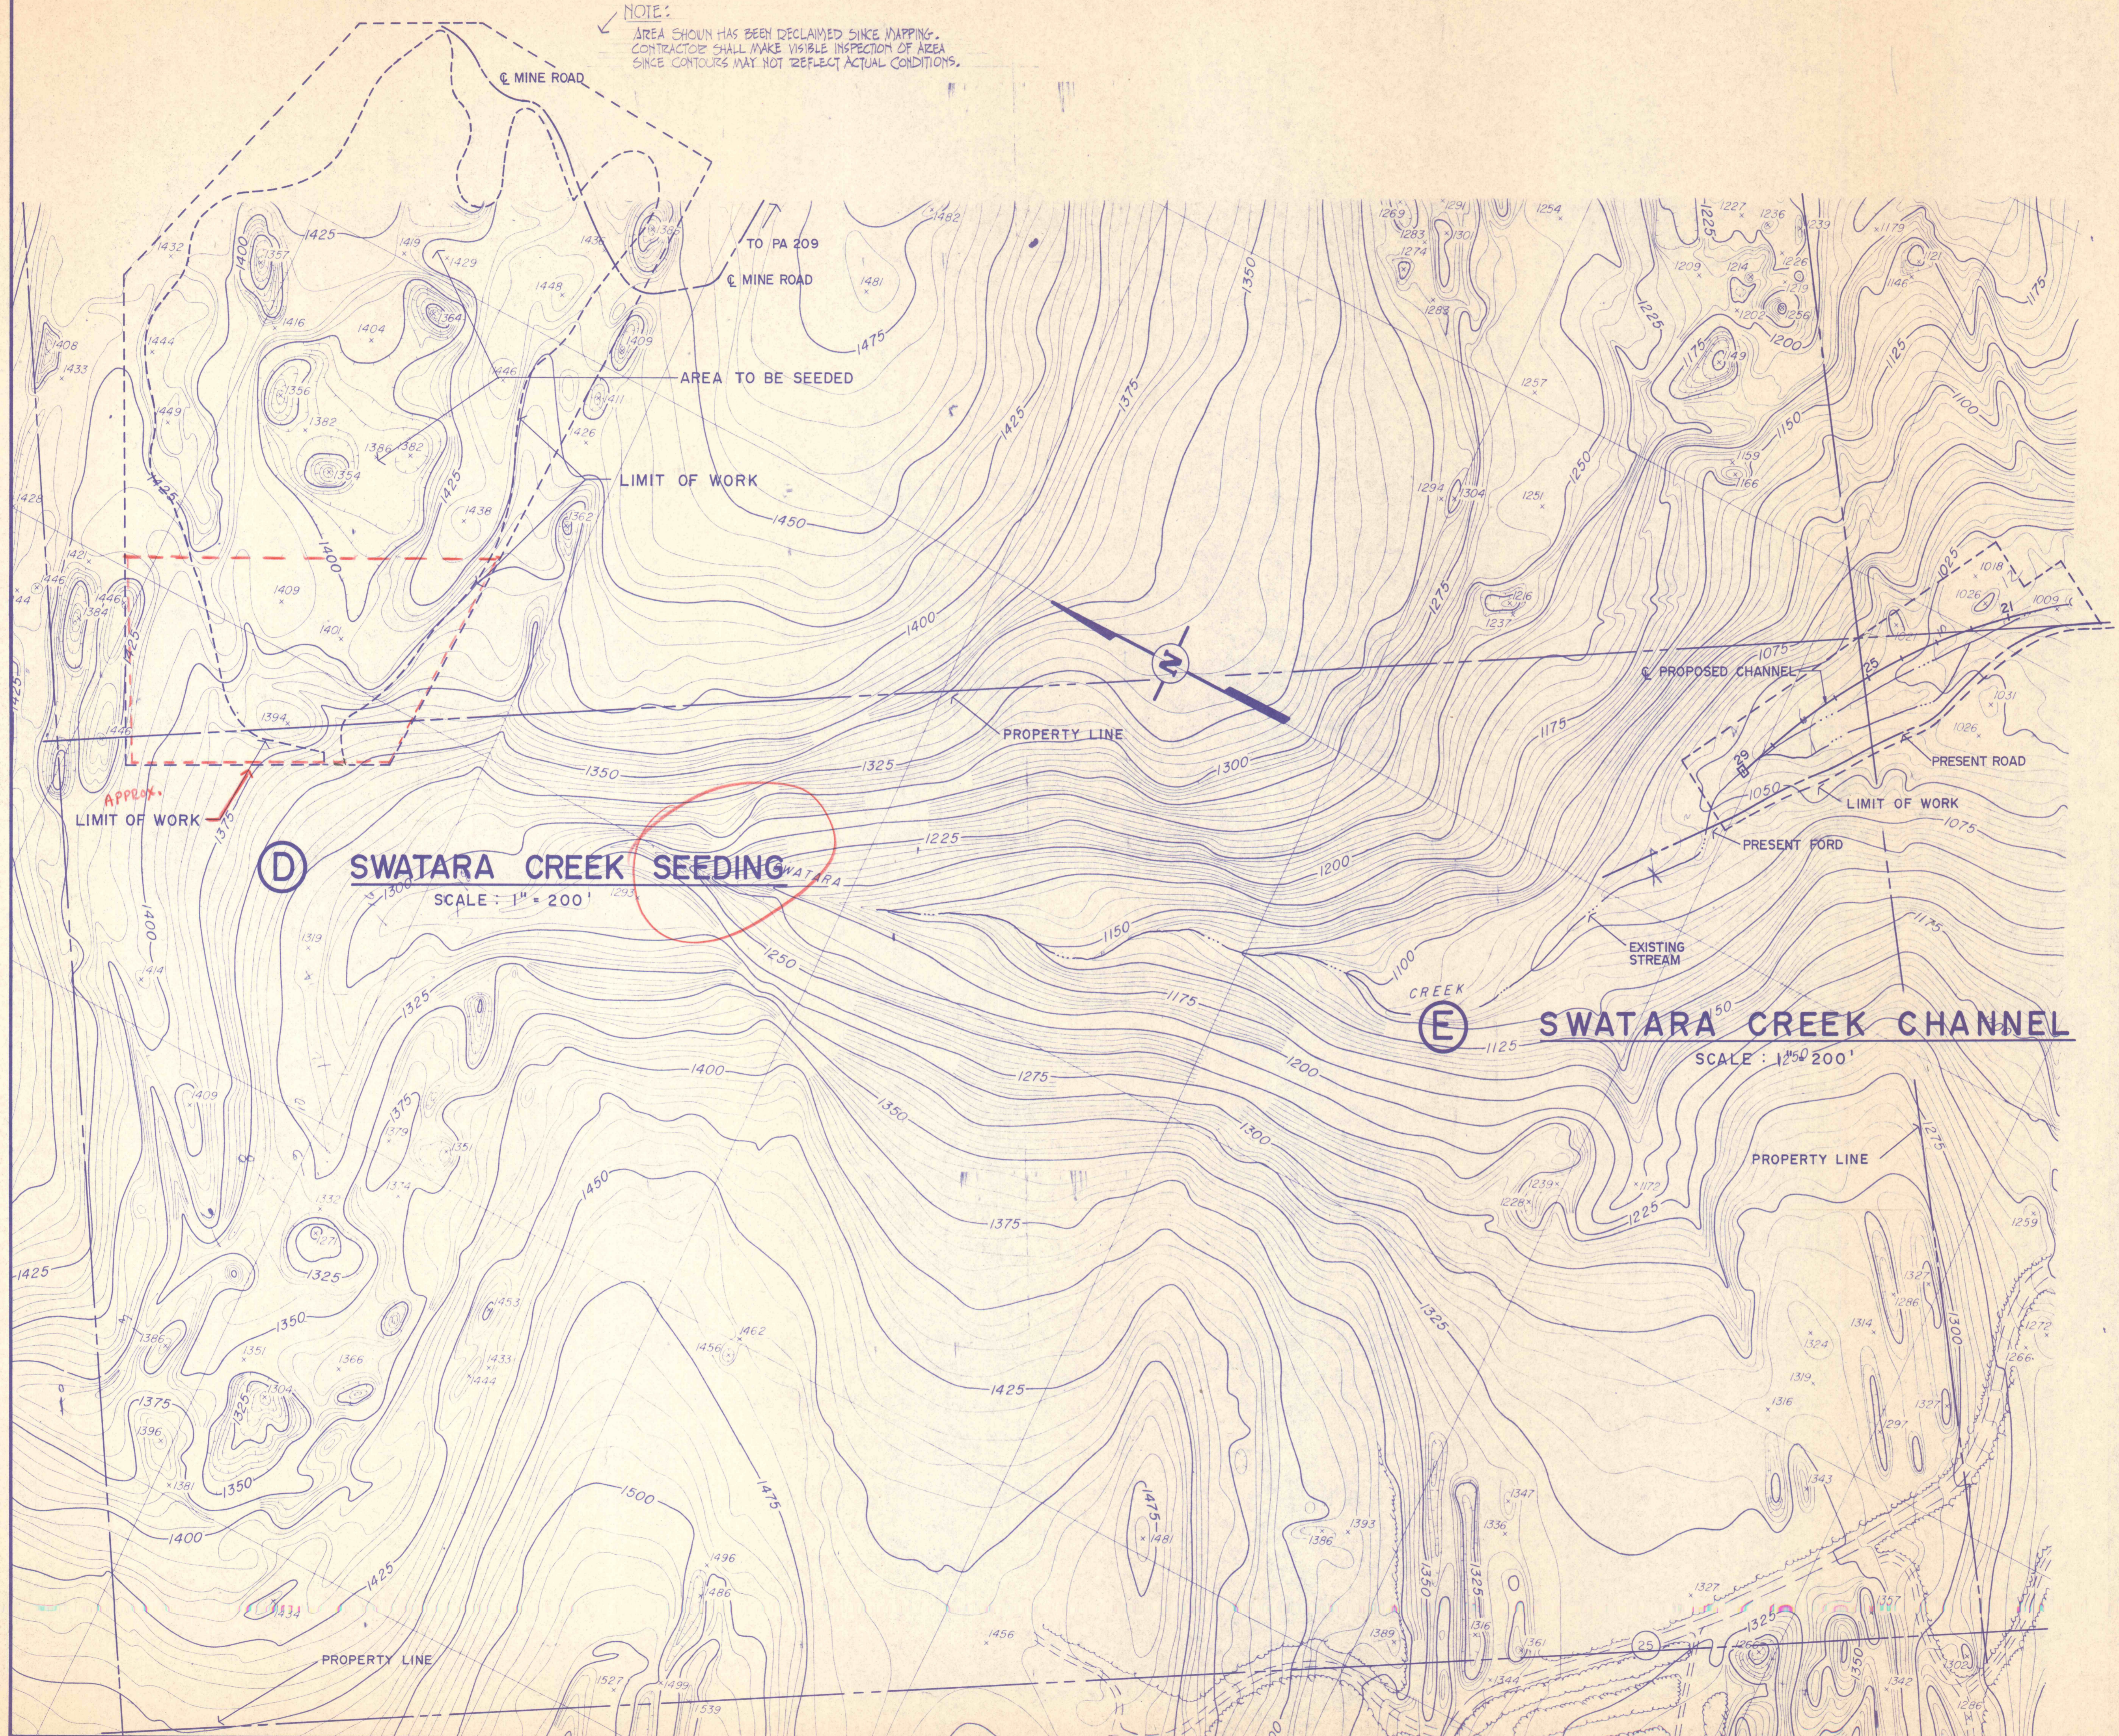

(D) SWATARA CREEK SEEDING
 SCALE: 1" = 200'

(E) SWATARA CREEK CHANNEL
 SCALE: 1" = 200'

NO.	DATE	REVISION	APPR.

COMMONWEALTH OF PENNSYLVANIA
 DEPARTMENT OF ENVIRONMENTAL RESOURCES
 OFFICE OF RESOURCES MANAGEMENT

PROJECT NO. SL-126-1-2

MINE DRAINAGE POLLUTION ABATEMENT
 SWATARA CREEK WATERSHED
 SCHUYLKILL COUNTY, PENNSYLVANIA

NICHOLAS-COWLEY-BROSCH ASSOC., INC.
 Consulting Engineers
 3300 North Third St. Harrisburg, Pa.

UPPER SWATARA CREEK PLAN

DRAWN BY BEN	DATE Jan. 11, 1974	DRAWING NO. 4 of 9
CHECKED BY HPC	SCALE As Shown	