
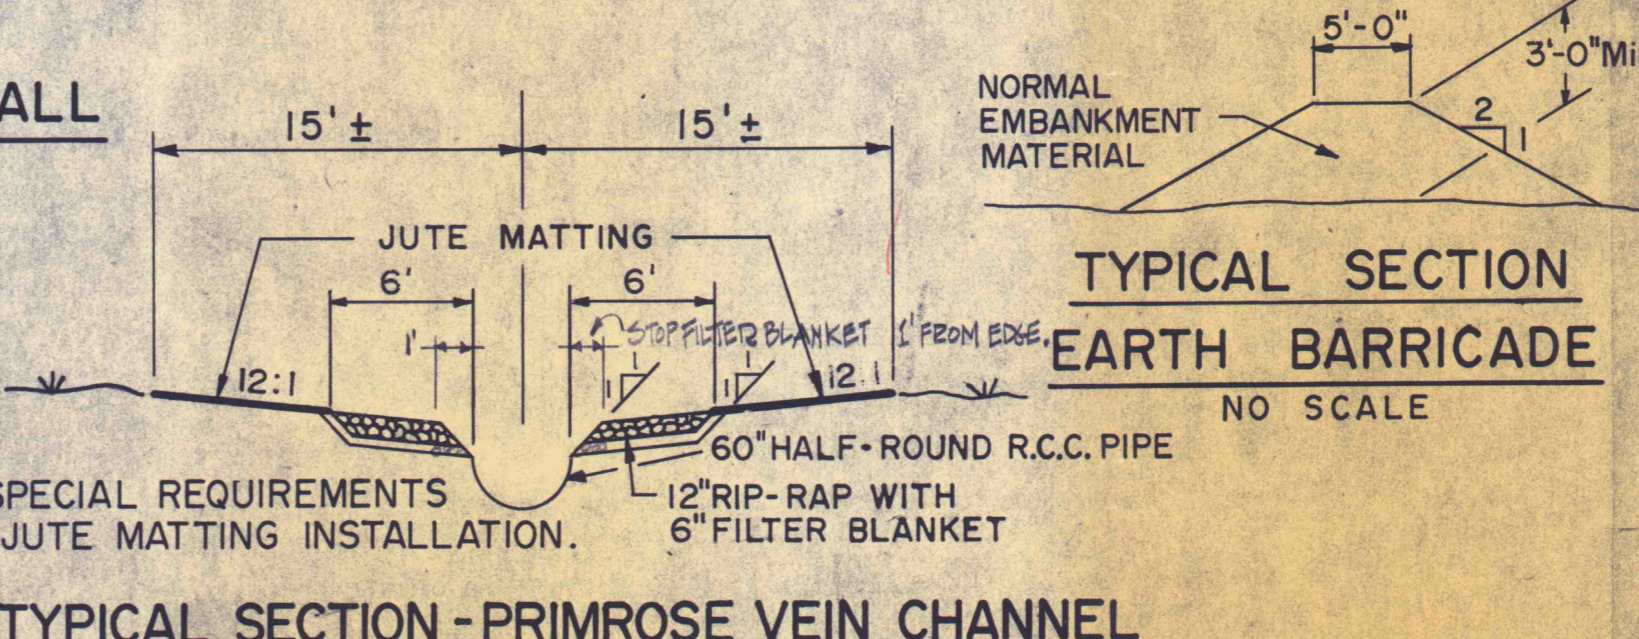
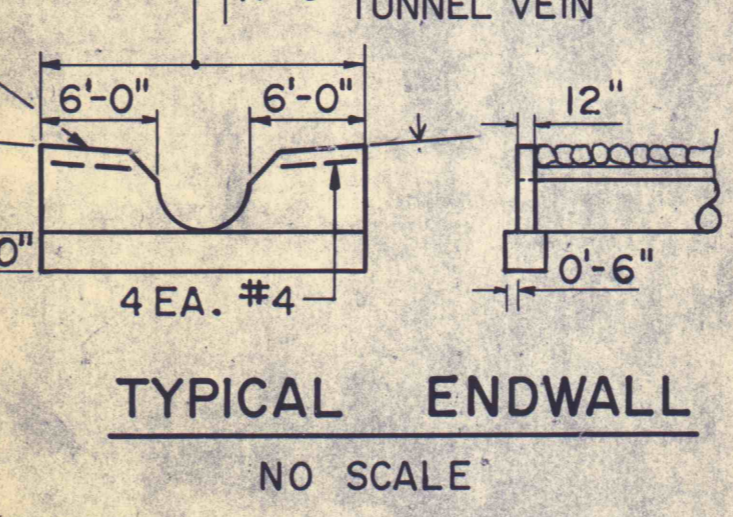
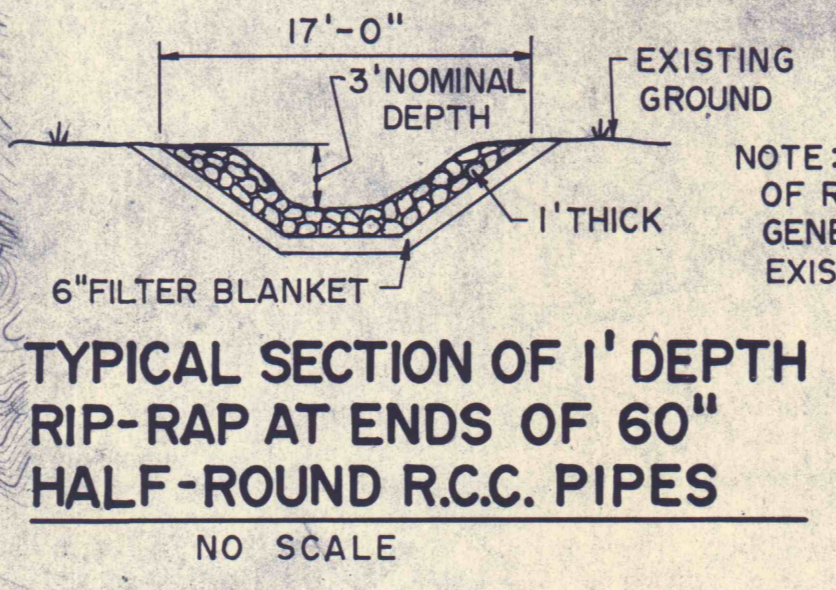
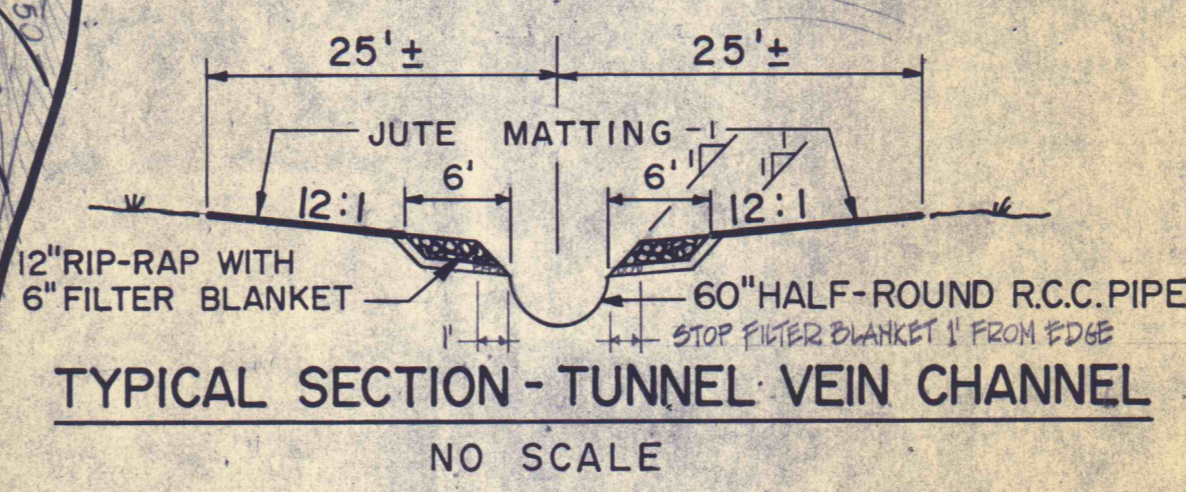
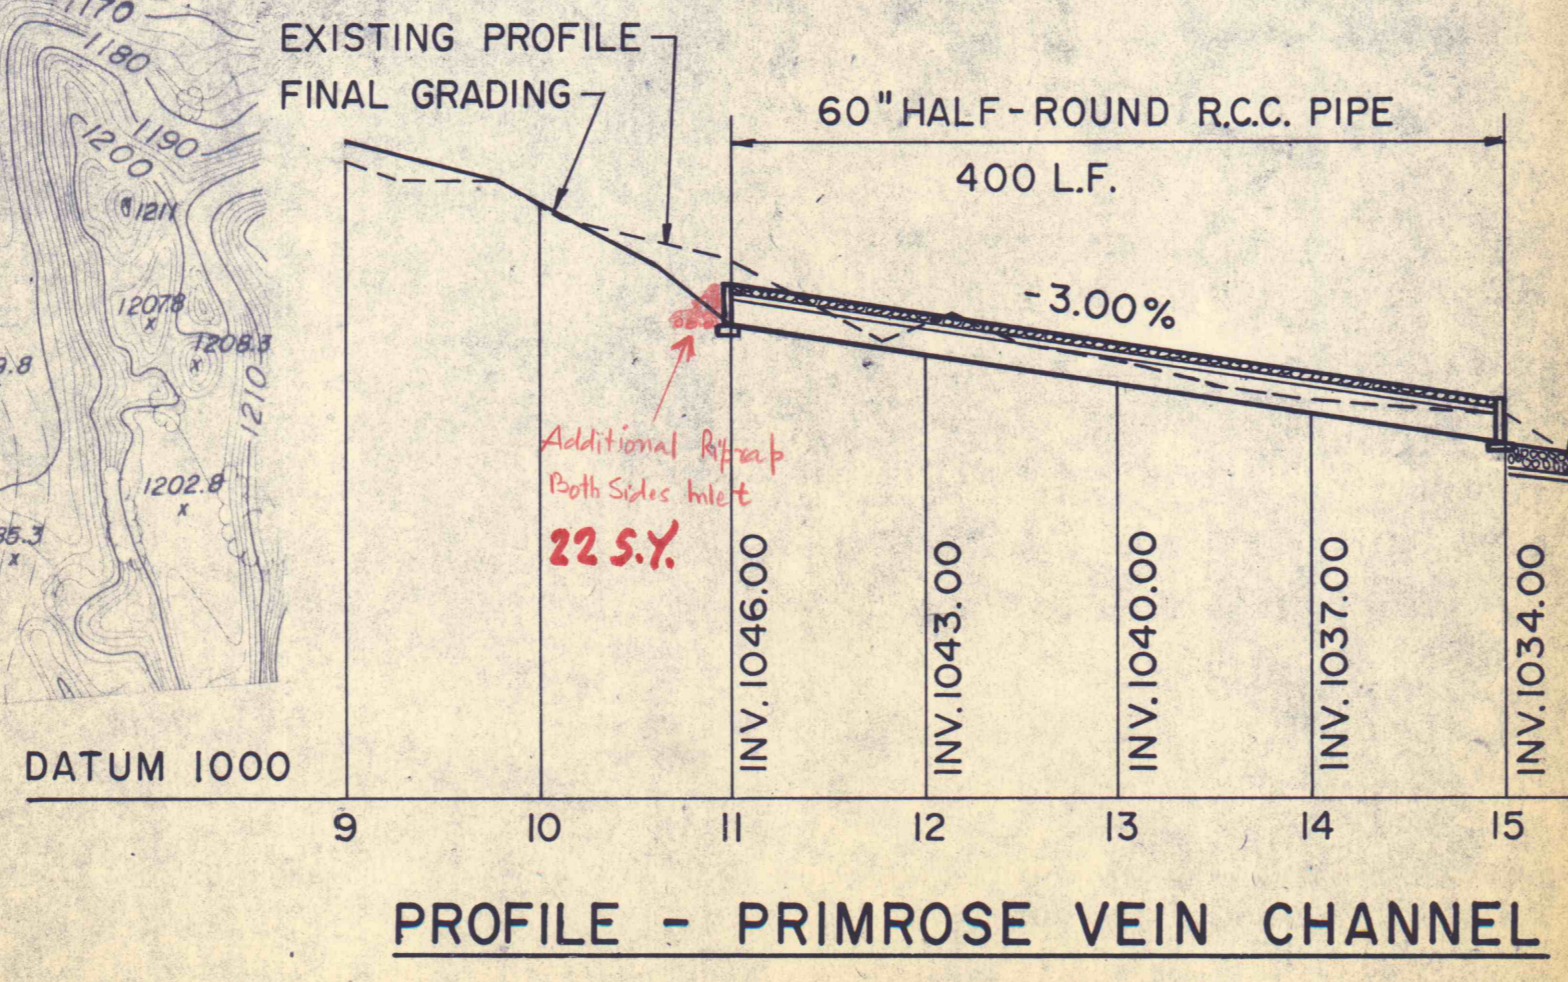


**A PRIMROSE VEIN CHANNEL**  
SCALE: 1" = 100'

**C TUNNEL VEIN CHANNEL**  
SCALE: 1" = 100'

**B PROVING PIT**  
SCALE: 1" = 100'

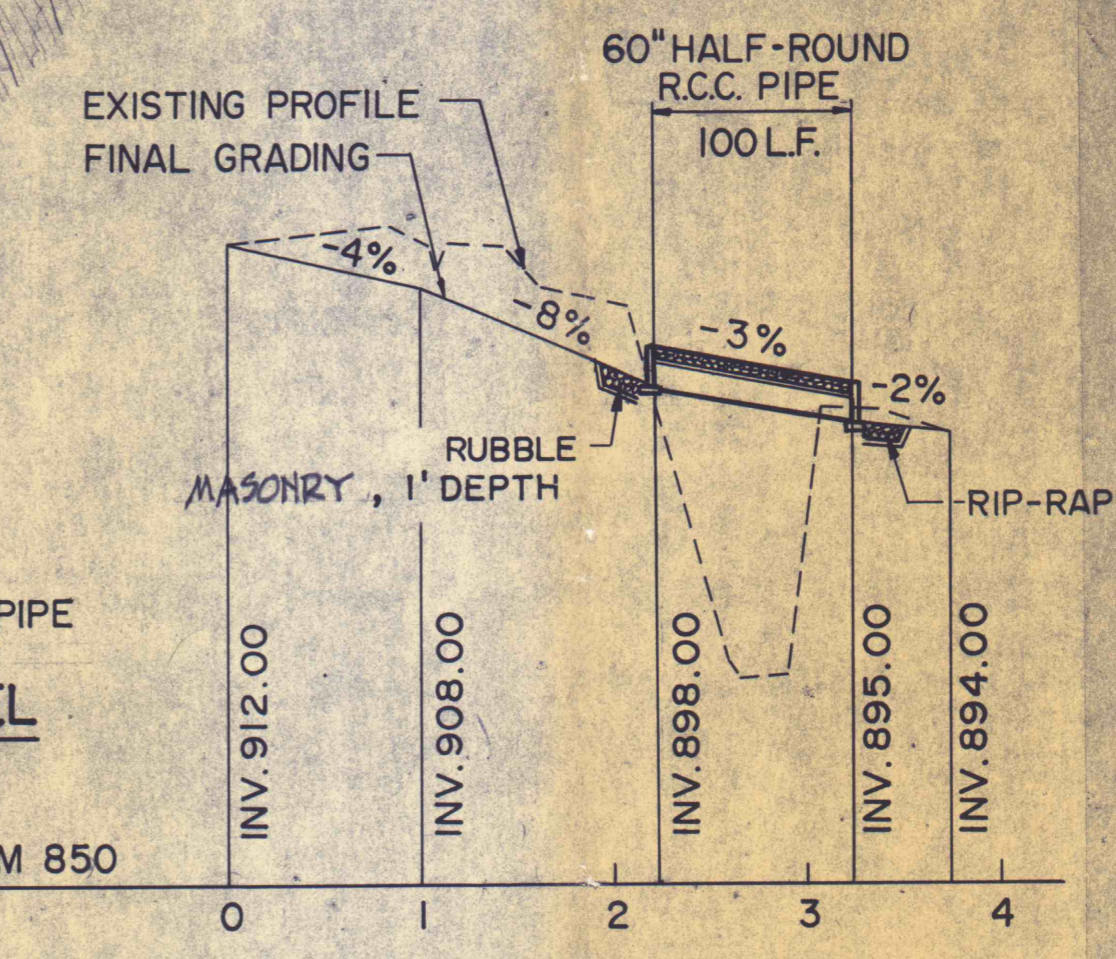

NO.	DATE	REVISION	APPR.

SUBMITTED: *Harvey P. Cowley*  
PROFESSIONAL

APPROVED: *Robert A. Roman*  
CHIEF - DIVISION OF MINE RECLAMATION

APPROVED: *Andrew...*  
DIRECTOR - BUREAU OF DESIGN

**COMMONWEALTH OF PENNSYLVANIA**  
DEPARTMENT OF ENVIRONMENTAL RESOURCES  
OFFICE OF RESOURCES MANAGEMENT

PROJECT NO. SL 126-1-5  
**MINE DRAINAGE POLLUTION ABATEMENT**  
SWATARA CREEK WATERSHED  
UPPER SWATARA CREEK & POLLY'S RUN  
REILLY TWP. SCHUYLKILL CO., PA.

NICHOLAS-COWLEY-BROSCH ASSOC., INC.  
Consulting Engineers  
3300 North Third St. Harrisburg, Pa.

**POLLY'S RUN**  
**PLAN & PROFILE**

DRAWN BY: BEN	DATE: Jan. 11, 1974	DRAWING NO.:
CHECKED BY: HPC	SCALE: As Shown	3 of 9

NOTE: TOPOGRAPHIC DATA OBTAINED FEBRUARY, 1973.