

LIST OF PROPERTY OWNERS

- 1 NATURAL COAL CO.
- 2 SCHUYLKILL COUNTY BOARD OF COMMISSIONERS
- 3 RENNINGER COAL CO.
- 4 JOHN & ALICE R. GRANITO
- 5 PAGNOTTI COAL CO.
- 6 PAGNOTTI COAL INTERESTS INC.
- 7 INDIAN HEAD COAL CO.
- 8 SULLIVAN TRAIL COAL CO.

LEGEND


- U.S. & State Rds. ———
 Twp. Rd. - - - - -
 Mine Rd. = = = = =
 Area to be Regraded
 Plan Sheet
 Property Owner

1	1-13-77	AS BUILT	
2	1-13-77	AS BUILT	
3	1-13-77	AS BUILT	
NO	DATE	REVISION	APPR.

SUBMITTED *Norman E. Mitchell*
 PROFESSIONAL

APPROVED *Robert C. Roman*
 CHIEF - DIVISION OF MINE DRAINAGE REHABILITATION

APPROVED *John Penney*
 DIRECTOR - BUREAU OF CONSULTING SERVICES

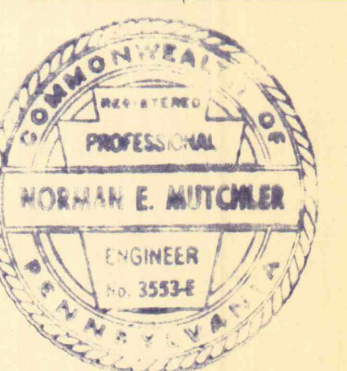

COMMONWEALTH OF PENNSYLVANIA
 DEPARTMENT OF ENVIRONMENTAL RESOURCES
 OFFICE OF ENGINEERING AND CONSTRUCTION

PROJECT NO. SL-126-2-7

MINE DRAINAGE
 POLLUTION ABATEMENT
 SWATARA CREEK WATERSHED
 SCHUYLKILL COUNTY

BERGER ASSOCIATES, INC.
 Consulting Engineers
 P.O. Box 1943 Harrisburg, Penna.

INDEX MAP

DRAWN BY W. G.	DATE APR. 17, 1973	DRAWING NO. 3 of 43
CHECKED BY M. W.	SCALE 1" = 800'	