


SEE SHEET NO. 6

SEE SHEET NO. 7

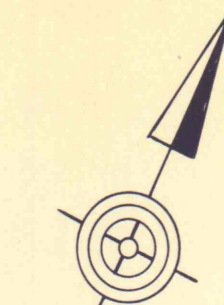

⚠ Entire Sheet Deleted

SEE SHEET NO. 14

For Grading Sections
See Sheet Nos 36 & 37

NO	DATE	REVISION	APPR.
SUBMITTED			
Norman E. Mutchler			
PROFESSIONAL			
APPROVED			
Albert A. Rameci			
CHIEF - DIVISION OF MINE DRAINAGE REHABILITATION			
APPROVED			
D. J. Penzo			
DIRECTOR - BUREAU OF CONSULTING SERVICES			



COMMONWEALTH OF PENNSYLVANIA
DEPARTMENT OF ENVIRONMENTAL RESOURCES
OFFICE OF ENGINEERING AND CONSTRUCTION


PROJECT NO. SL-126-2-7

MINE DRAINAGE
POLLUTION ABATEMENT
SWATARA CREEK WATERSHED
SCHUYLKILL COUNTY

BERGER ASSOCIATES, INC.
Consulting Engineers
P.O. Box 1943 Harrisburg, Penna.

PLAN
STRIP MINE RECLAMATION

DRAWN BY	DATE	DRAWING NO.
W. G.	APR. 17, 1973	
CHECKED BY	SCALE	13 of 43
T. T.	1" = 100'	

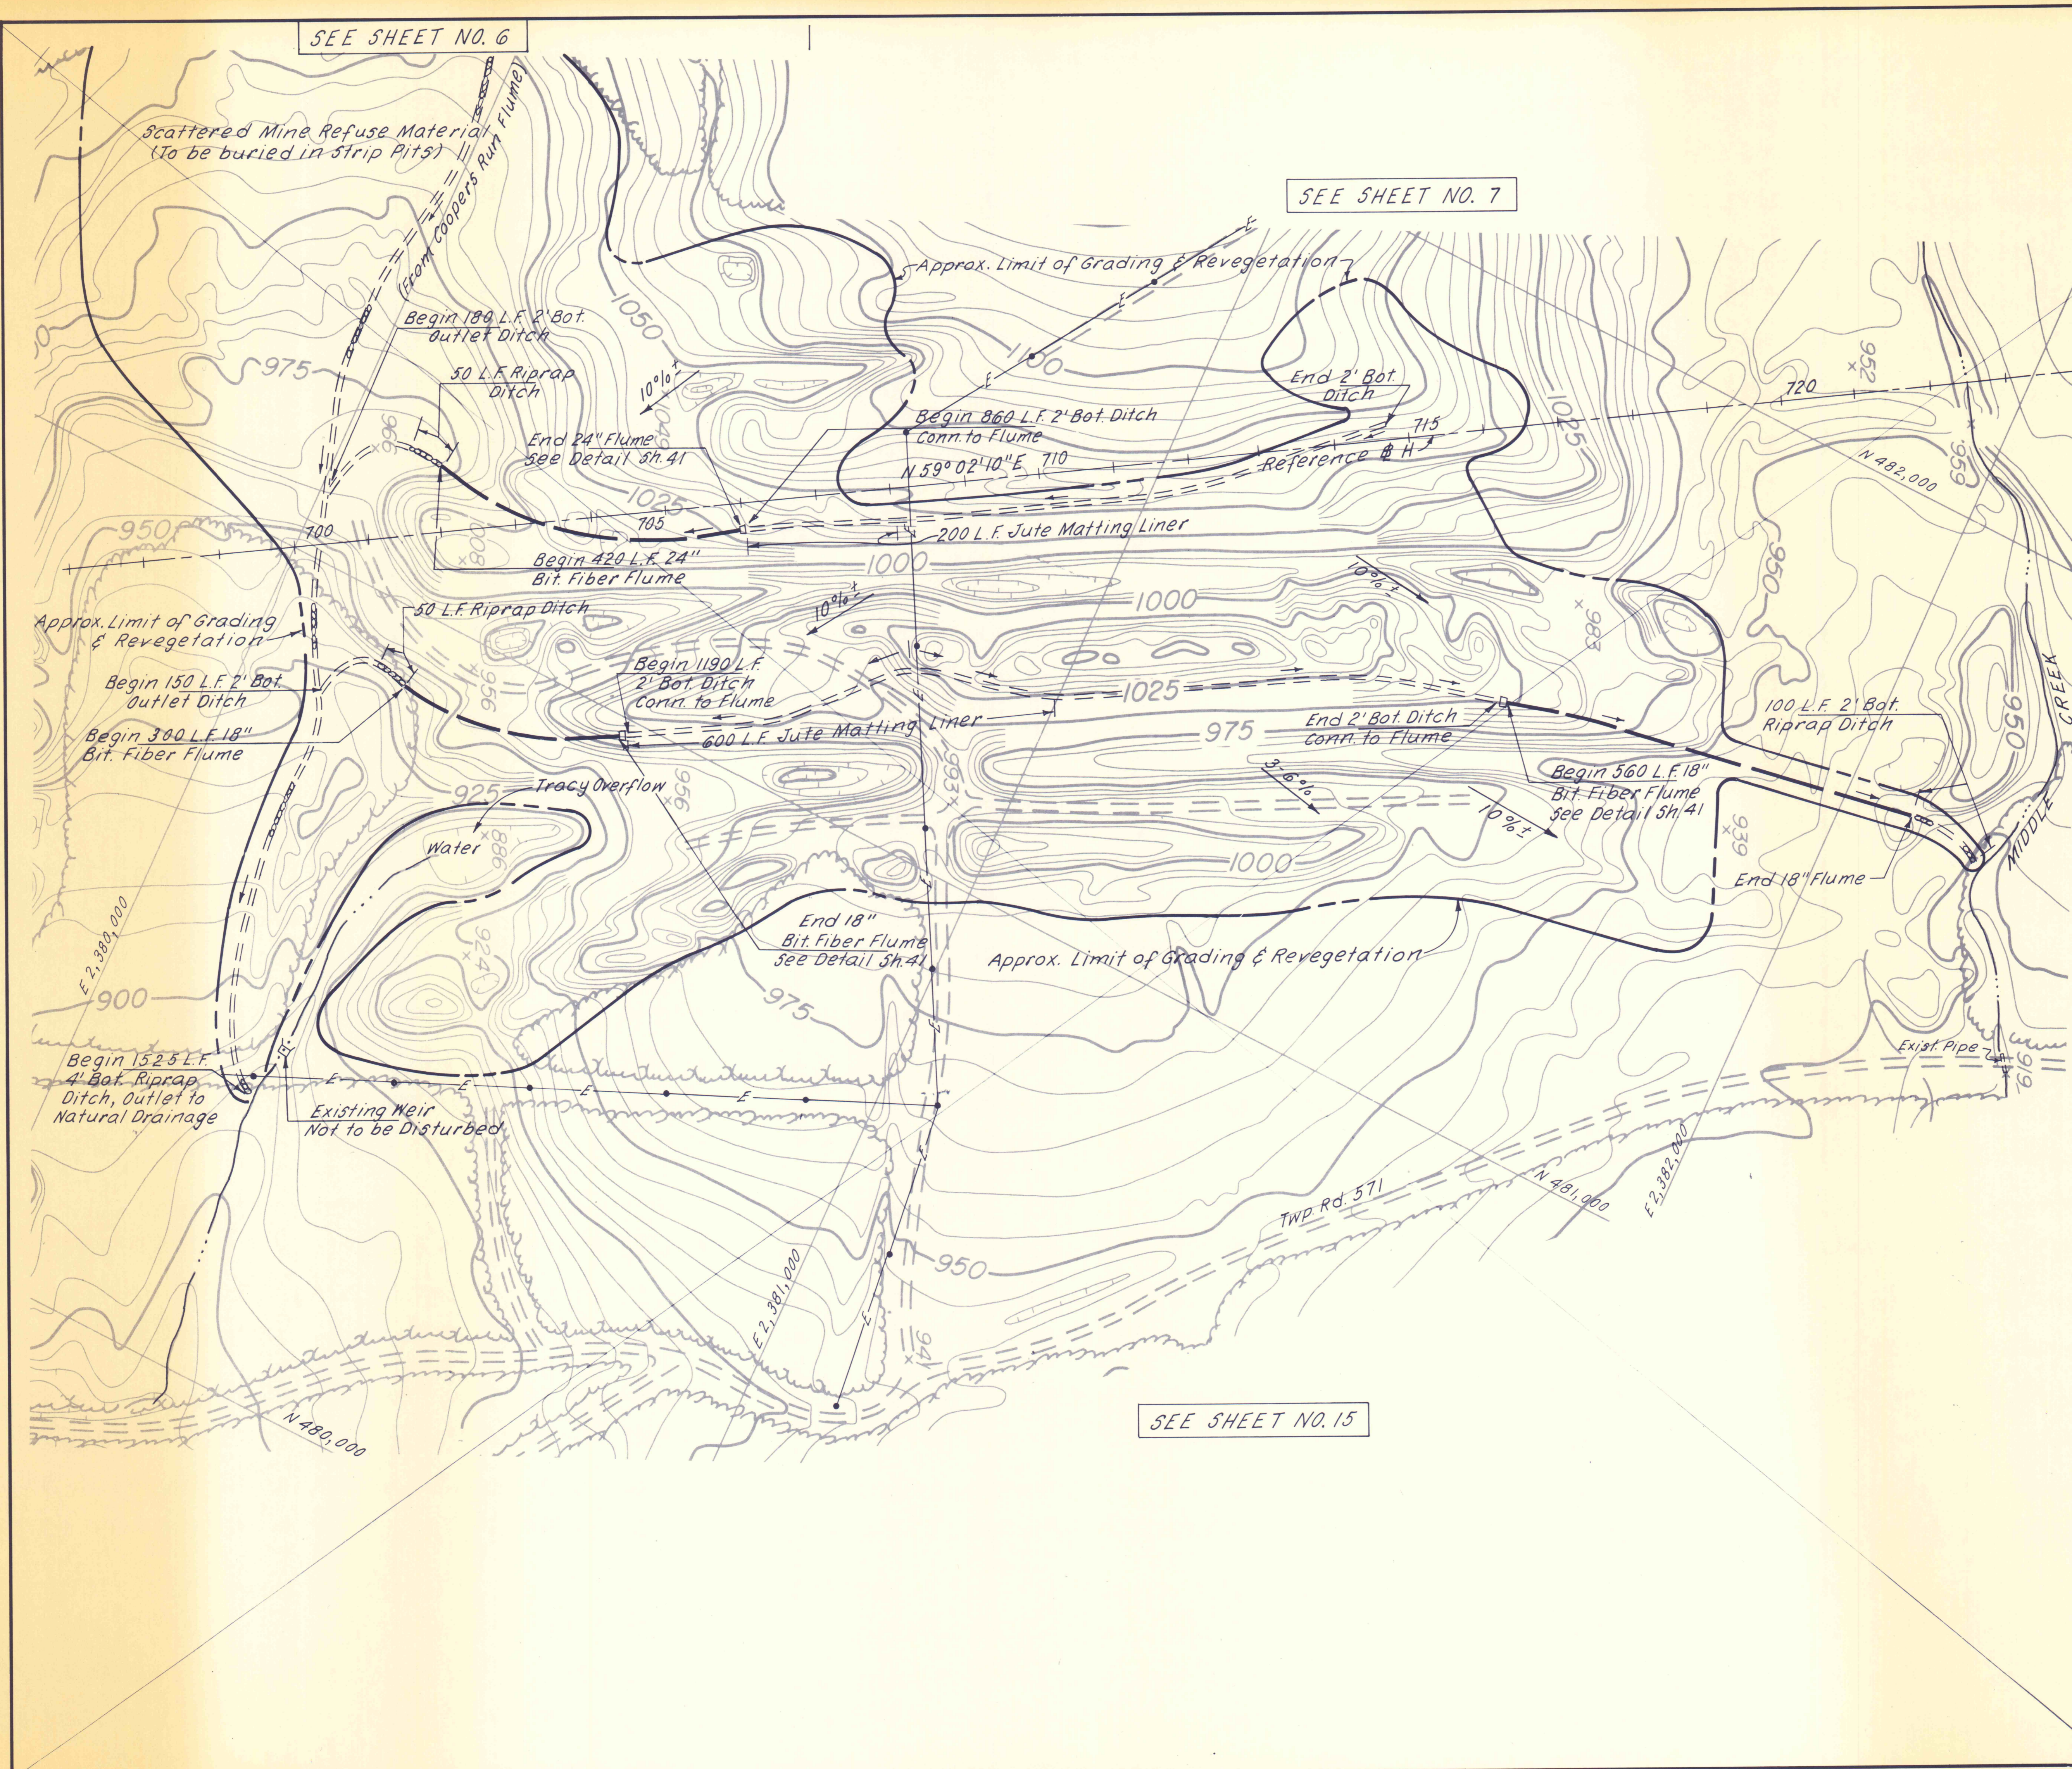

SEE SHEET NO. 15