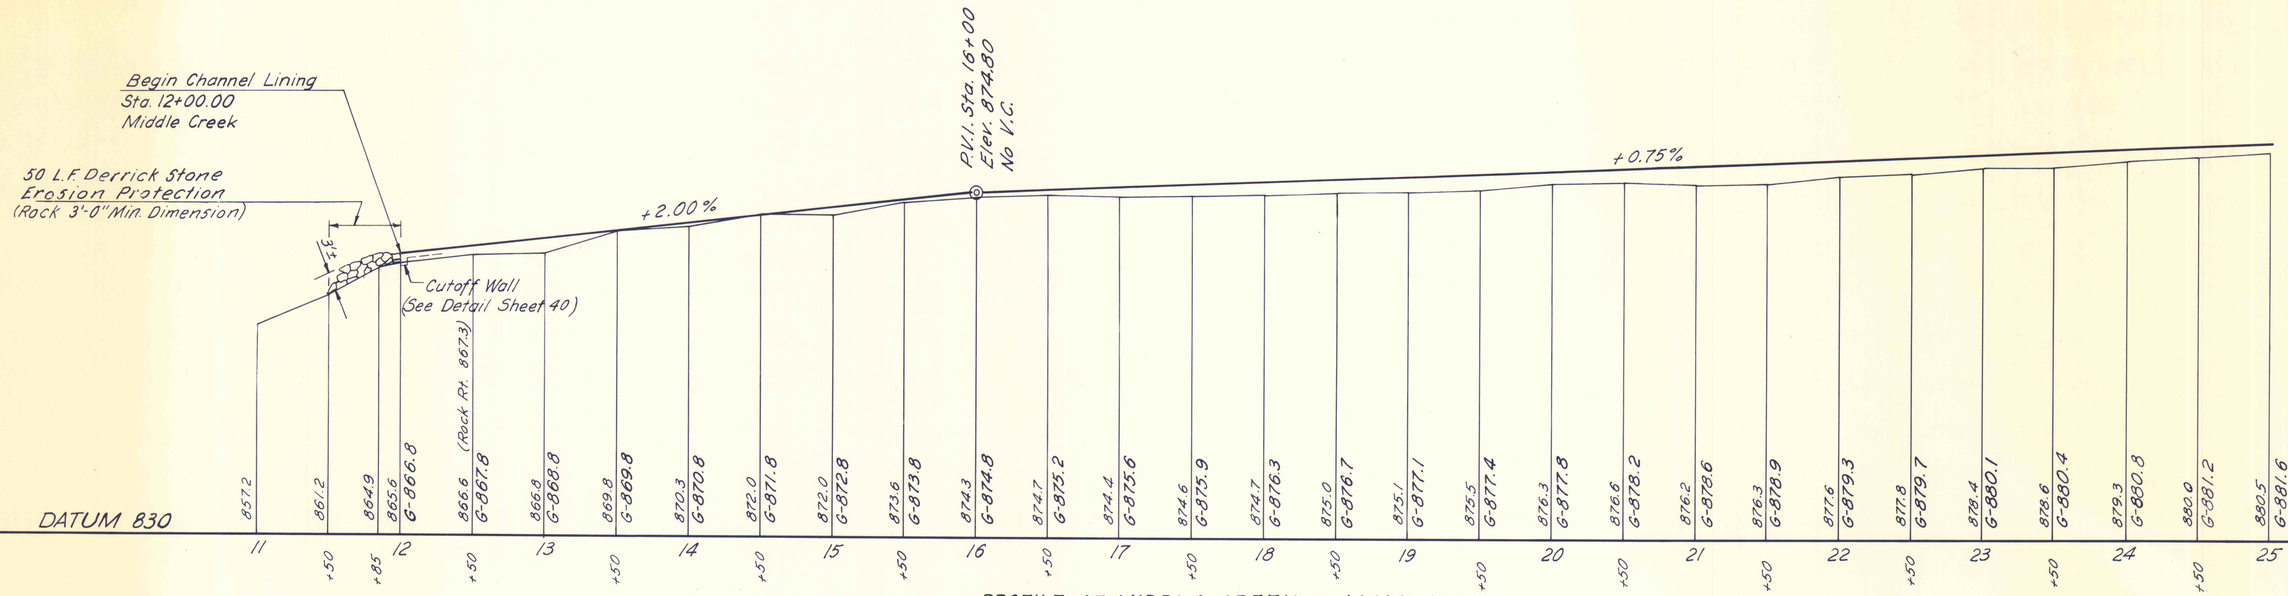

PROFILE OF MIDDLE CREEK CHANNEL LINING

Scale: Hor. 1" = 50'
Vert. 1" = 10'

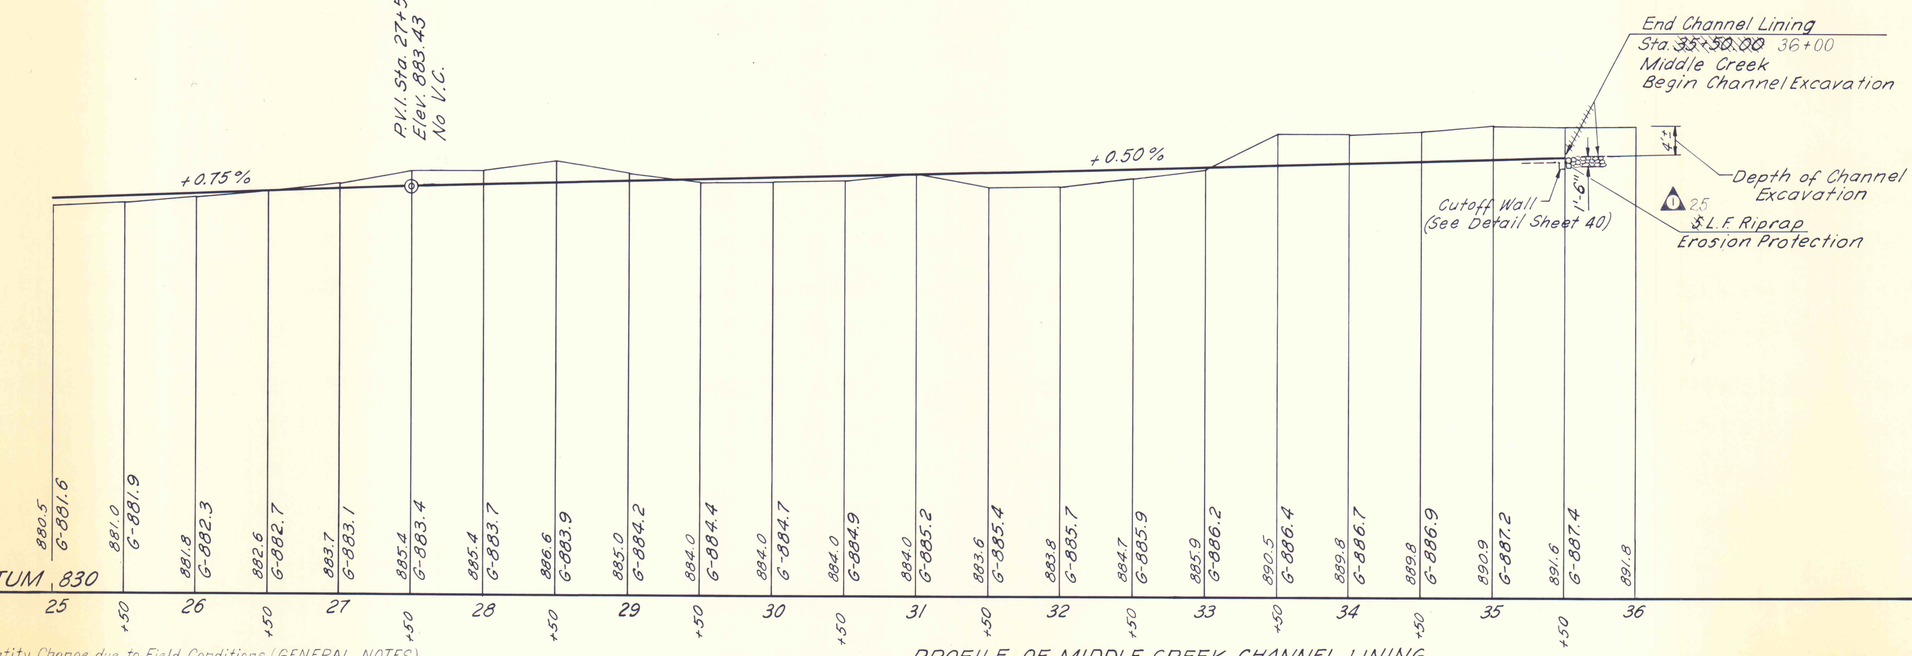

PROFILE OF MIDDLE CREEK CHANNEL LINING

25 Quantity Change due to Field Conditions (GENERAL NOTES)

NO	DATE	REVISION	APPR.
1	1-13-77	AS BUILT	

SUBMITTED Norman E. Mutchler
PROFESSIONAL

APPROVED Calvert A. Romani
CHIEF - DIVISION OF MINE DRAINAGE REHABILITATION

APPROVED J. DuPerron
DIRECTOR - BUREAU OF CONSULTING SERVICES

COMMONWEALTH OF PENNSYLVANIA
REGISTERED PROFESSIONAL
NORMAN E. MUTCHLER
ENGINEER
33334
STATE OF PENNSYLVANIA

COMMONWEALTH OF PENNSYLVANIA
DEPARTMENT OF ENVIRONMENTAL RESOURCES
OFFICE OF ENGINEERING AND CONSTRUCTION

PROJECT NO. SL-126-2-7

MINE DRAINAGE
POLLUTION ABATEMENT
SWATARA CREEK WATERSHED
SCHUYLKILL COUNTY

BERGER ASSOCIATES, INC.
Consulting Engineers
P.O. Box 1943 Harrisburg, Penna.

PROFILE
MIDDLE CREEK CHANNEL LINING

DRAWN BY	DATE	DRAWING NO.
W. G.	APR. 17, 1973	20 of 43
CHECKED BY	SCALE	
M. W.	AS SHOWN	