


1-13-77	AS BUILT		
NO	DATE	REVISION	APPR.
PROFESSIONAL			
APPROVED	Albert A. Ramei		
CHIEF - DIVISION OF MINE DRAINAGE REHABILITATION			
APPROVED	D. W. [Signature]		
DIRECTOR - BUREAU OF CONSULTING SERVICES			

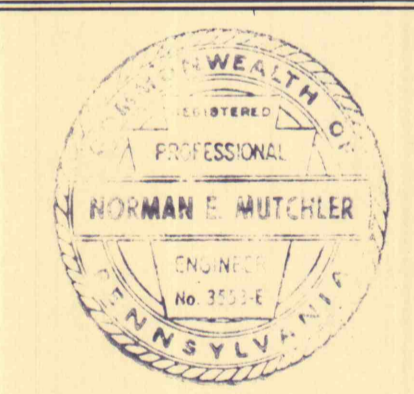

COMMONWEALTH OF PENNSYLVANIA
 DEPARTMENT OF ENVIRONMENTAL RESOURCES
 OFFICE OF ENGINEERING AND CONSTRUCTION

PROJECT NO. SL-126-2-7

MINE DRAINAGE
 POLLUTION ABATEMENT
 SWATARA CREEK WATERSHED
 SCHUYLKILL COUNTY

BERGER ASSOCIATES, INC.
 Consulting Engineers
 P.O. Box 1943 Harrisburg, Penna.

DRAWING NO.		34 of 43
DRAWN BY W. G.	DATE APR. 17, 1973	
CHECKED BY M. W.	SCALE 1" = 100'	