

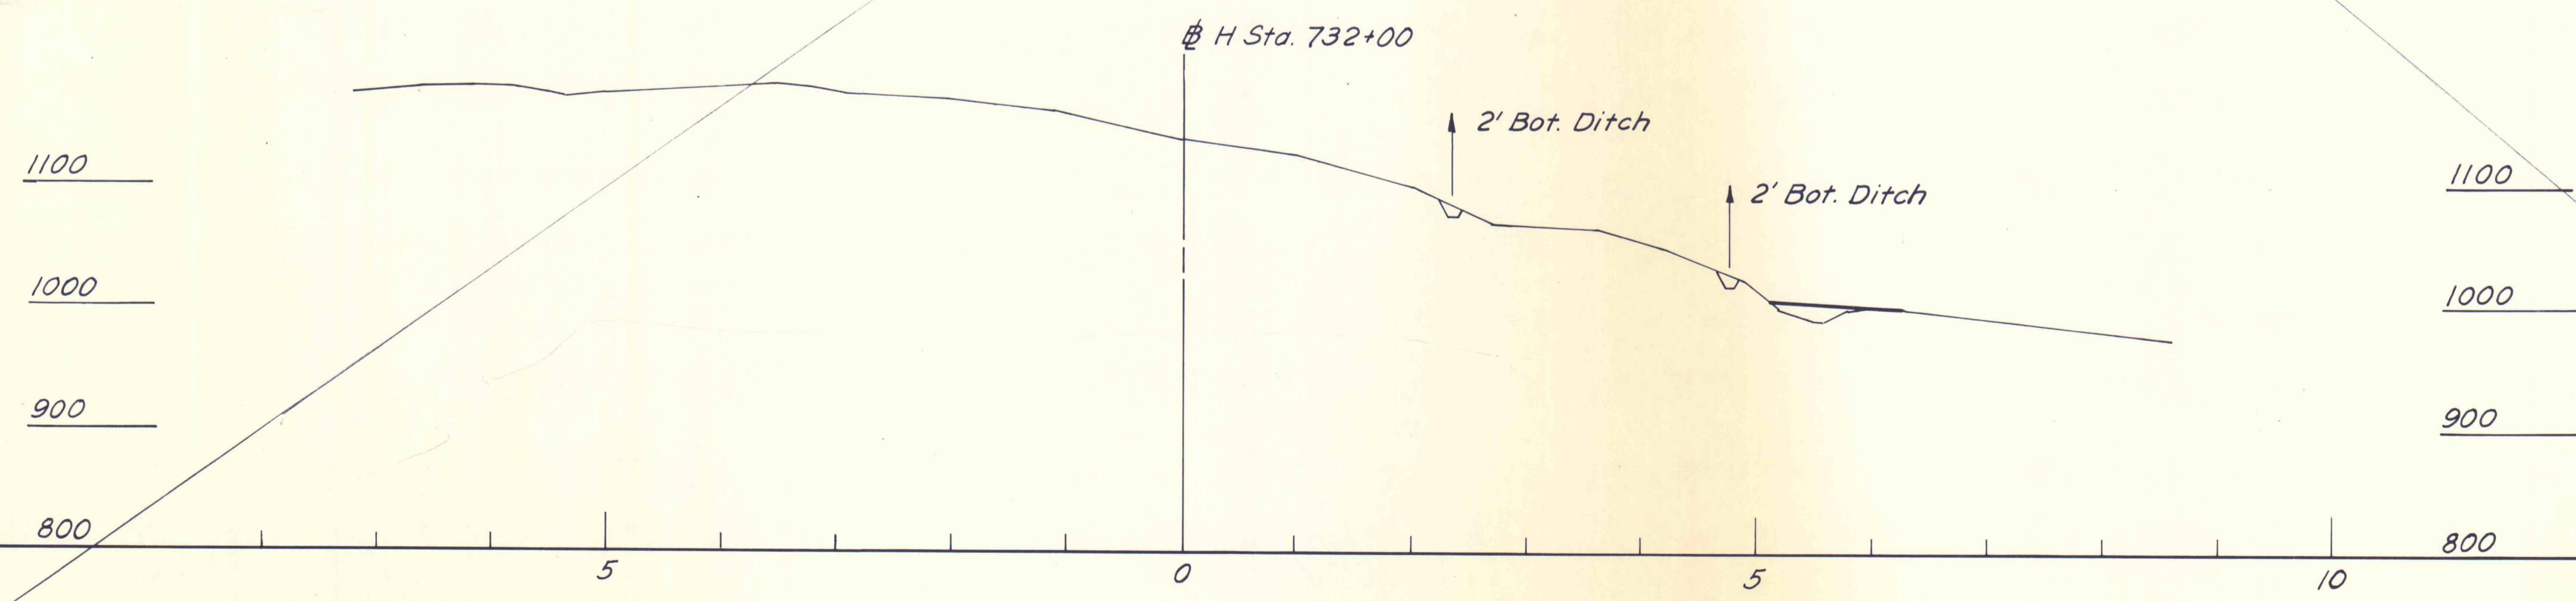


Entire Sheet Deleted

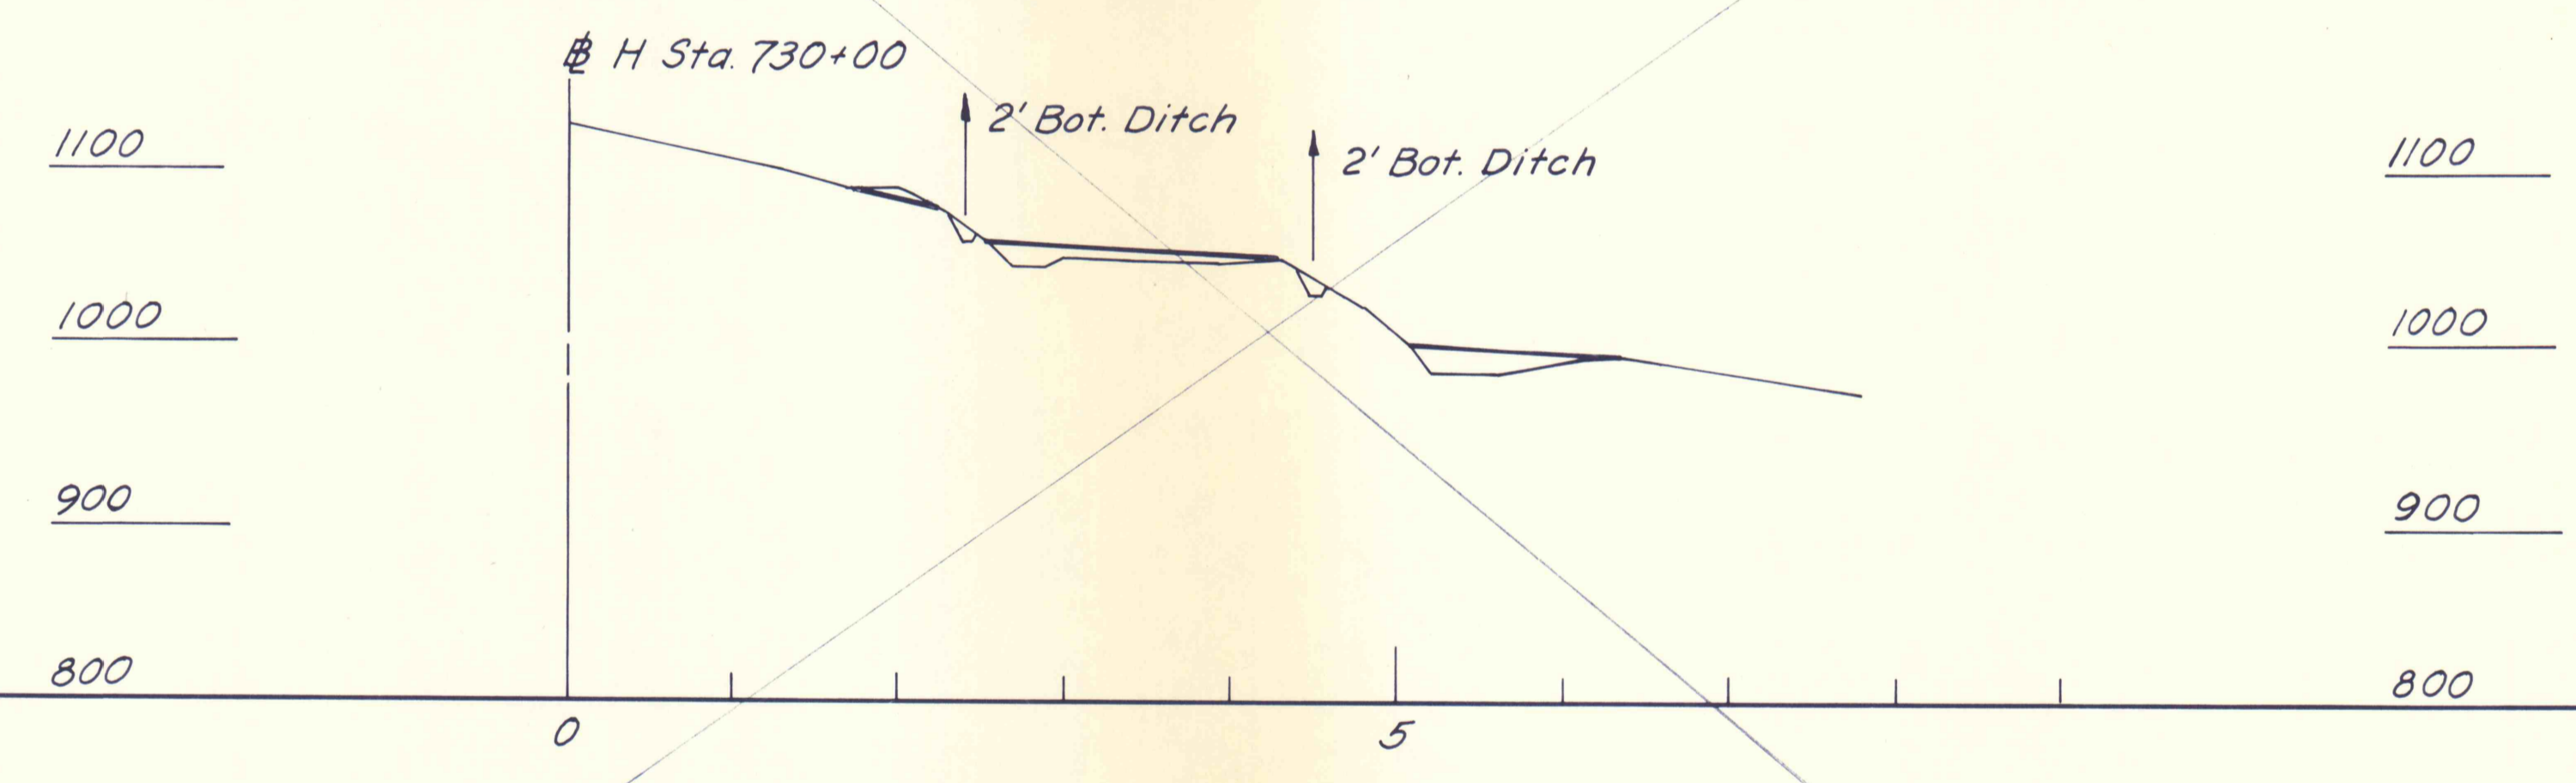

|  |                    |          |       |
|--|--------------------|----------|-------|
| NO.  | DATE               | REVISION | APPR. |
|  |                    |          |       |
| SUBMITTED  | Norman E. Mitchell |          |       |
| PROFESSIONAL                                     |                    |          |       |
| APPROVED   | Robert C. Ranieri  |          |       |
| CHIEF - DIVISION OF MINE DRAINAGE REHABILITATION |                    |          |       |
| APPROVED   | duPena             |          |       |
| DIRECTOR - BUREAU OF CONSULTING SERVICES         |                    |          |       |

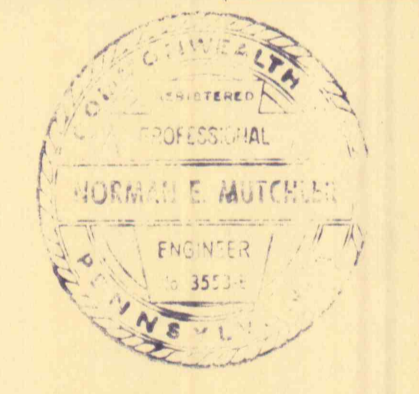

COMMONWEALTH OF PENNSYLVANIA  
DEPARTMENT OF ENVIRONMENTAL RESOURCES  
OFFICE OF ENGINEERING AND CONSTRUCTION

PROJECT NO. SL-126-2-7

MINE DRAINAGE  
POLLUTION ABATEMENT  
SWATARA CREEK WATERSHED  
SCHUYLKILL COUNTY

BERGER ASSOCIATES, INC.  
Consulting Engineers

P.O. Box 1943 Harrisburg, Penna.

GRADING SECTIONS

|                     |                       |                         |
|---------------------|-----------------------|-------------------------|
| DRAWN BY<br>W. G.   | DATE<br>APR. 17, 1973 | DRAWING NO.<br>37 of 43 |
| CHECKED BY<br>M. W. | SCALE<br>1" = 100'    |                         |