


▲ Coopers Run Flume Deleted from Project

1-13-77	AS BUILT		
NO	DATE	REVISION	APPR.
SUBMITTED		Norman E. Mutchler	
APPROVED		Robert A. Roman	
APPROVED		DuPreez	

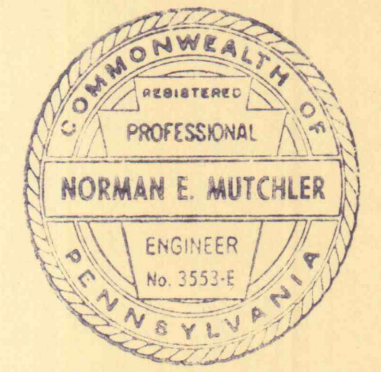

COMMONWEALTH OF PENNSYLVANIA
DEPARTMENT OF ENVIRONMENTAL RESOURCES
OFFICE OF ENGINEERING AND CONSTRUCTION

PROJECT NO. SL-126-2-7

MINE DRAINAGE
POLLUTION ABATEMENT
SWATARA CREEK WATERSHED
SCHUYLKILL COUNTY

BERGER ASSOCIATES, INC.
Consulting Engineers
P.O. Box 1943 Harrisburg, Penna.

**DETAILS OF 48" FLUME
COOPERS RUN**

DRAWN BY W.G.	DATE APR. 17, 1973	DRAWING NO. 42 of 43
CHECKED BY M.W.	SCALE AS SHOWN	

* If large rock or unsuitable material is encountered during bedding preparation, excavate mat'l. and backfill to grade with suitable granular spoil.