
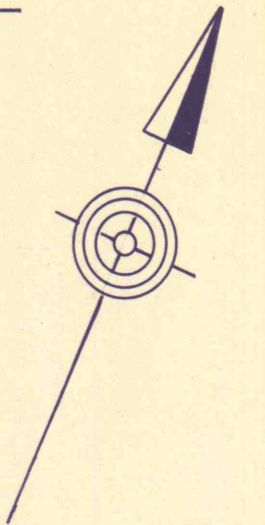


SEE SHEET NO. 11

SEE SHEET NO. 12

SEE SHEET NO. 7

SEE SHEET NO. 14

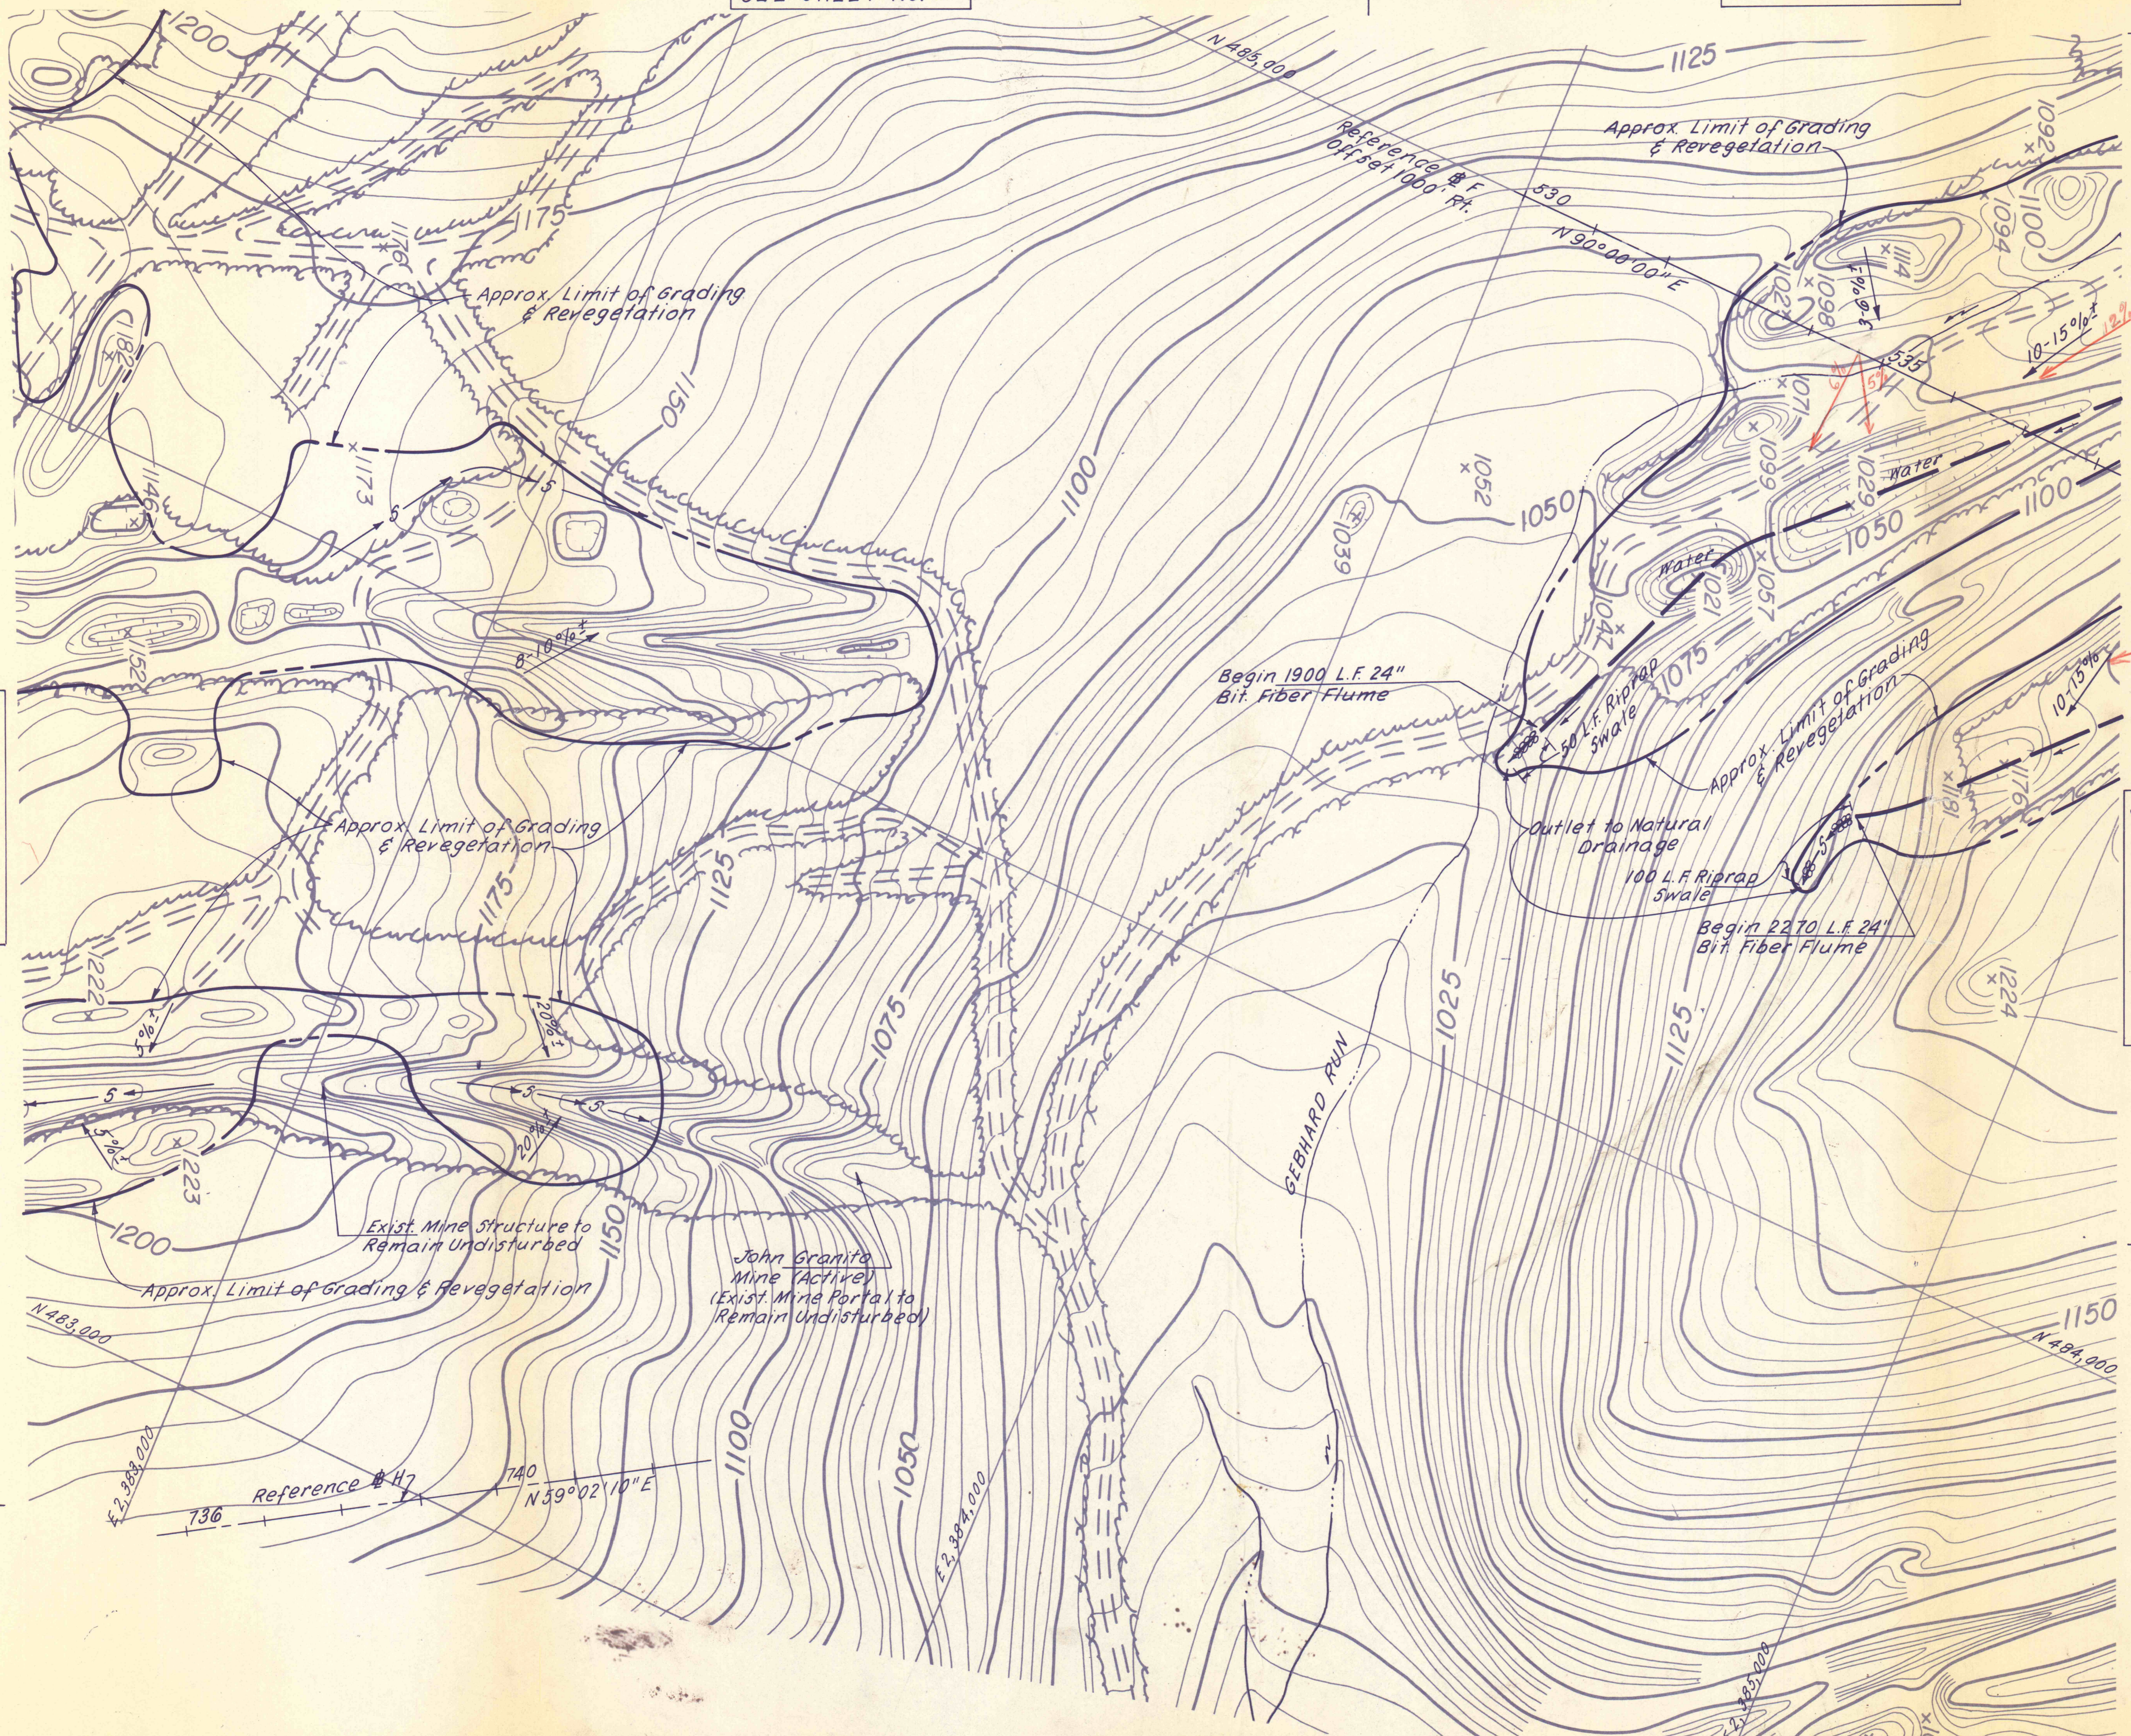


SEE SHEET NO. 10

For Grading Sections See Sheet No. 32 & 38

NO	DATE	REVISION	APPR.

SUBMITTED *Norman E. Mutchler*
PROFESSIONAL
APPROVED *Robert G. Panner*
CHIEF - DIVISION OF MINE DRAINAGE REHABILITATION
APPROVED *Bob Penner*
DIRECTOR - BUREAU OF CONSULTING SERVICES

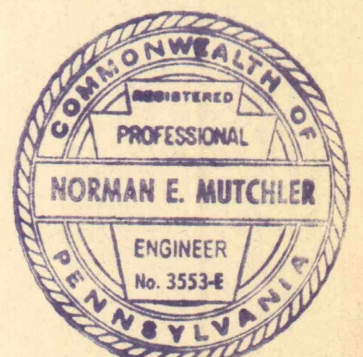

COMMONWEALTH OF PENNSYLVANIA
DEPARTMENT OF ENVIRONMENTAL RESOURCES
OFFICE OF ENGINEERING AND CONSTRUCTION

PROJECT NO. SL-126-2-7

MINE DRAINAGE
POLLUTION ABATEMENT
SWATARA CREEK WATERSHED
SCHUYLKILL COUNTY

BERGER ASSOCIATES, INC.
Consulting Engineers

P.O. Box 1943 Harrisburg, Pa

PLAN STRIP MINE RECLAMATI

DRAWN BY W.G.	DATE APR. 17, 1973	DRAWING NO. 9 of 4
CHECKED BY T.T.	SCALE 1" = 100'	

See sheet