


PLAN OF DISSIPATOR DITCH "A" - STATION 52+00

SCALE - 1/4" = 1'-0"

PLAN OF DISSIPATOR DITCH "B" - STATION 15+26


SCALE - 1/4" = 1'-0"

NOTE: ALL EXPOSED CONCRETE EDGES TO RECEIVE A 1" CHAMFER.

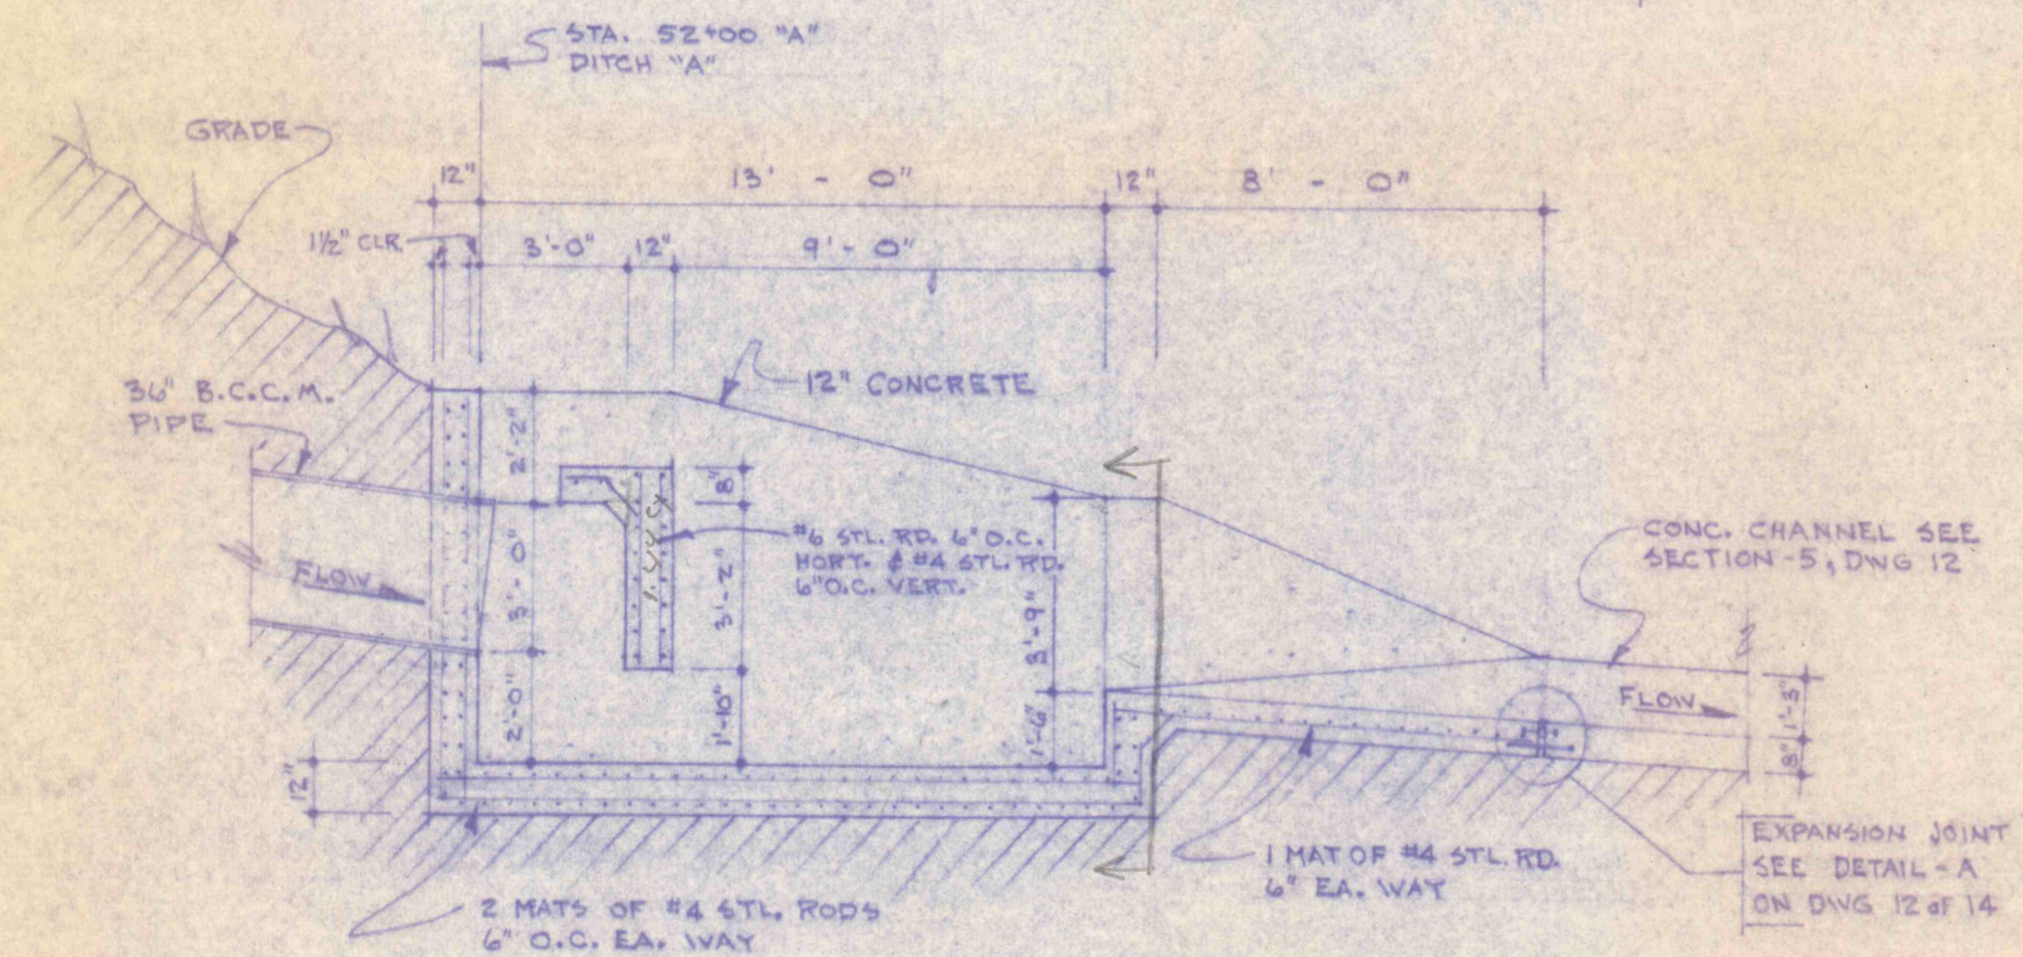

SECTION OF DISSIPATOR DITCH "A" - STATION 52+00

SCALE - 1/4" = 1'-0"

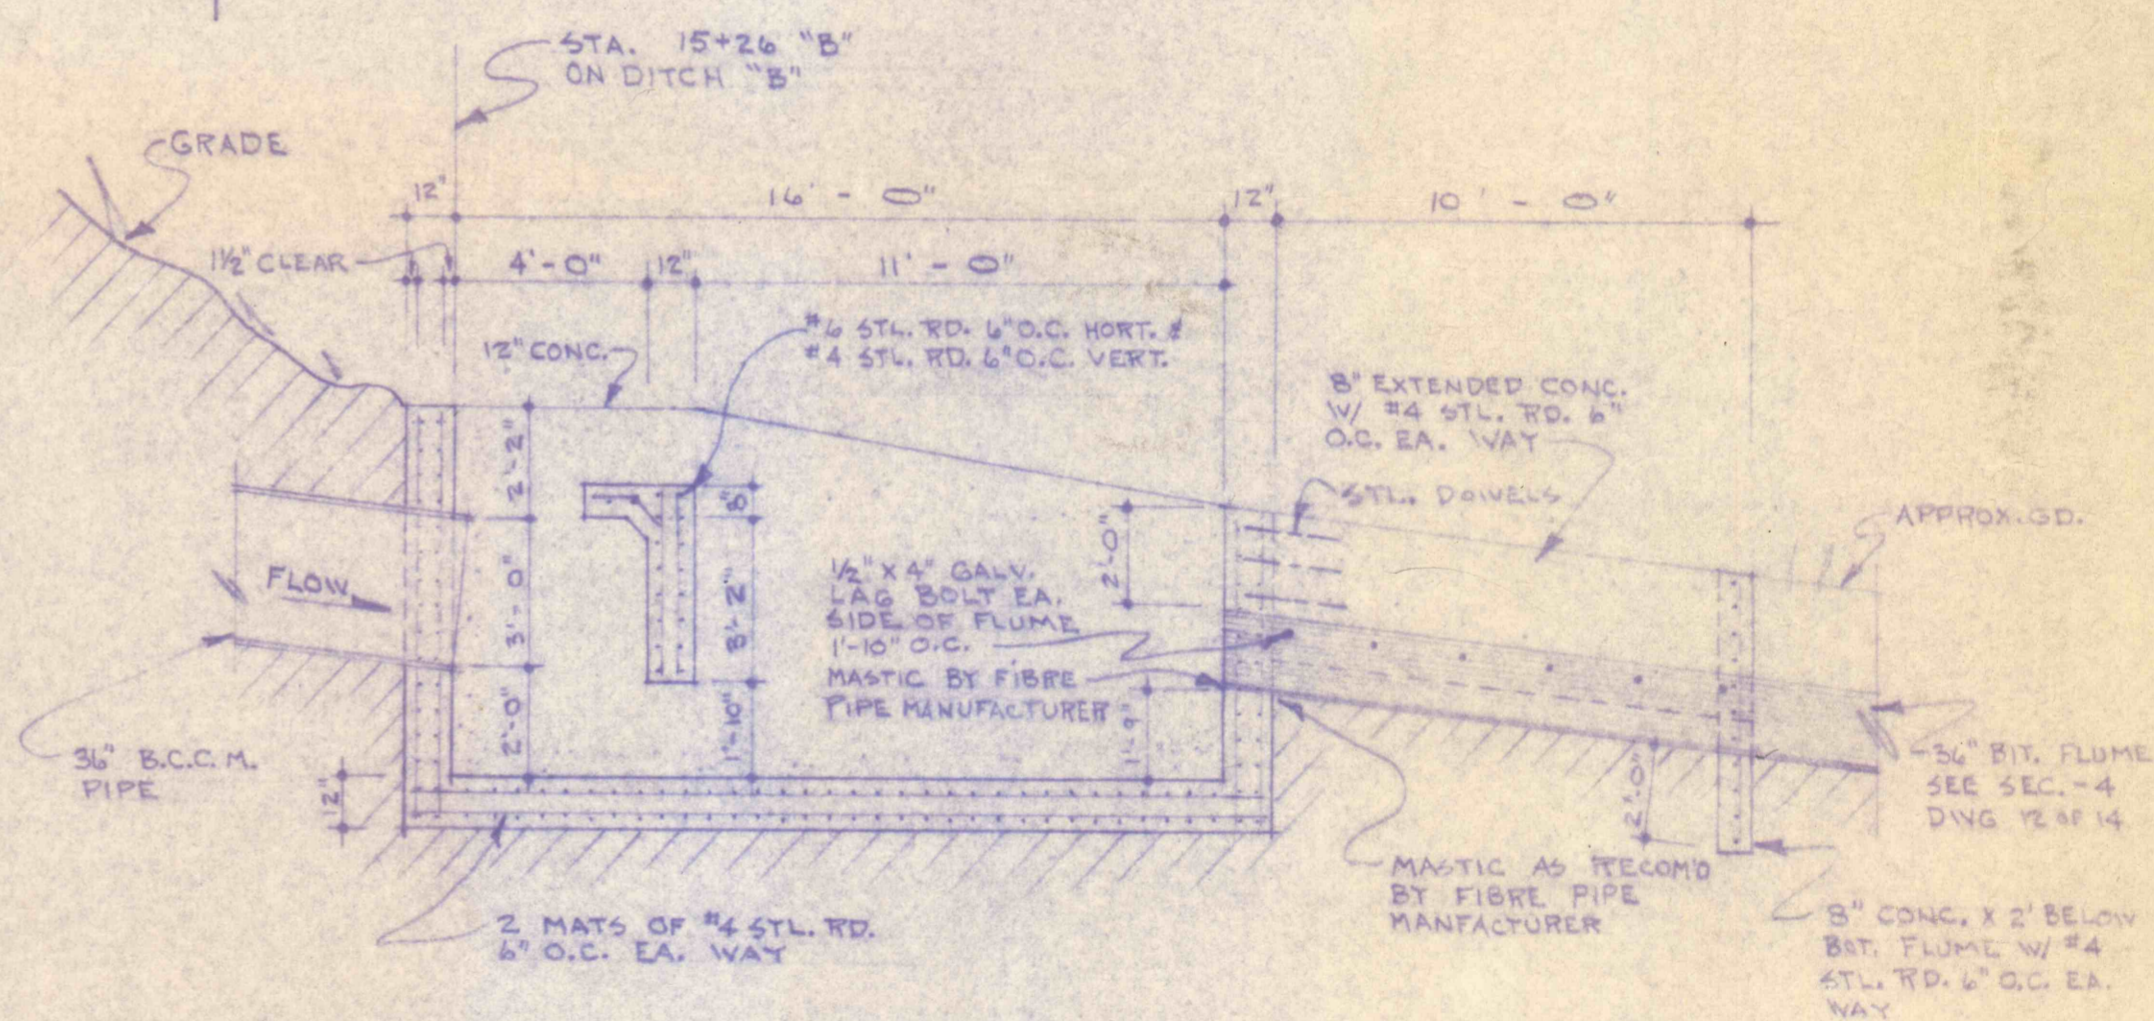

SECTION OF DISSIPATOR DITCH "B" - STATION 15+26

SCALE - 1/4" = 1'-0"

WORK SHEET

CHANGE ORDER # 1

PROJECT # SL 113-2-2

DISSIPATOR DETAILS - SEE SHT. 9 OF 14

JOHN S. LUCKENS ASSOC.

P.O. BOX 190

SHAMOKIN, PENNA. 17872

PROJECT TITLE

MINE DRAINAGE POLLUTION ABATEMENT
QUICK STARTS E, F & G
SHAMOKIN CK. WATERSHED - NORTH'D CO.
PROJECT No. SL 113-2-2

REV.

4/15/74

5/6/74

5/14/74

5/23/74

SHEET No.

1

OF 2