
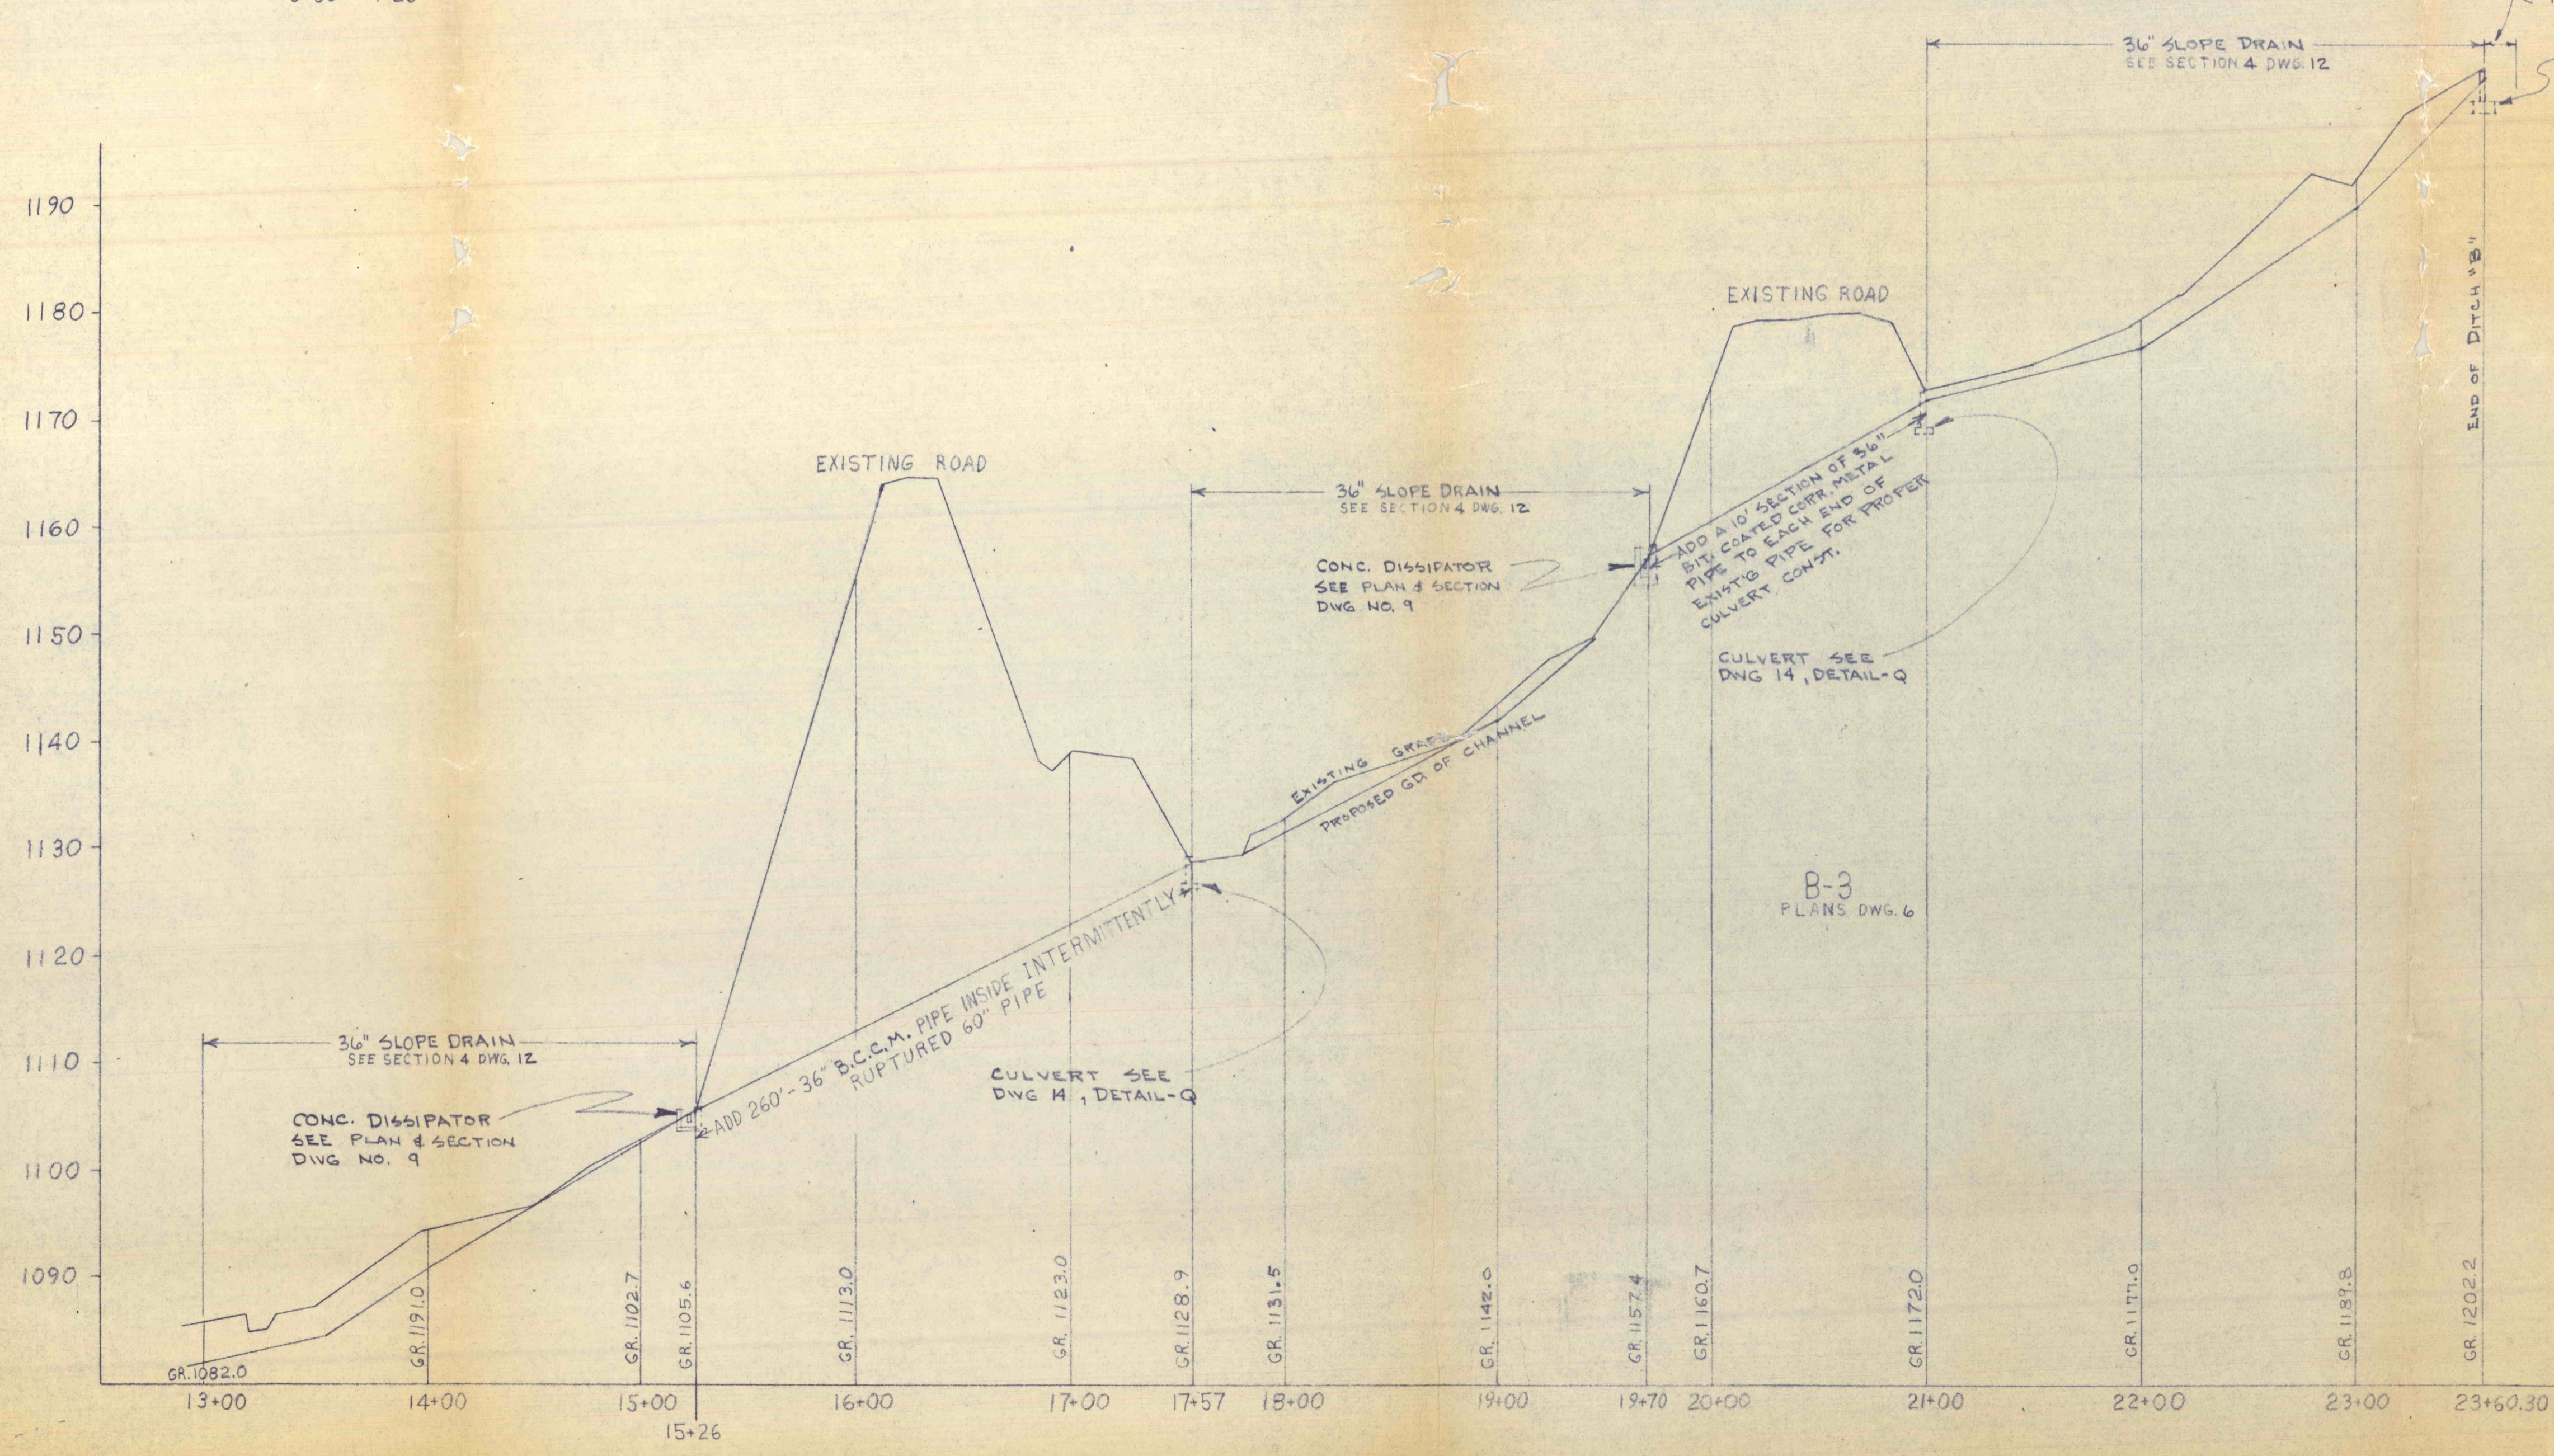
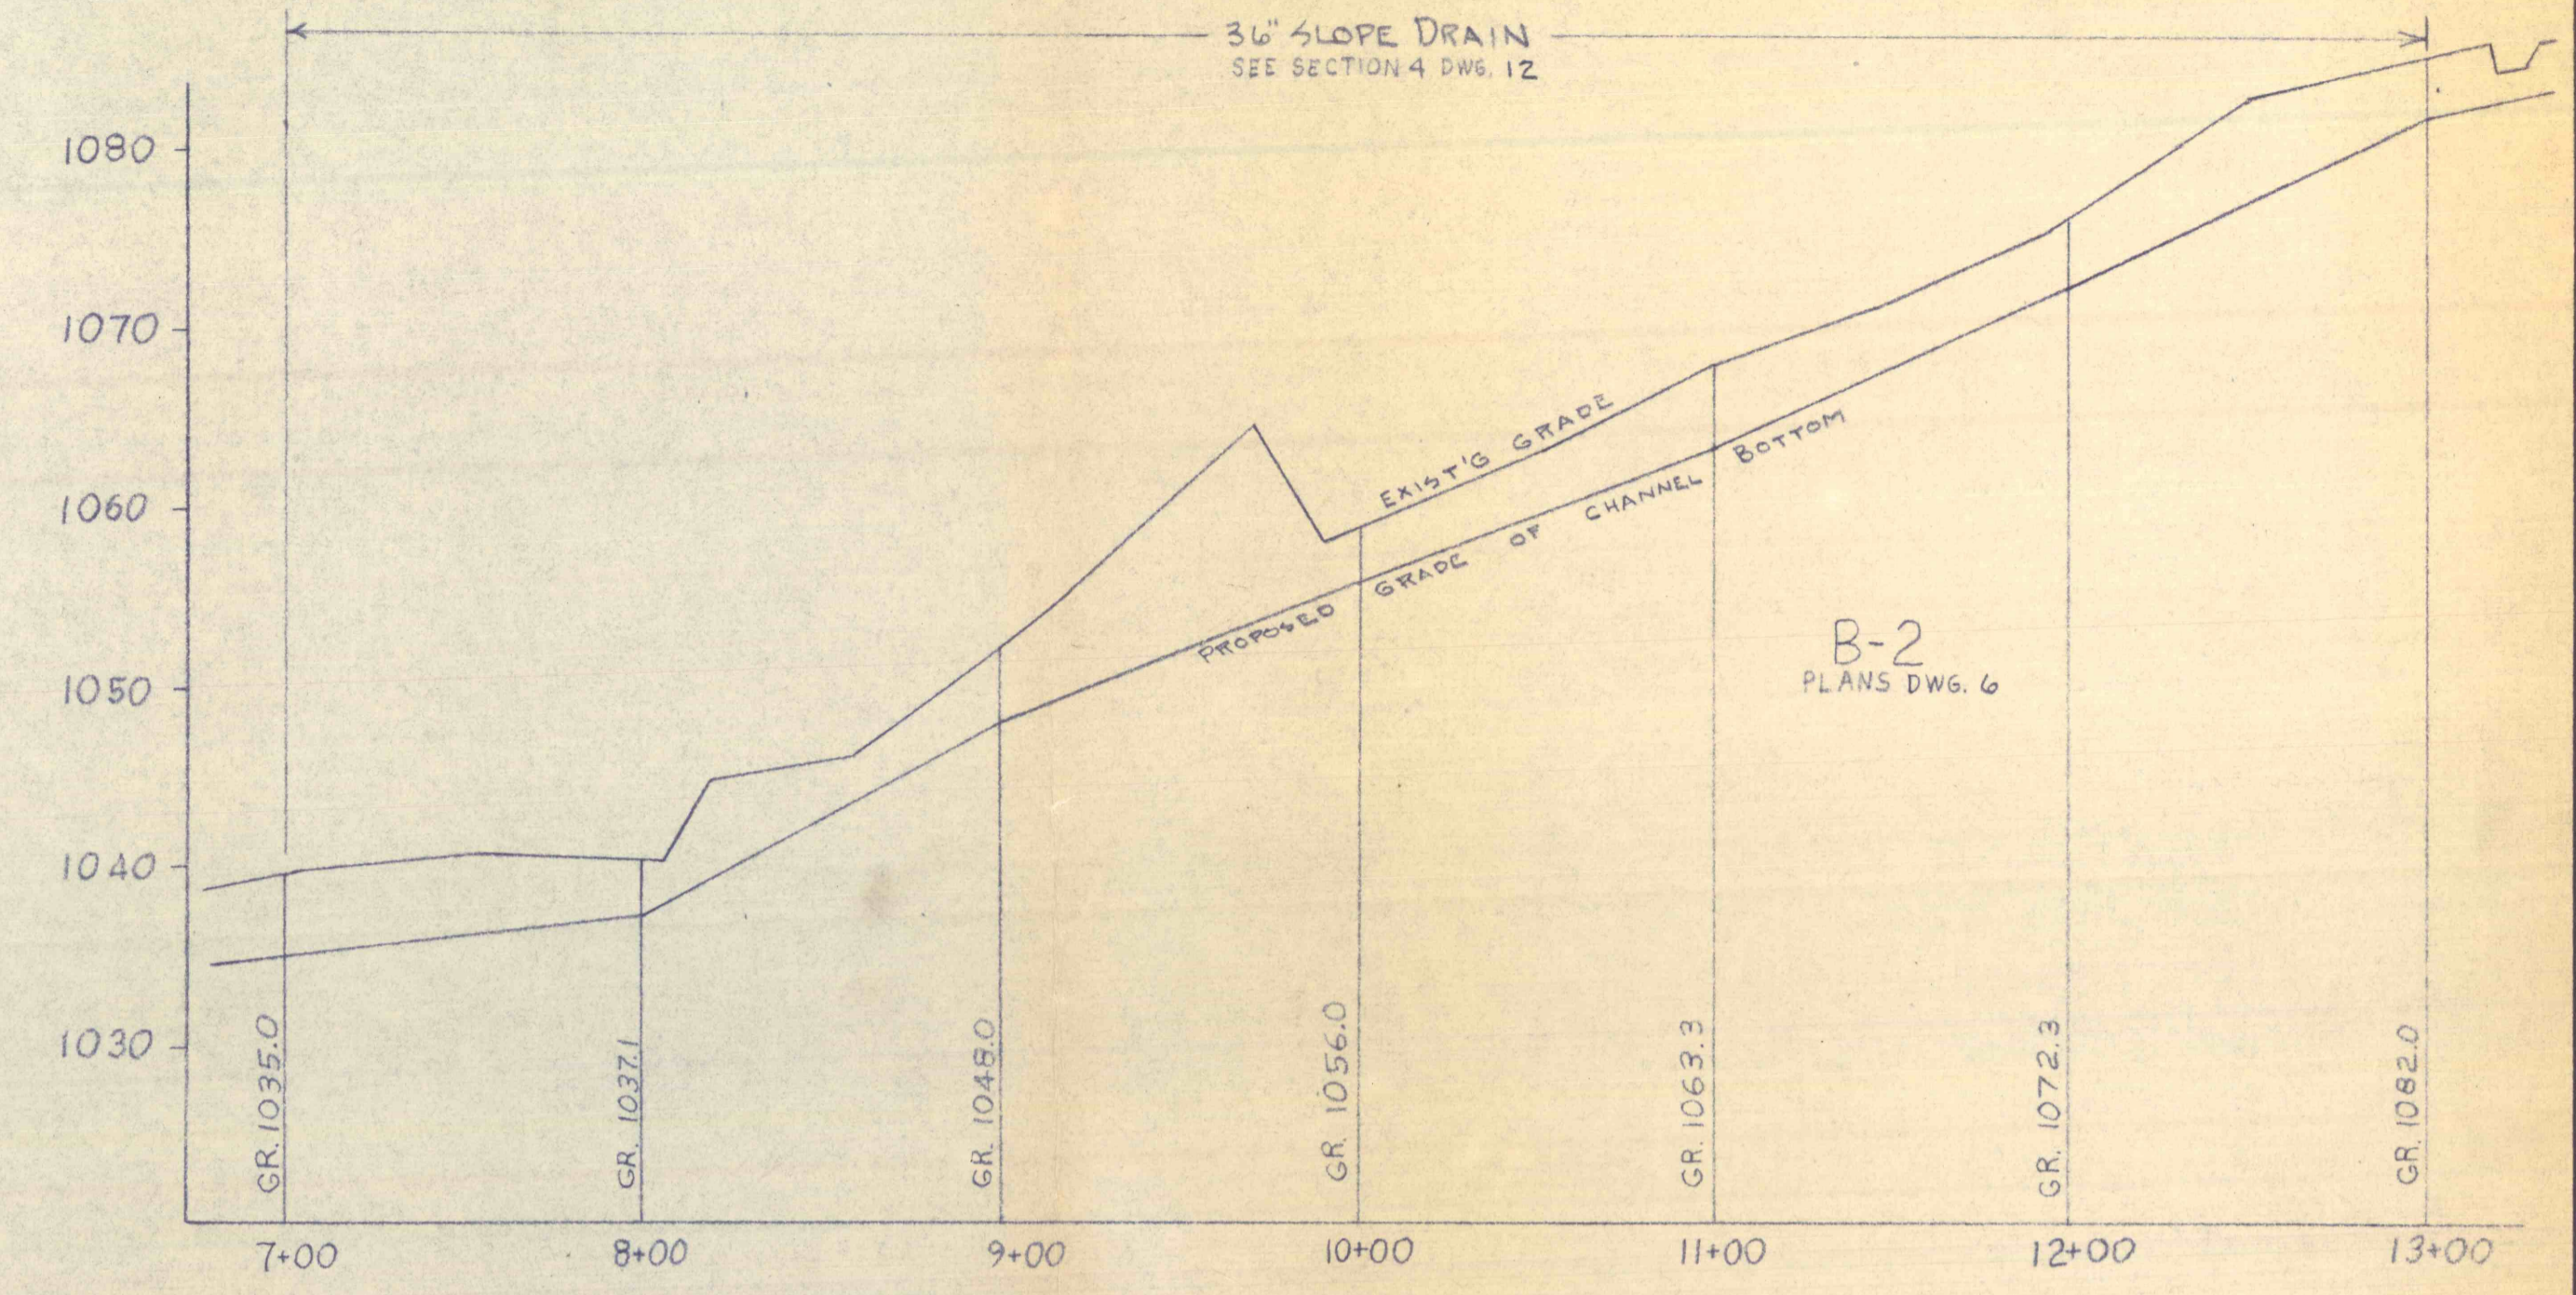
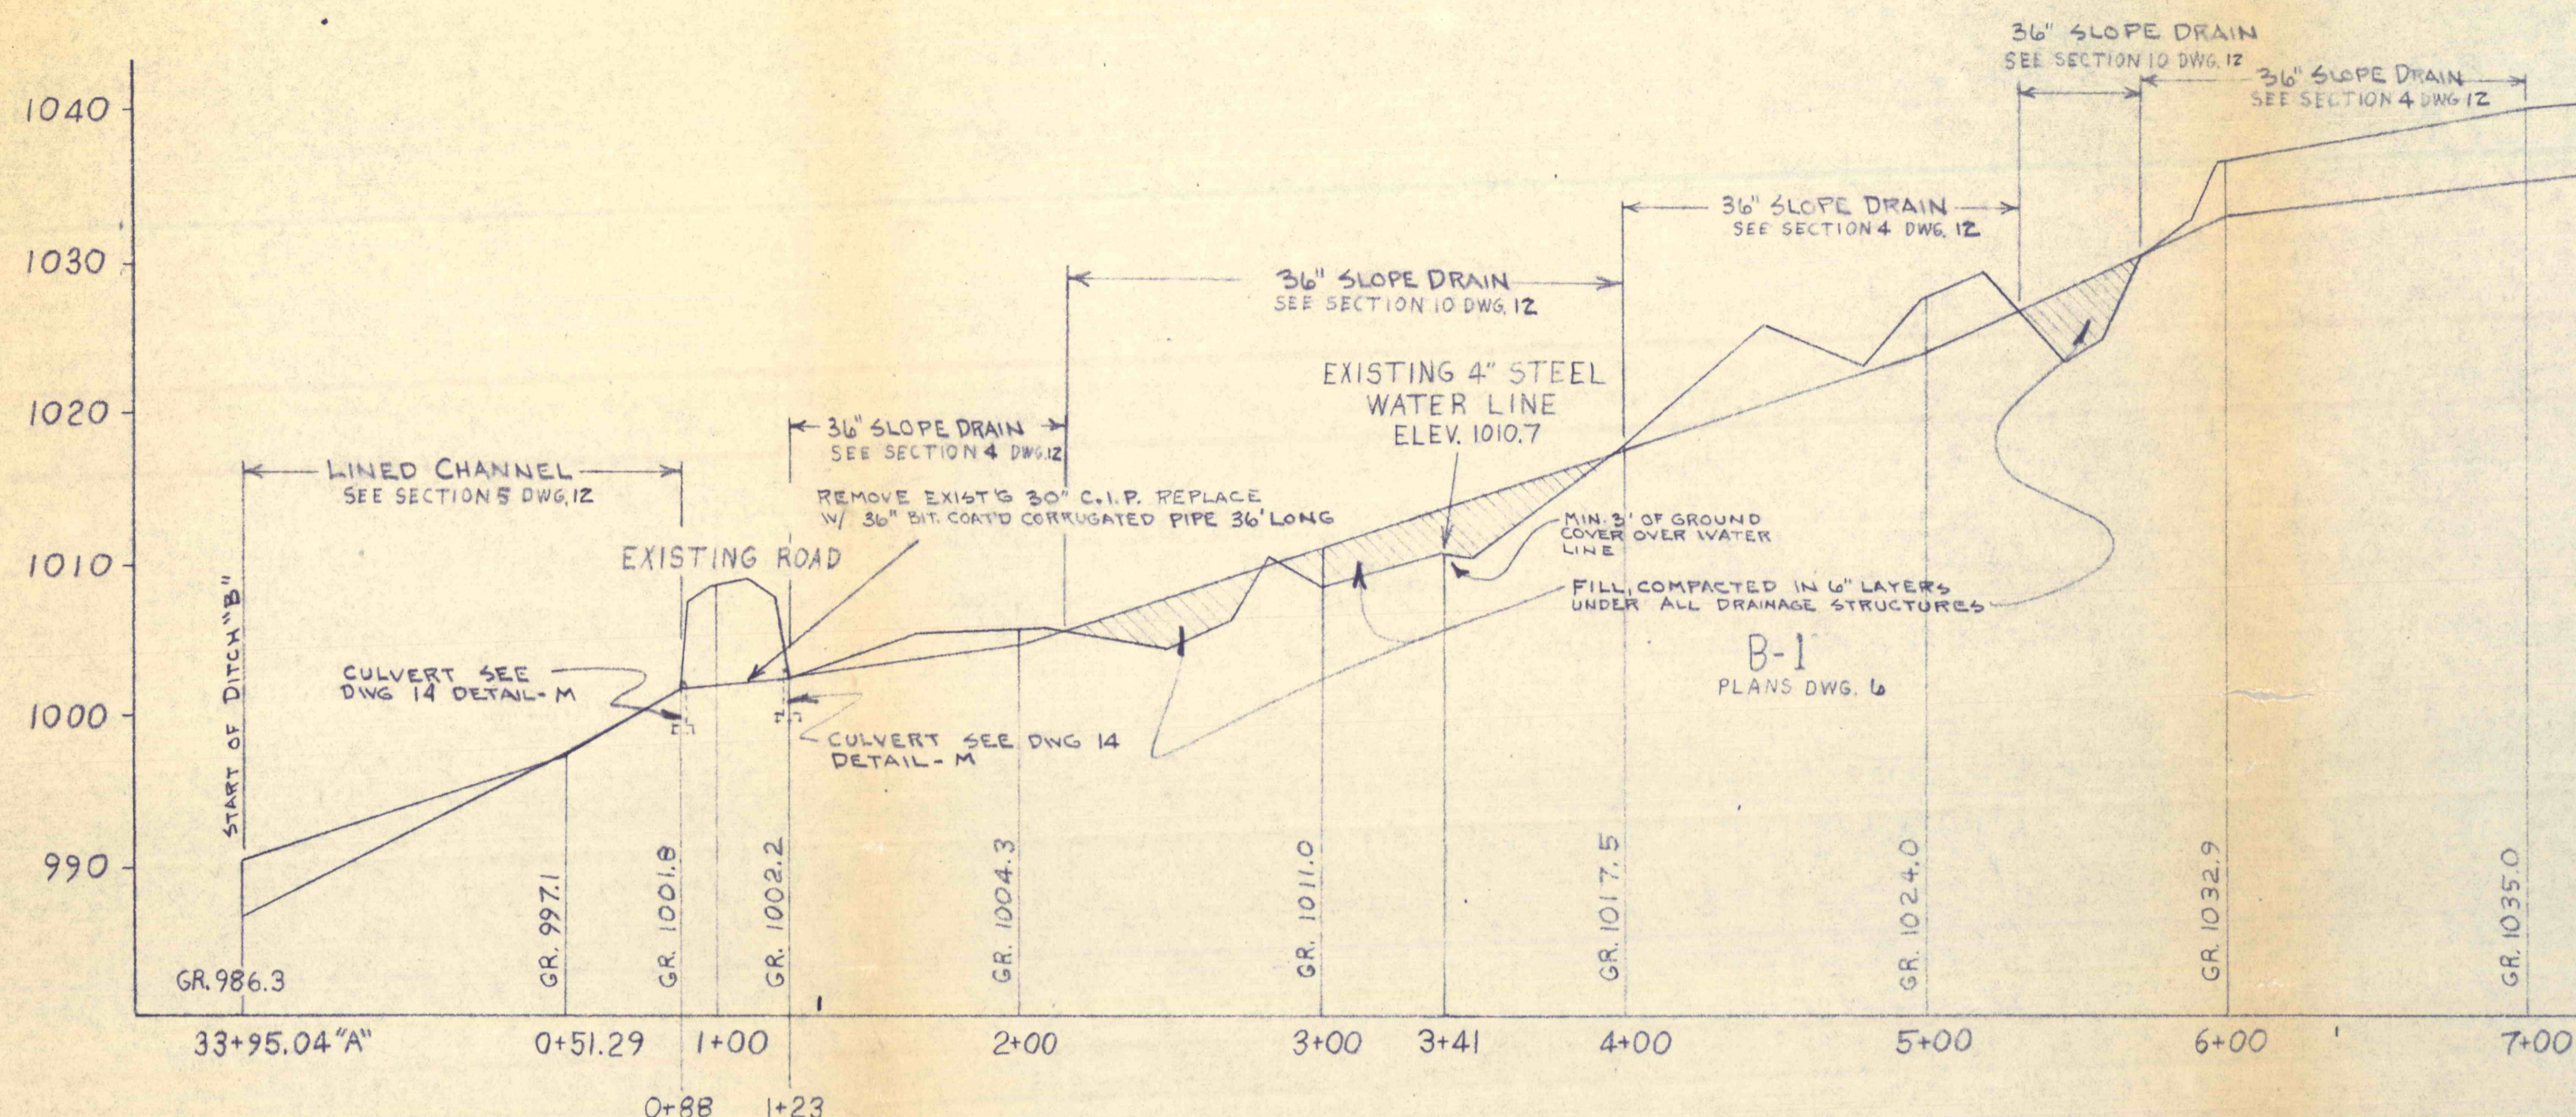
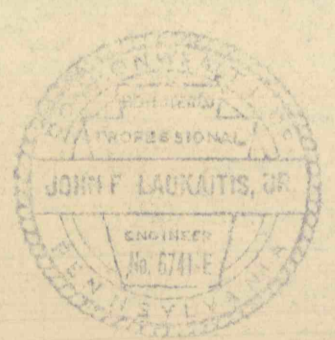


DITCH "B"
PLANS DWG. 6

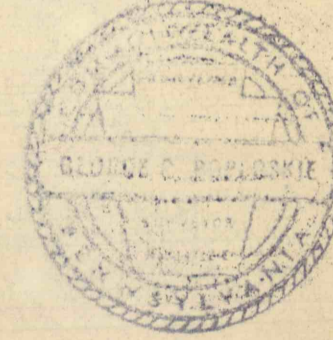

PROFILES OF DITCH "B"
SCALE - HORIZONTAL - 1" = 50' VERTICAL - 1" = 10'

NO.	DATE	REVISION	APPR.
SUBMITTED			
PROFESSIONAL			
APPROVED <i>Albert A. Rainey</i> CHIEF - DIVISION OF MINE RECLAMATION			
APPROVED <i>Dan Perigo</i> DIRECTOR - BUREAU OF DESIGN			
 			
COMMONWEALTH OF PENNSYLVANIA DEPARTMENT OF ENVIRONMENTAL RESOURCES OFFICE OF RESOURCES MANAGEMENT			
PROJECT NO. SL 113-2			
MINE DRAINAGE POLLUTION ABATEMENT QUICK STARTS E, F and G SHAMOKIN CREEK WATERSHED			
JOHN S. LUCKENS ASSOC.			
P. O. Box 190		Shamokin, Penna.	
PROFILE OF DITCH B			
DRAWN BY	DATE	DRAWING NO.	
CHECKED BY	January 2, 1974	10 of 1	
	SCALE		
	As Shown		