




TYPICAL DIVERSION DITCH SECTION w/ JUTE MATTING - ①
SCALE - 1/2" = 1' - 0"

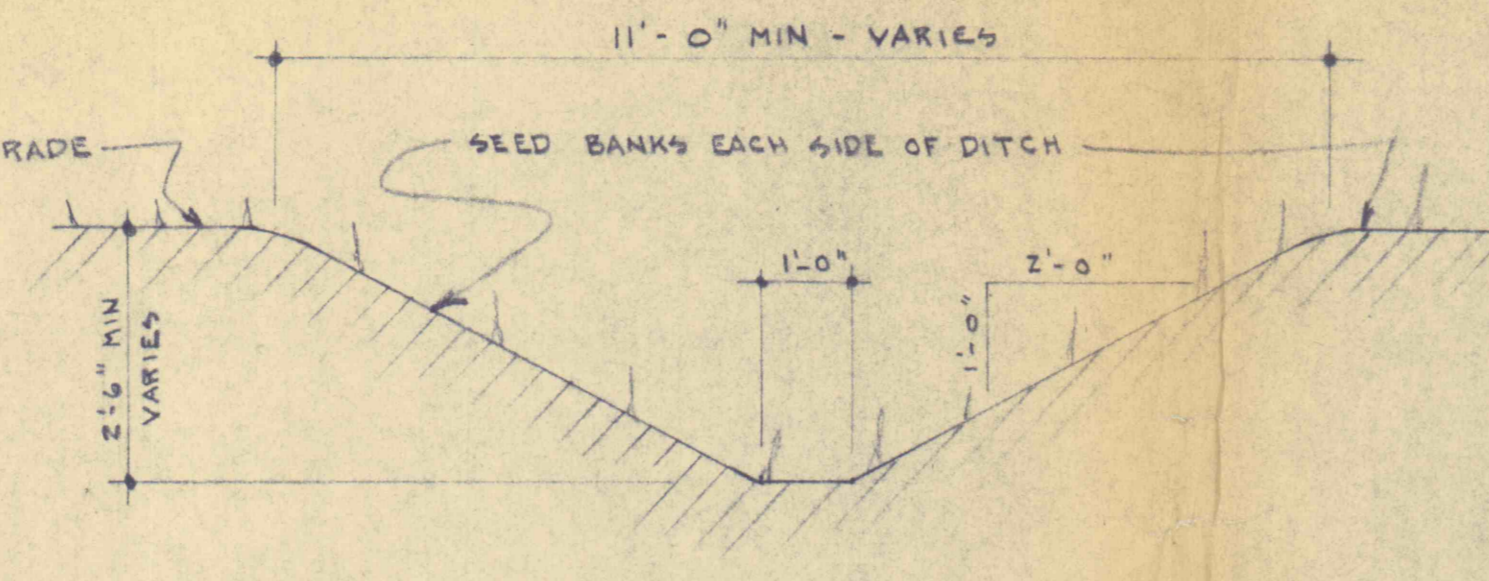


TYPICAL DIVERSION DITCH SECTION - ②
SCALE - 1/2" = 1' - 0"

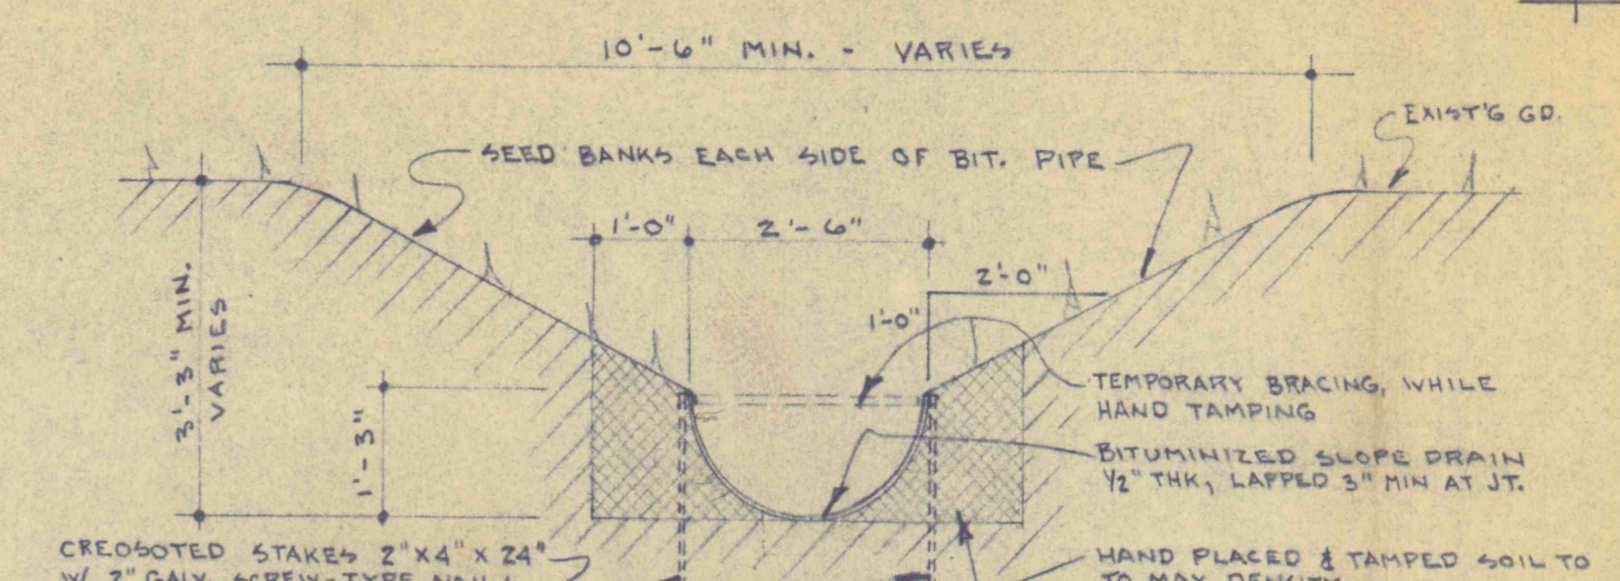


TYPICAL SECTION OF 30" BITUMINIZED SLOPE DRAIN - ③
SCALE - 1/2" = 1' - 0"

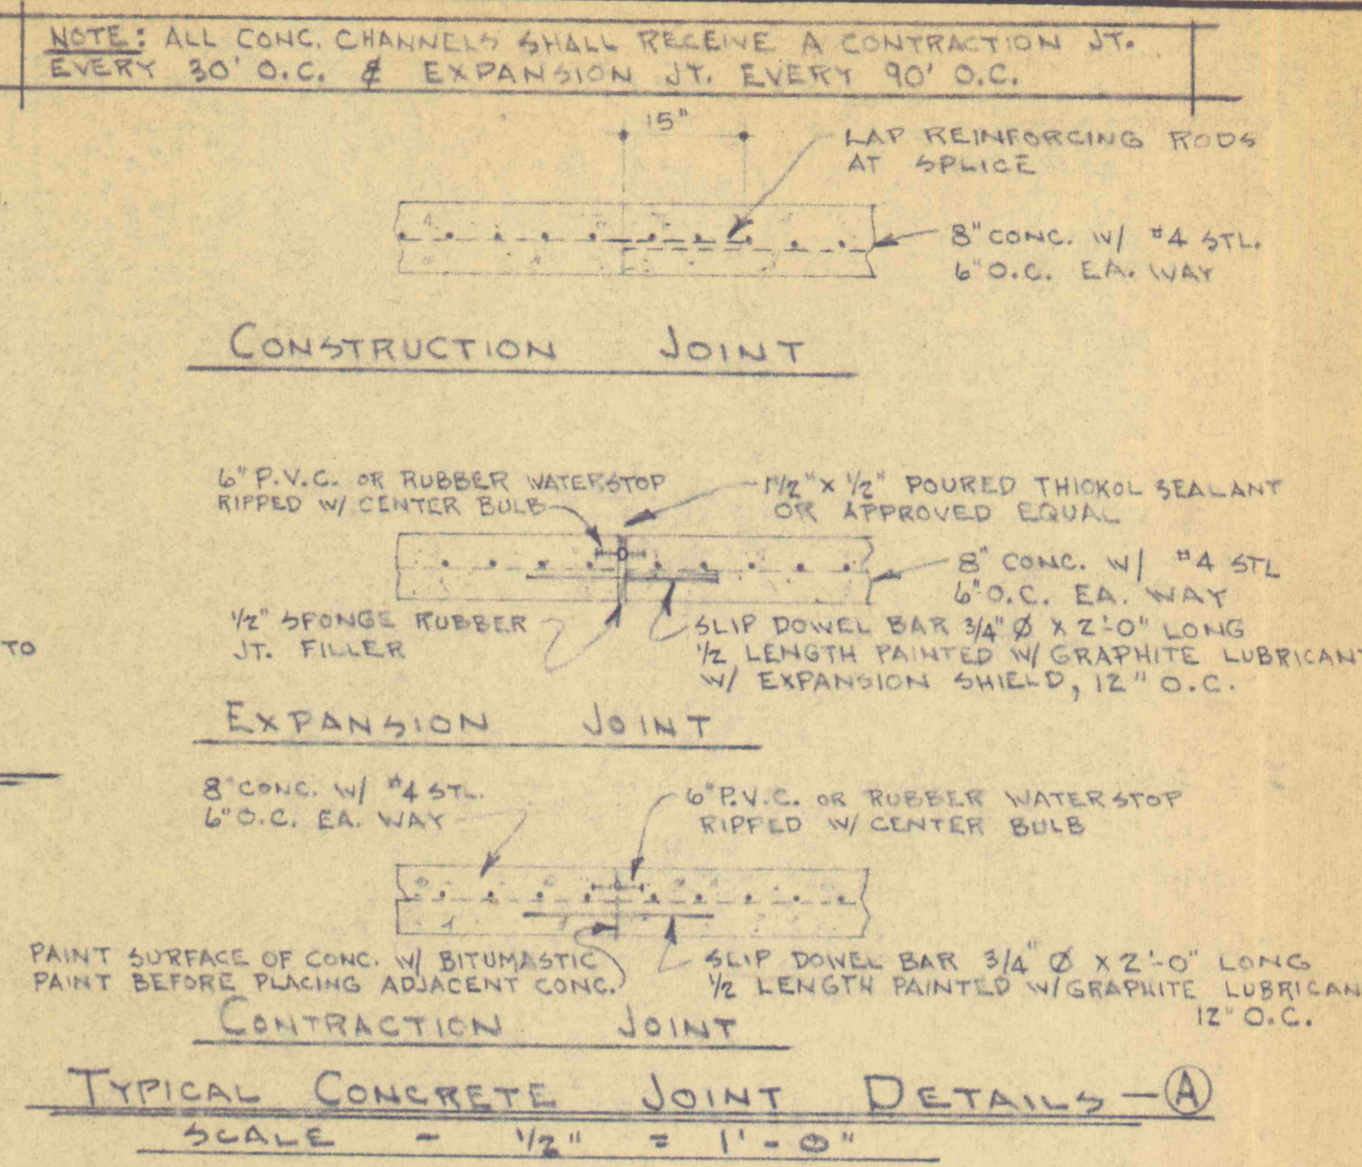


NOTE: SUB SURFACES OF ALL CHANNELS SHALL BE OF SUITABLE MATERIAL, FROM THE WORK AREAS. SUB SURFACE MATERIAL SHALL NOT BE SPOIL MATERIAL. WASTE & FILL MATERIAL UNSUITABLE FOR BEDDING SHALL BE REMOVED & PLACED IN PITS NEAR WORK AREA, WITH THE APPROVAL OF THE ENGINEER.

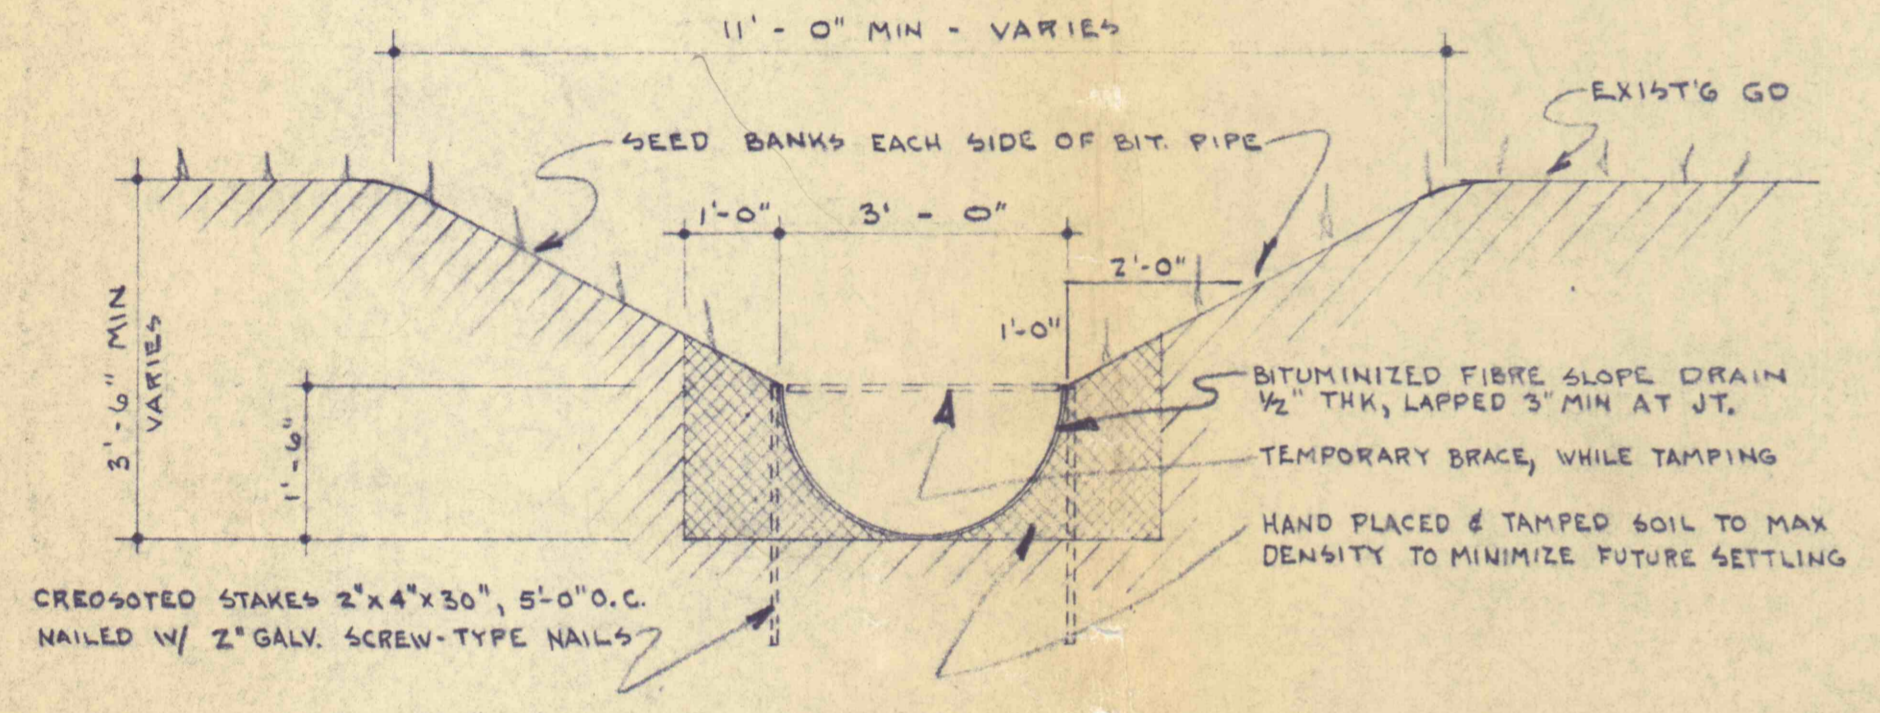


TYPICAL SECTION OF 36" BITUMINIZED SLOPE DRAIN - ④
SCALE - 1/2" = 1' - 0"

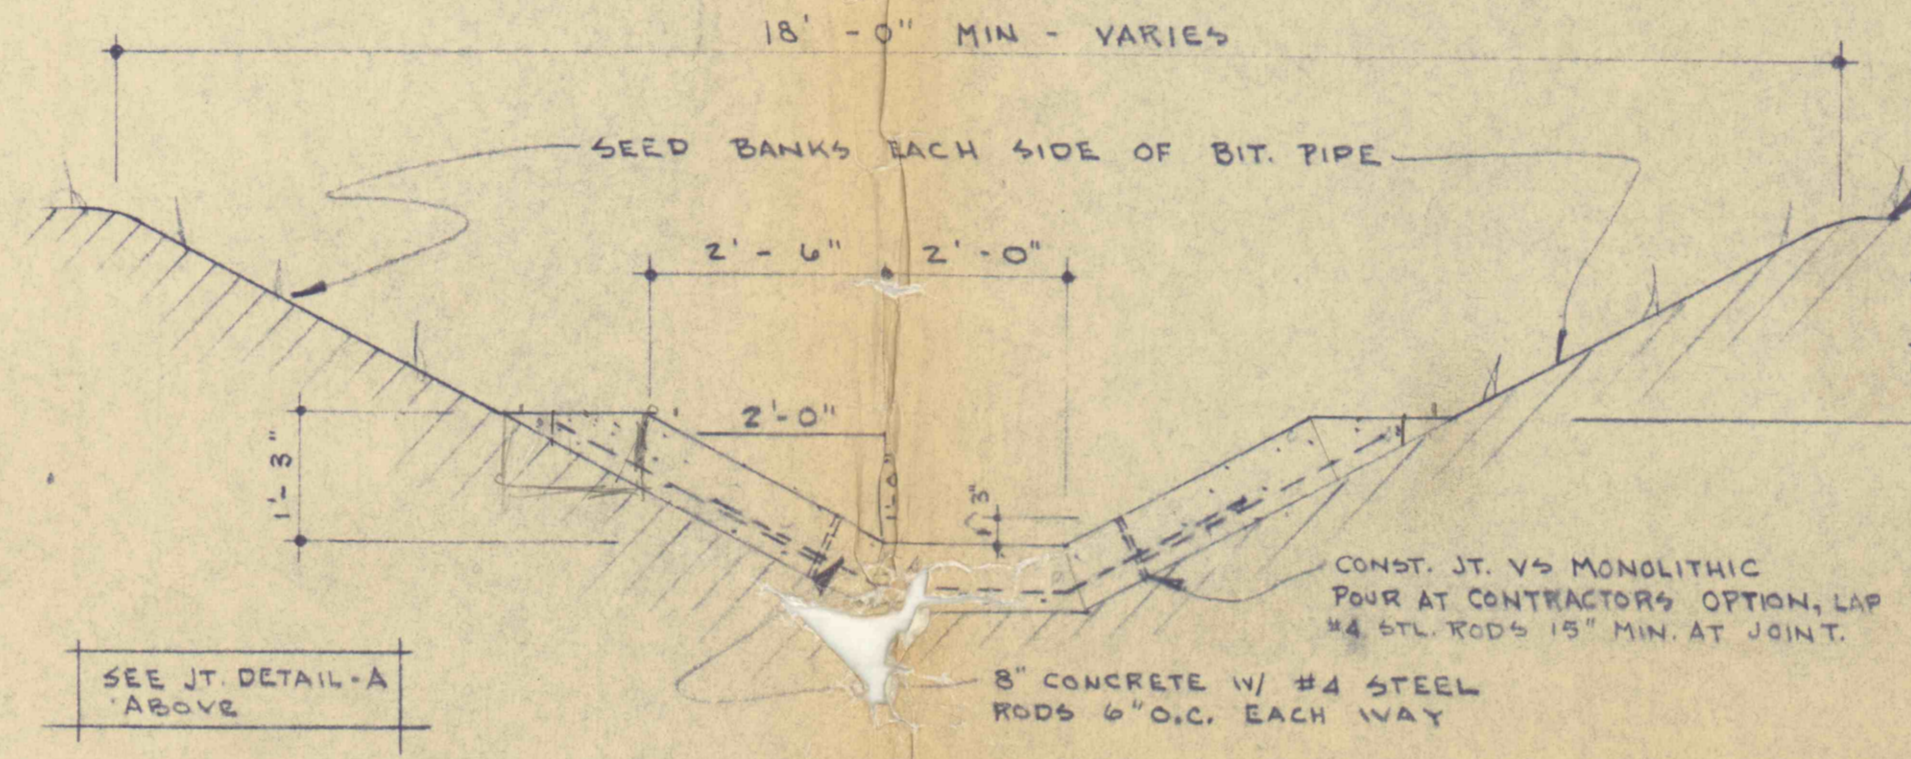


TYPICAL LINED CHANNEL SECTION - ⑤
SCALE - 1/2" = 1' - 0"

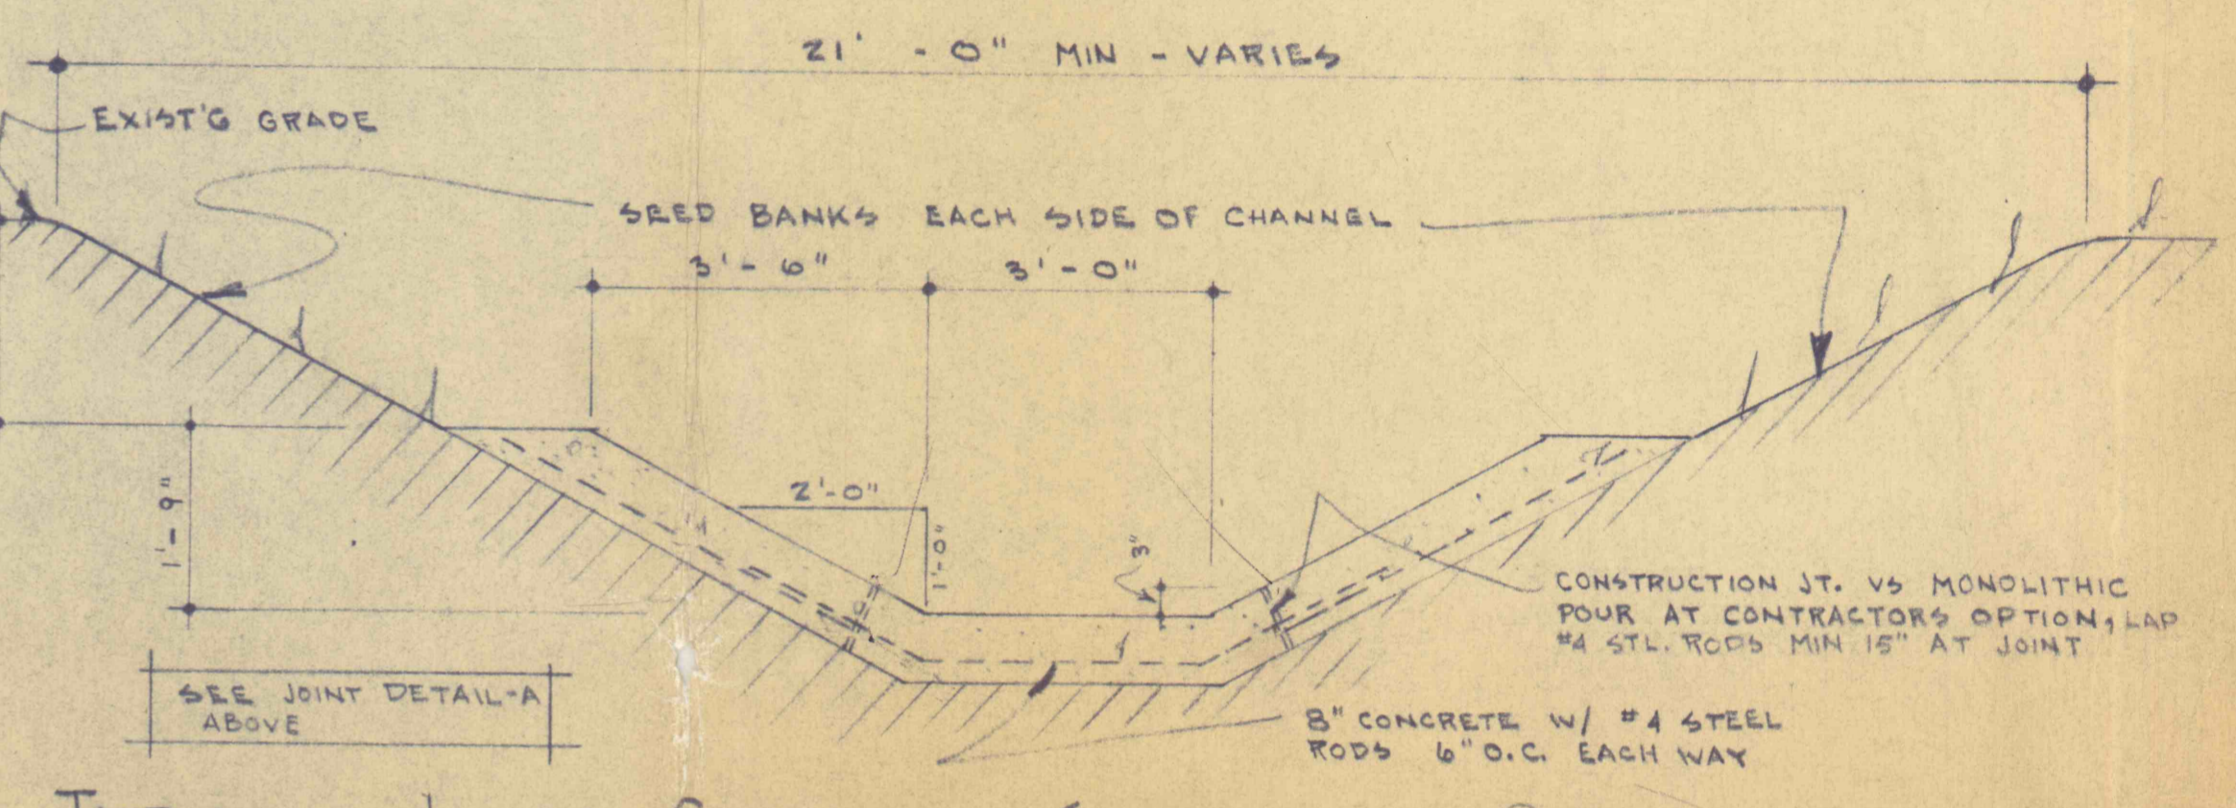


TYPICAL LINED CHANNEL SECTION - ⑥
SCALE - 1/2" = 1' - 0"

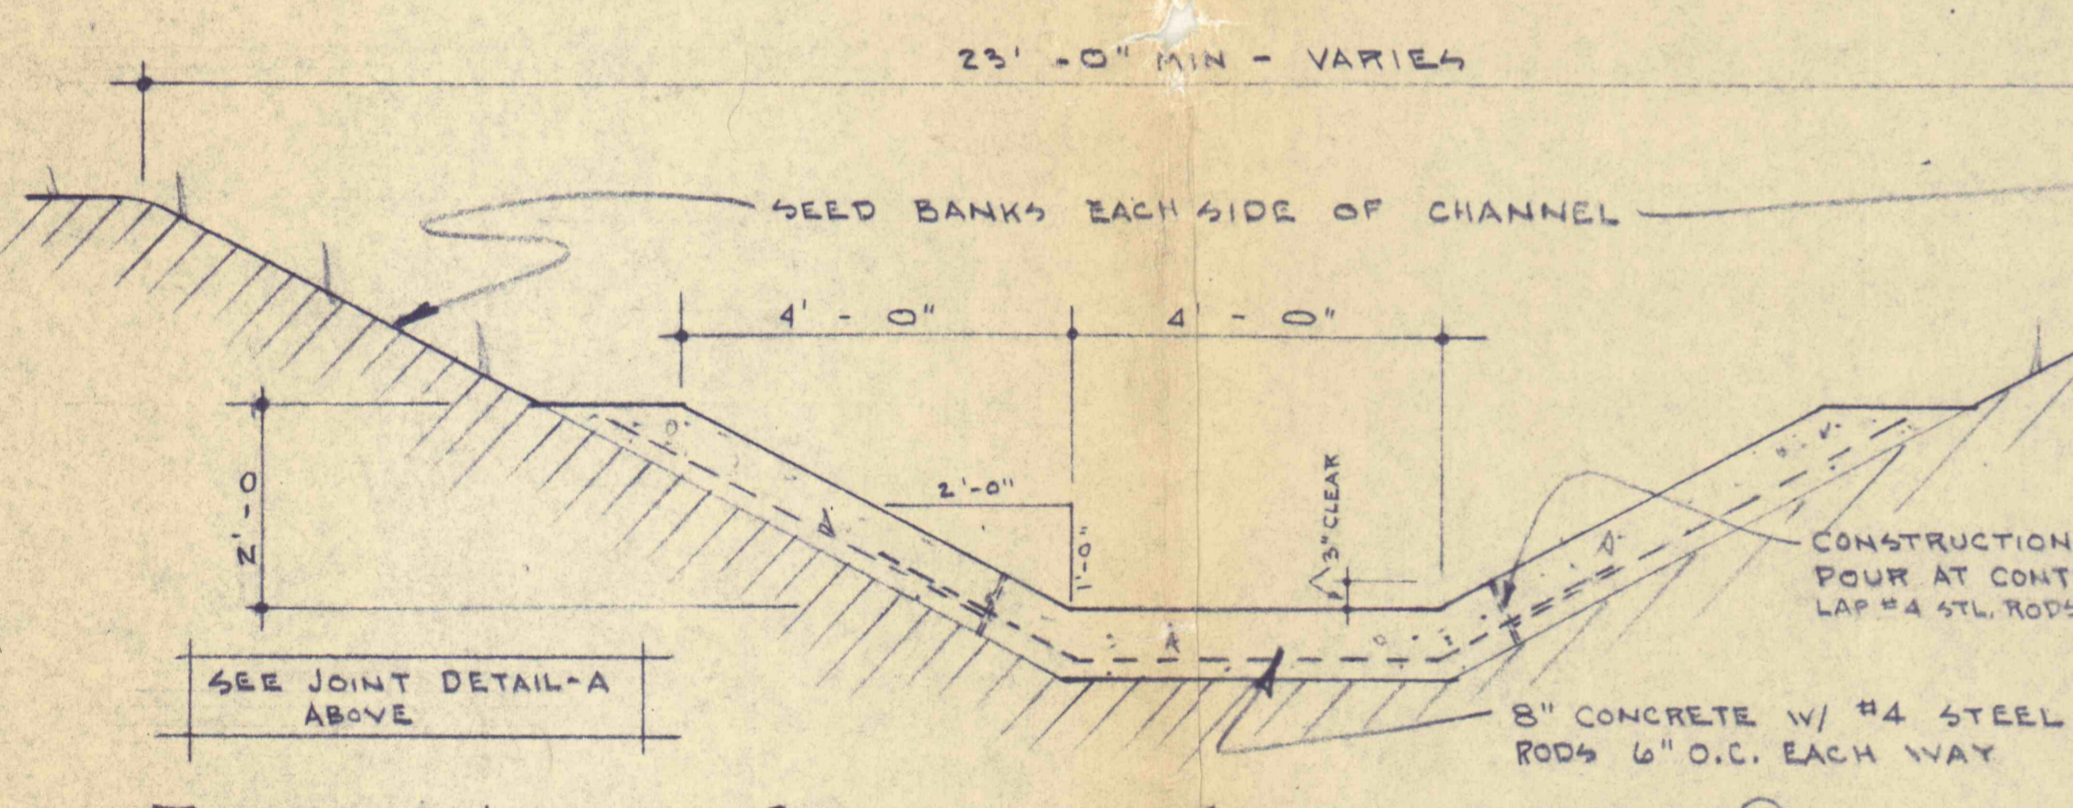

TYPICAL LINED CHANNEL SECTION - ⑦
SCALE - 1/2" = 1' - 0"

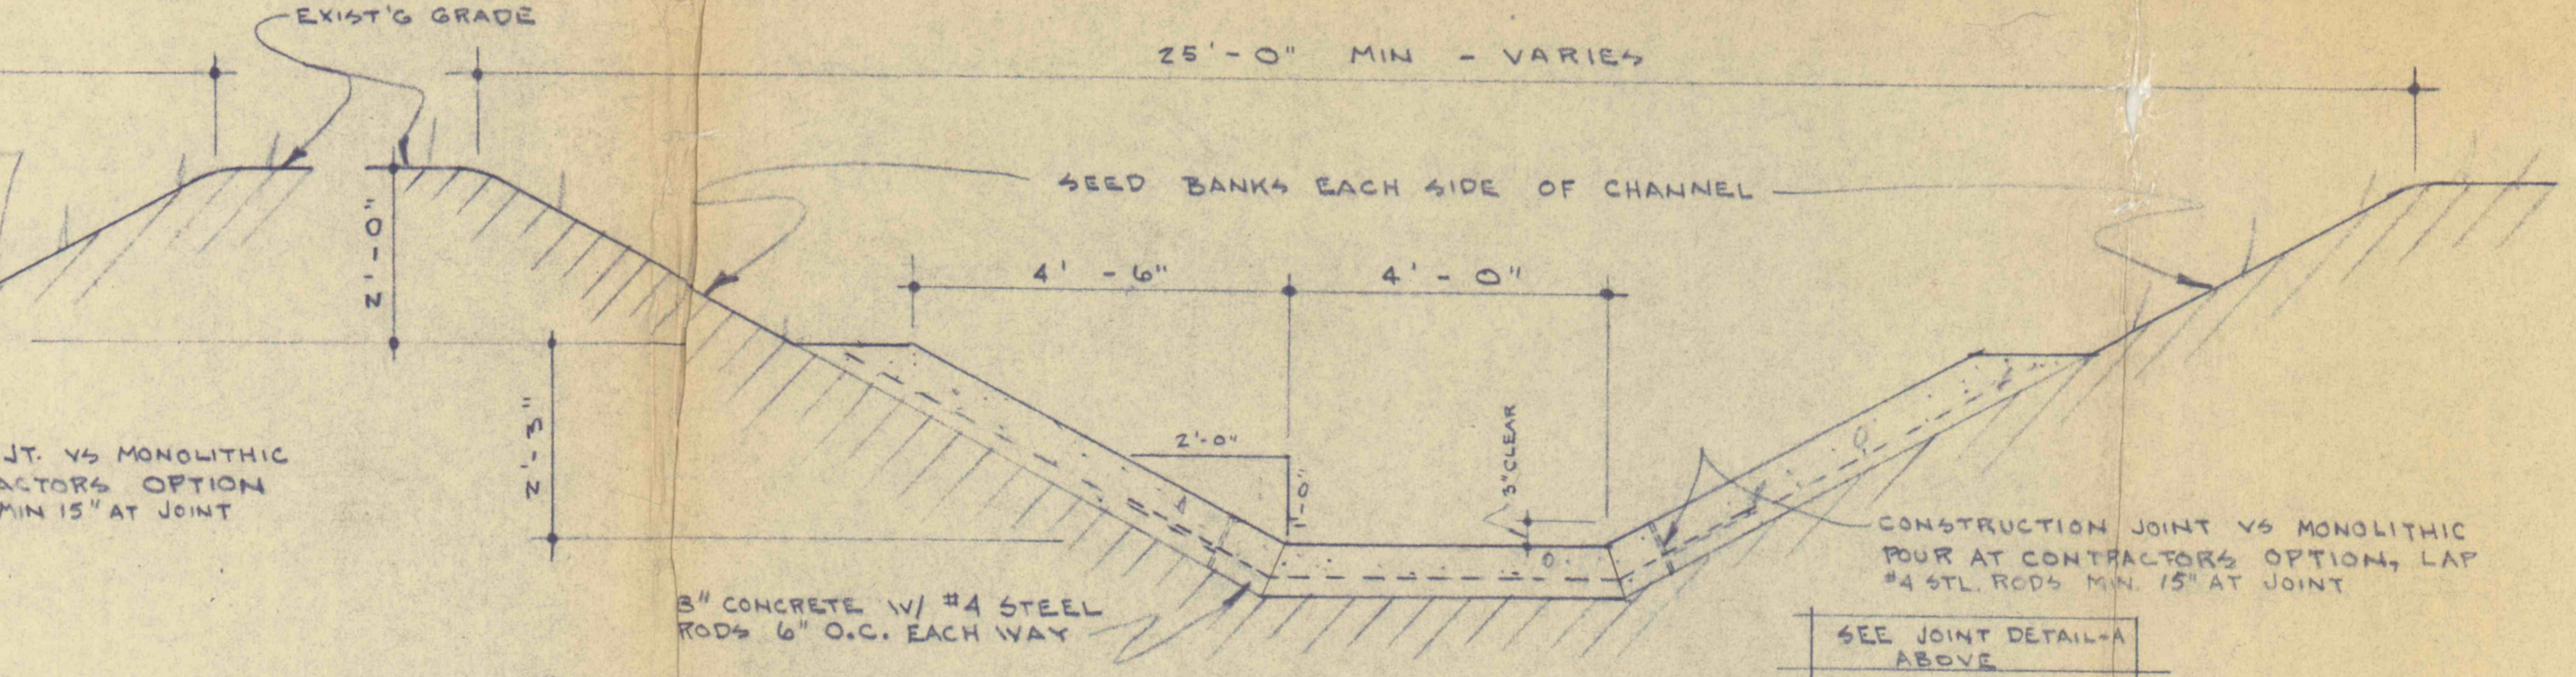


TYPICAL LINED CHANNEL SECTION - ⑧
SCALE - 1/2" = 1' - 0"

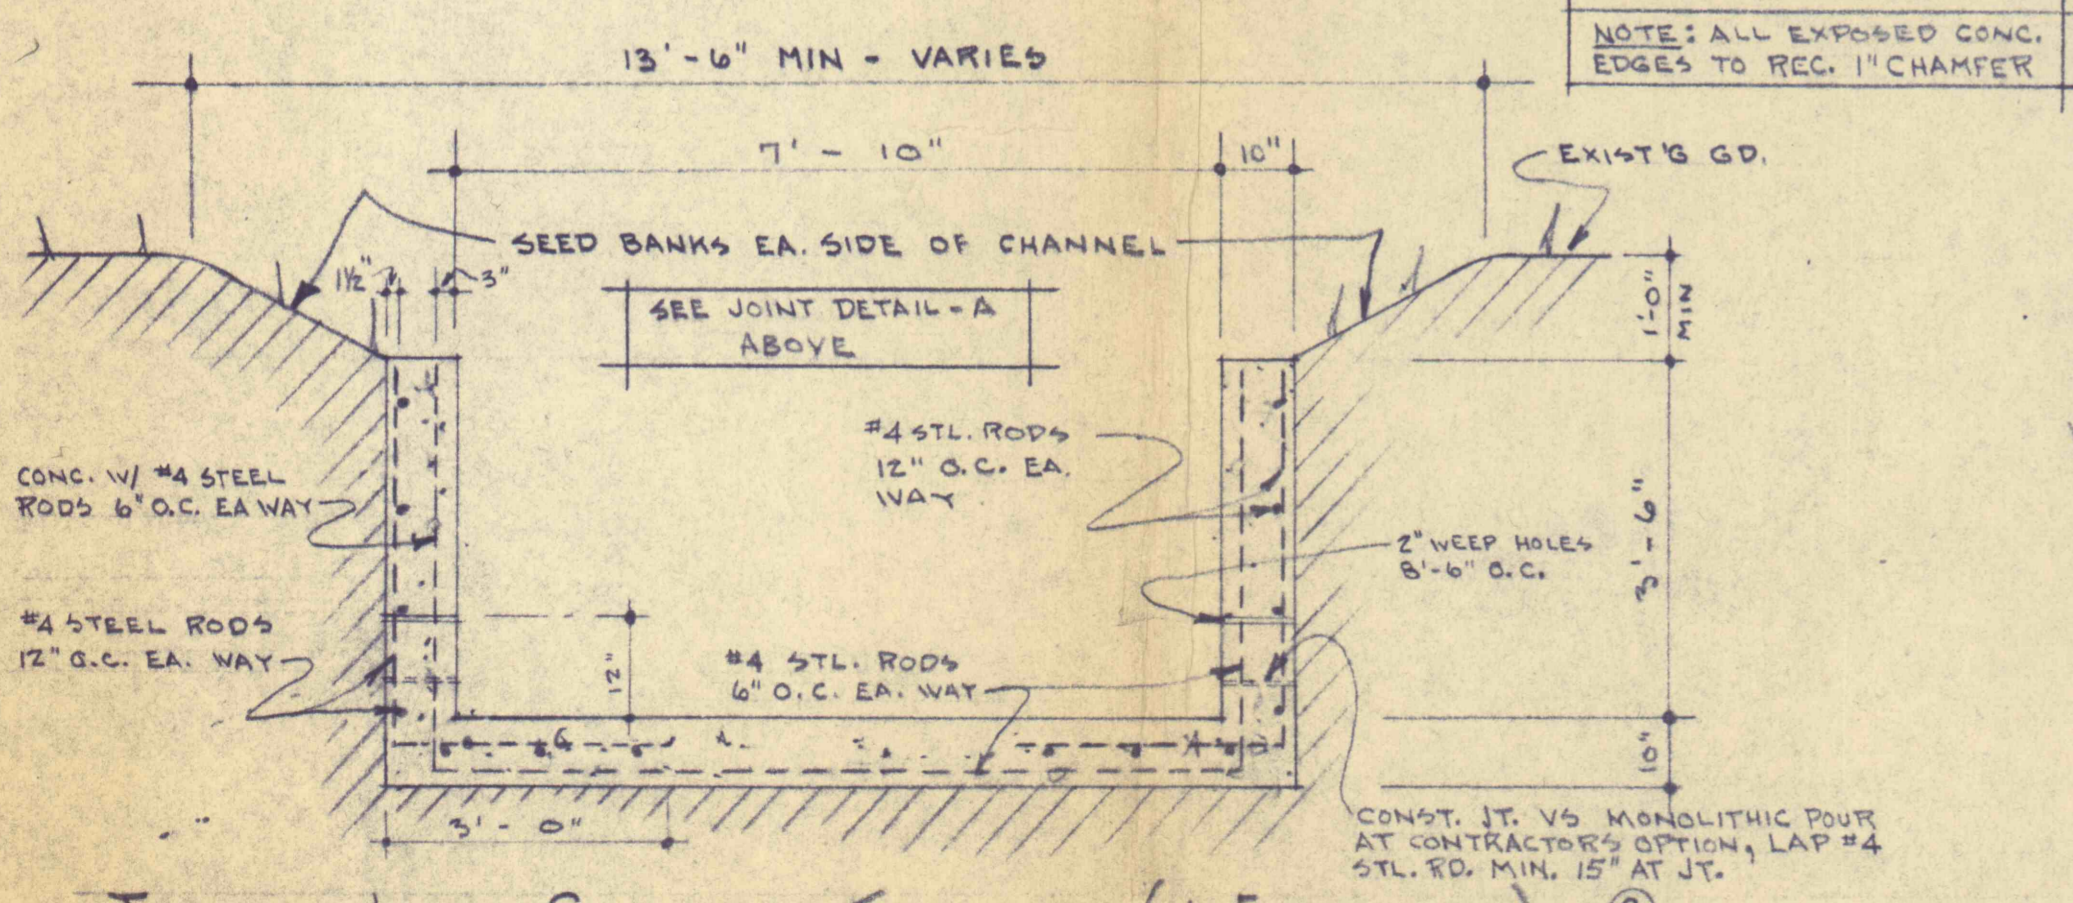

TYPICAL LINED CHANNEL SECTION (IN EXCELSIOR) - ⑨
SCALE - 1/2" = 1' - 0"

optional joint placed 2' above invert - d Lockers approved 6-17-74

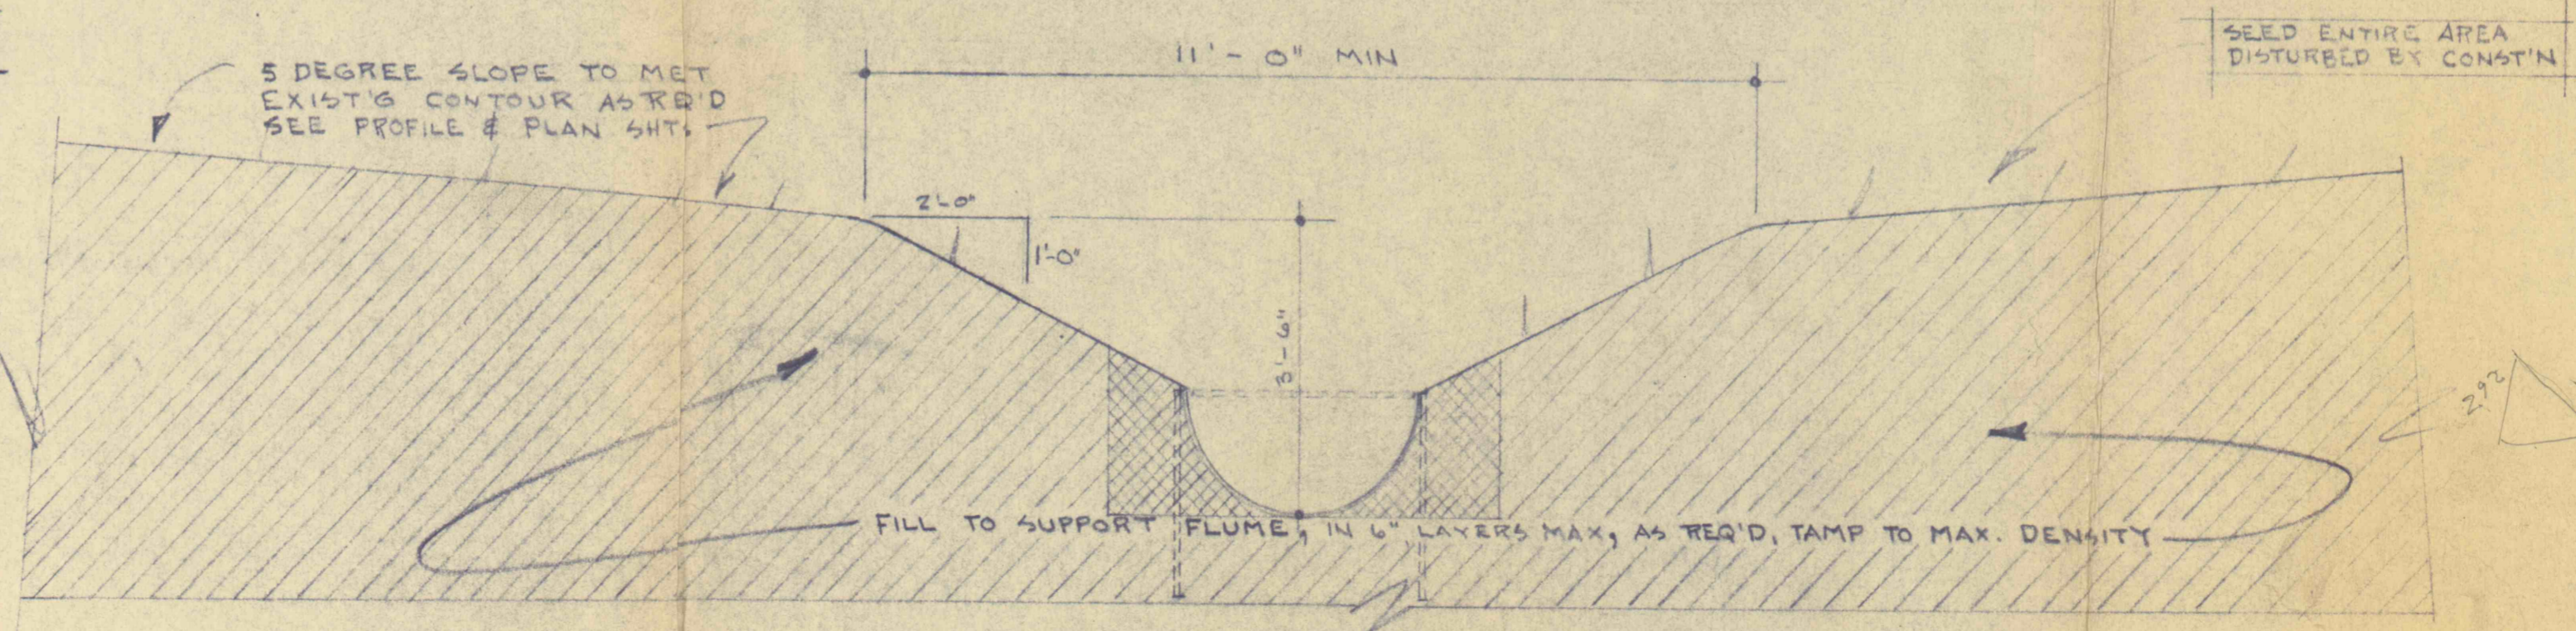

FLUME EMBANKMENT SECTION OF FILL AREAS (SEE STA. BELOW) - ⑩
SCALE - 1/2" = 1' - 0"

FROM STA. 58+50 TO 58+70 ON DITCH "A"
FROM STA. 2+15 TO 4+00 ON DITCH "B"
FROM STA. 5+30 TO 5+70 ON DITCH "B"

NO.	DATE	REVISION	APPR.
SUBMITTED			
PROFESSIONAL			
APPROVED			
APPROVED			
<p>COMMONWEALTH OF PENNSYLVANIA DEPARTMENT OF ENVIRONMENTAL RESOURCES OFFICE OF RESOURCES MANAGEMENT</p> <p>PROJECT NO. SL 113-2 MINE DRAINAGE POLLUTION ABATEMENT QUICK STARTS E, F and G SHAMOKIN CREEK WATERSHED</p> <p>JOHN S. LUCKENS ASSOC. P. O. Box 190 Shamokin, Penna.</p> <p>SECTIONS and DETAIL</p>			
DRAWN BY	DATE	DRAWING NO.	
CHECKED BY	SCALE	12 of 14	