

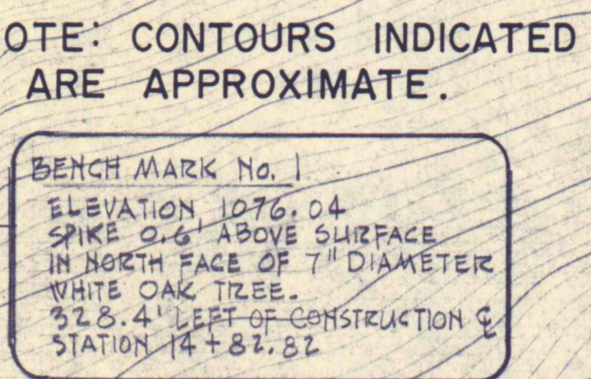
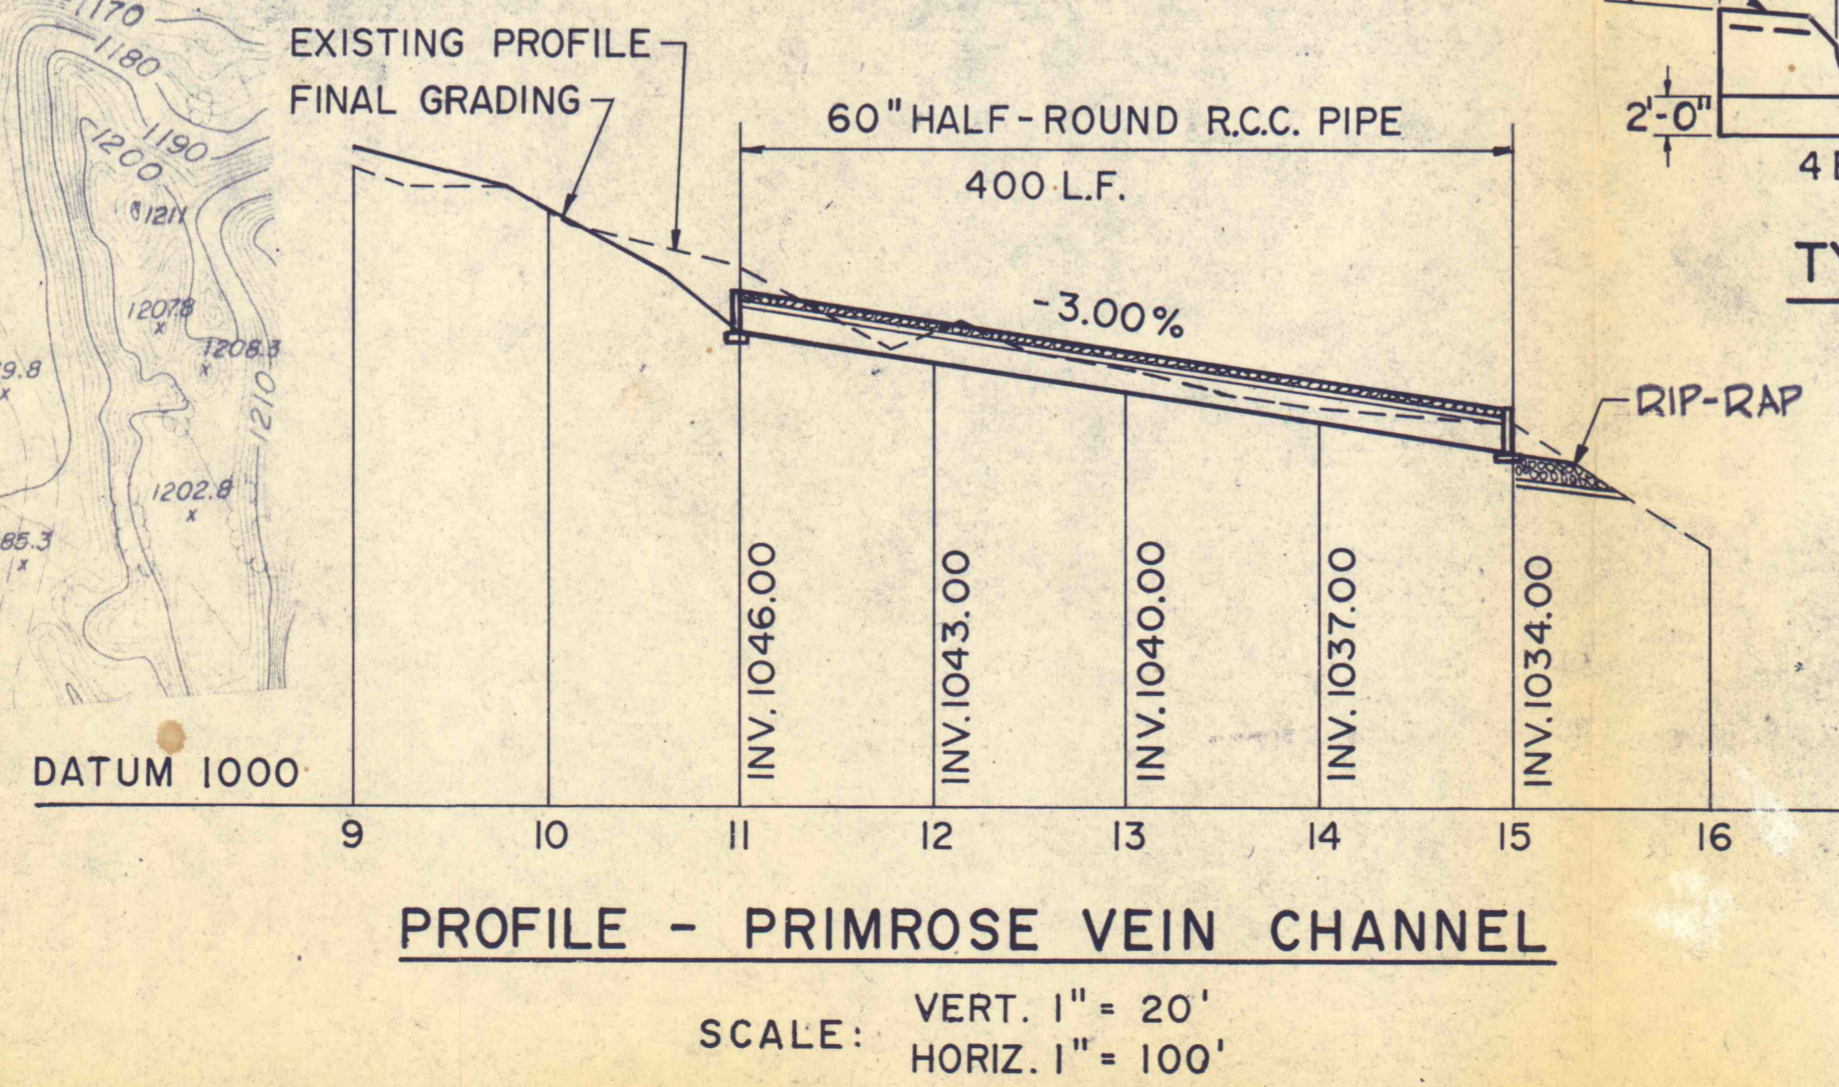
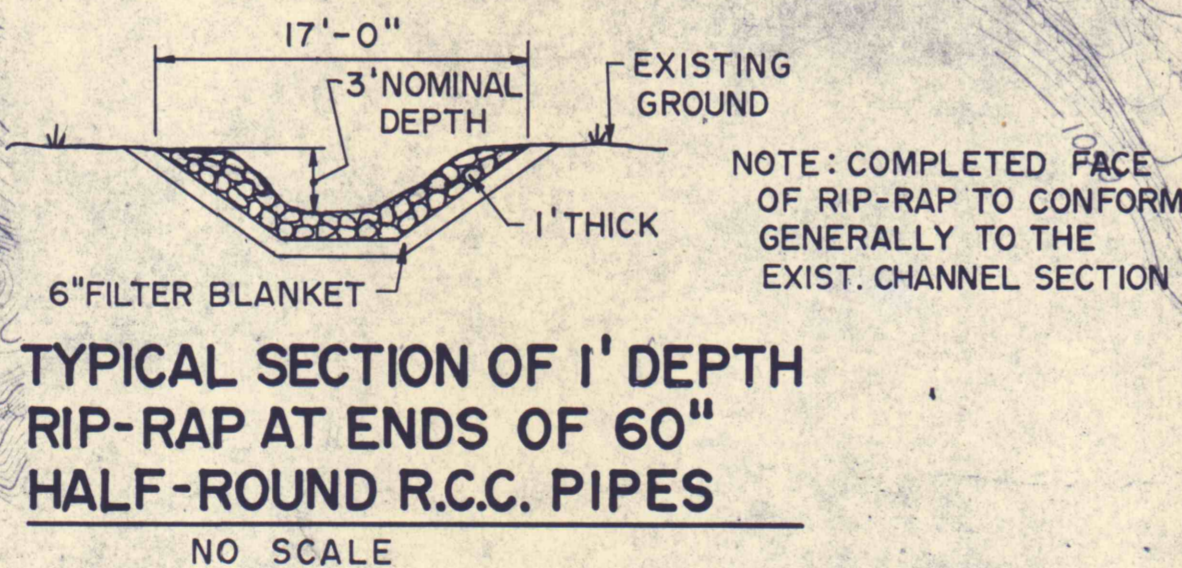
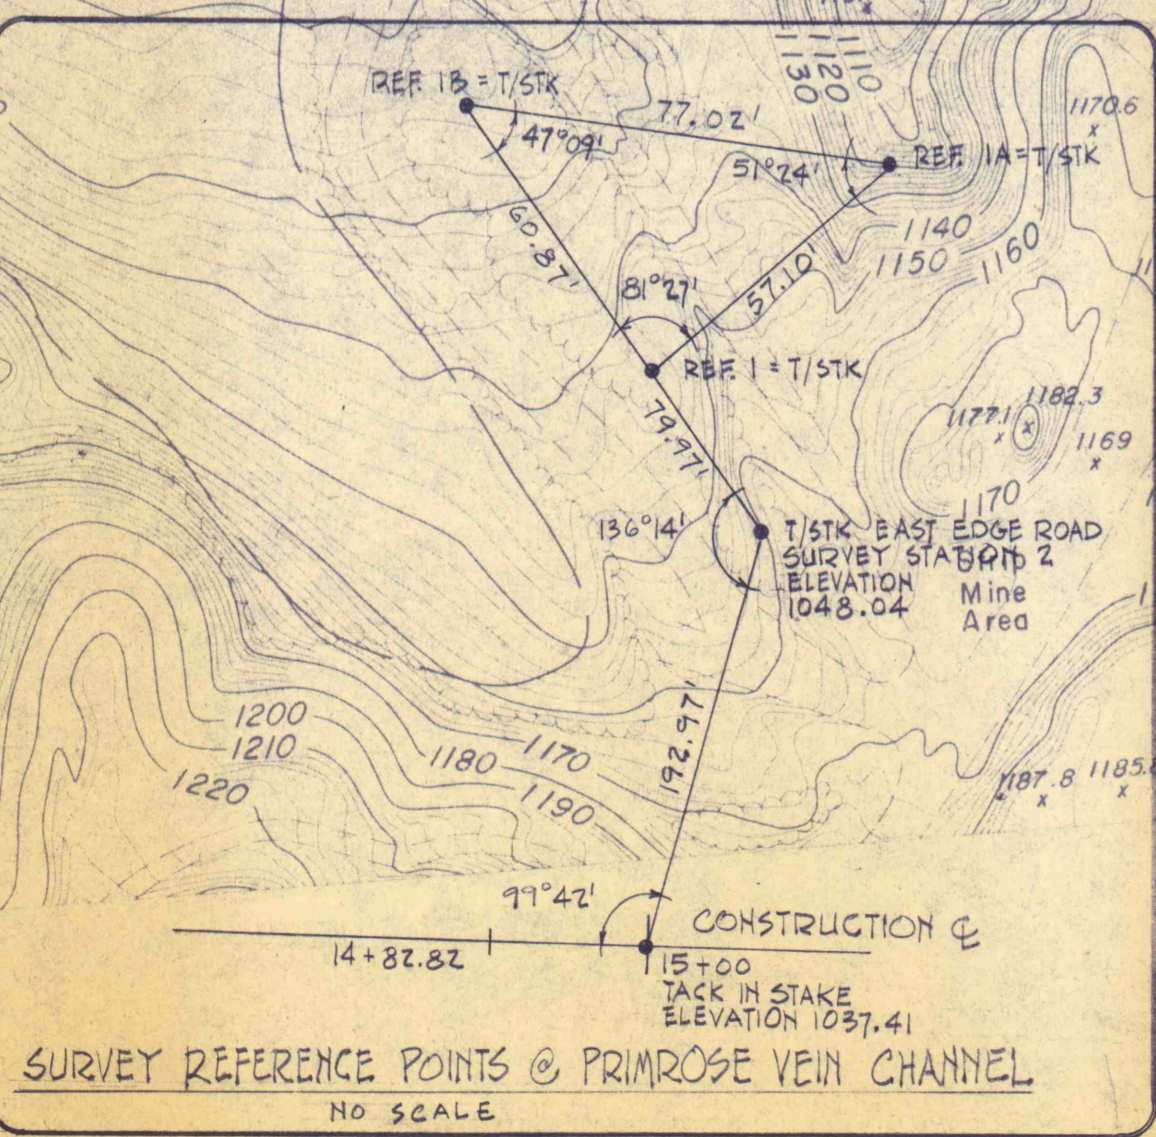
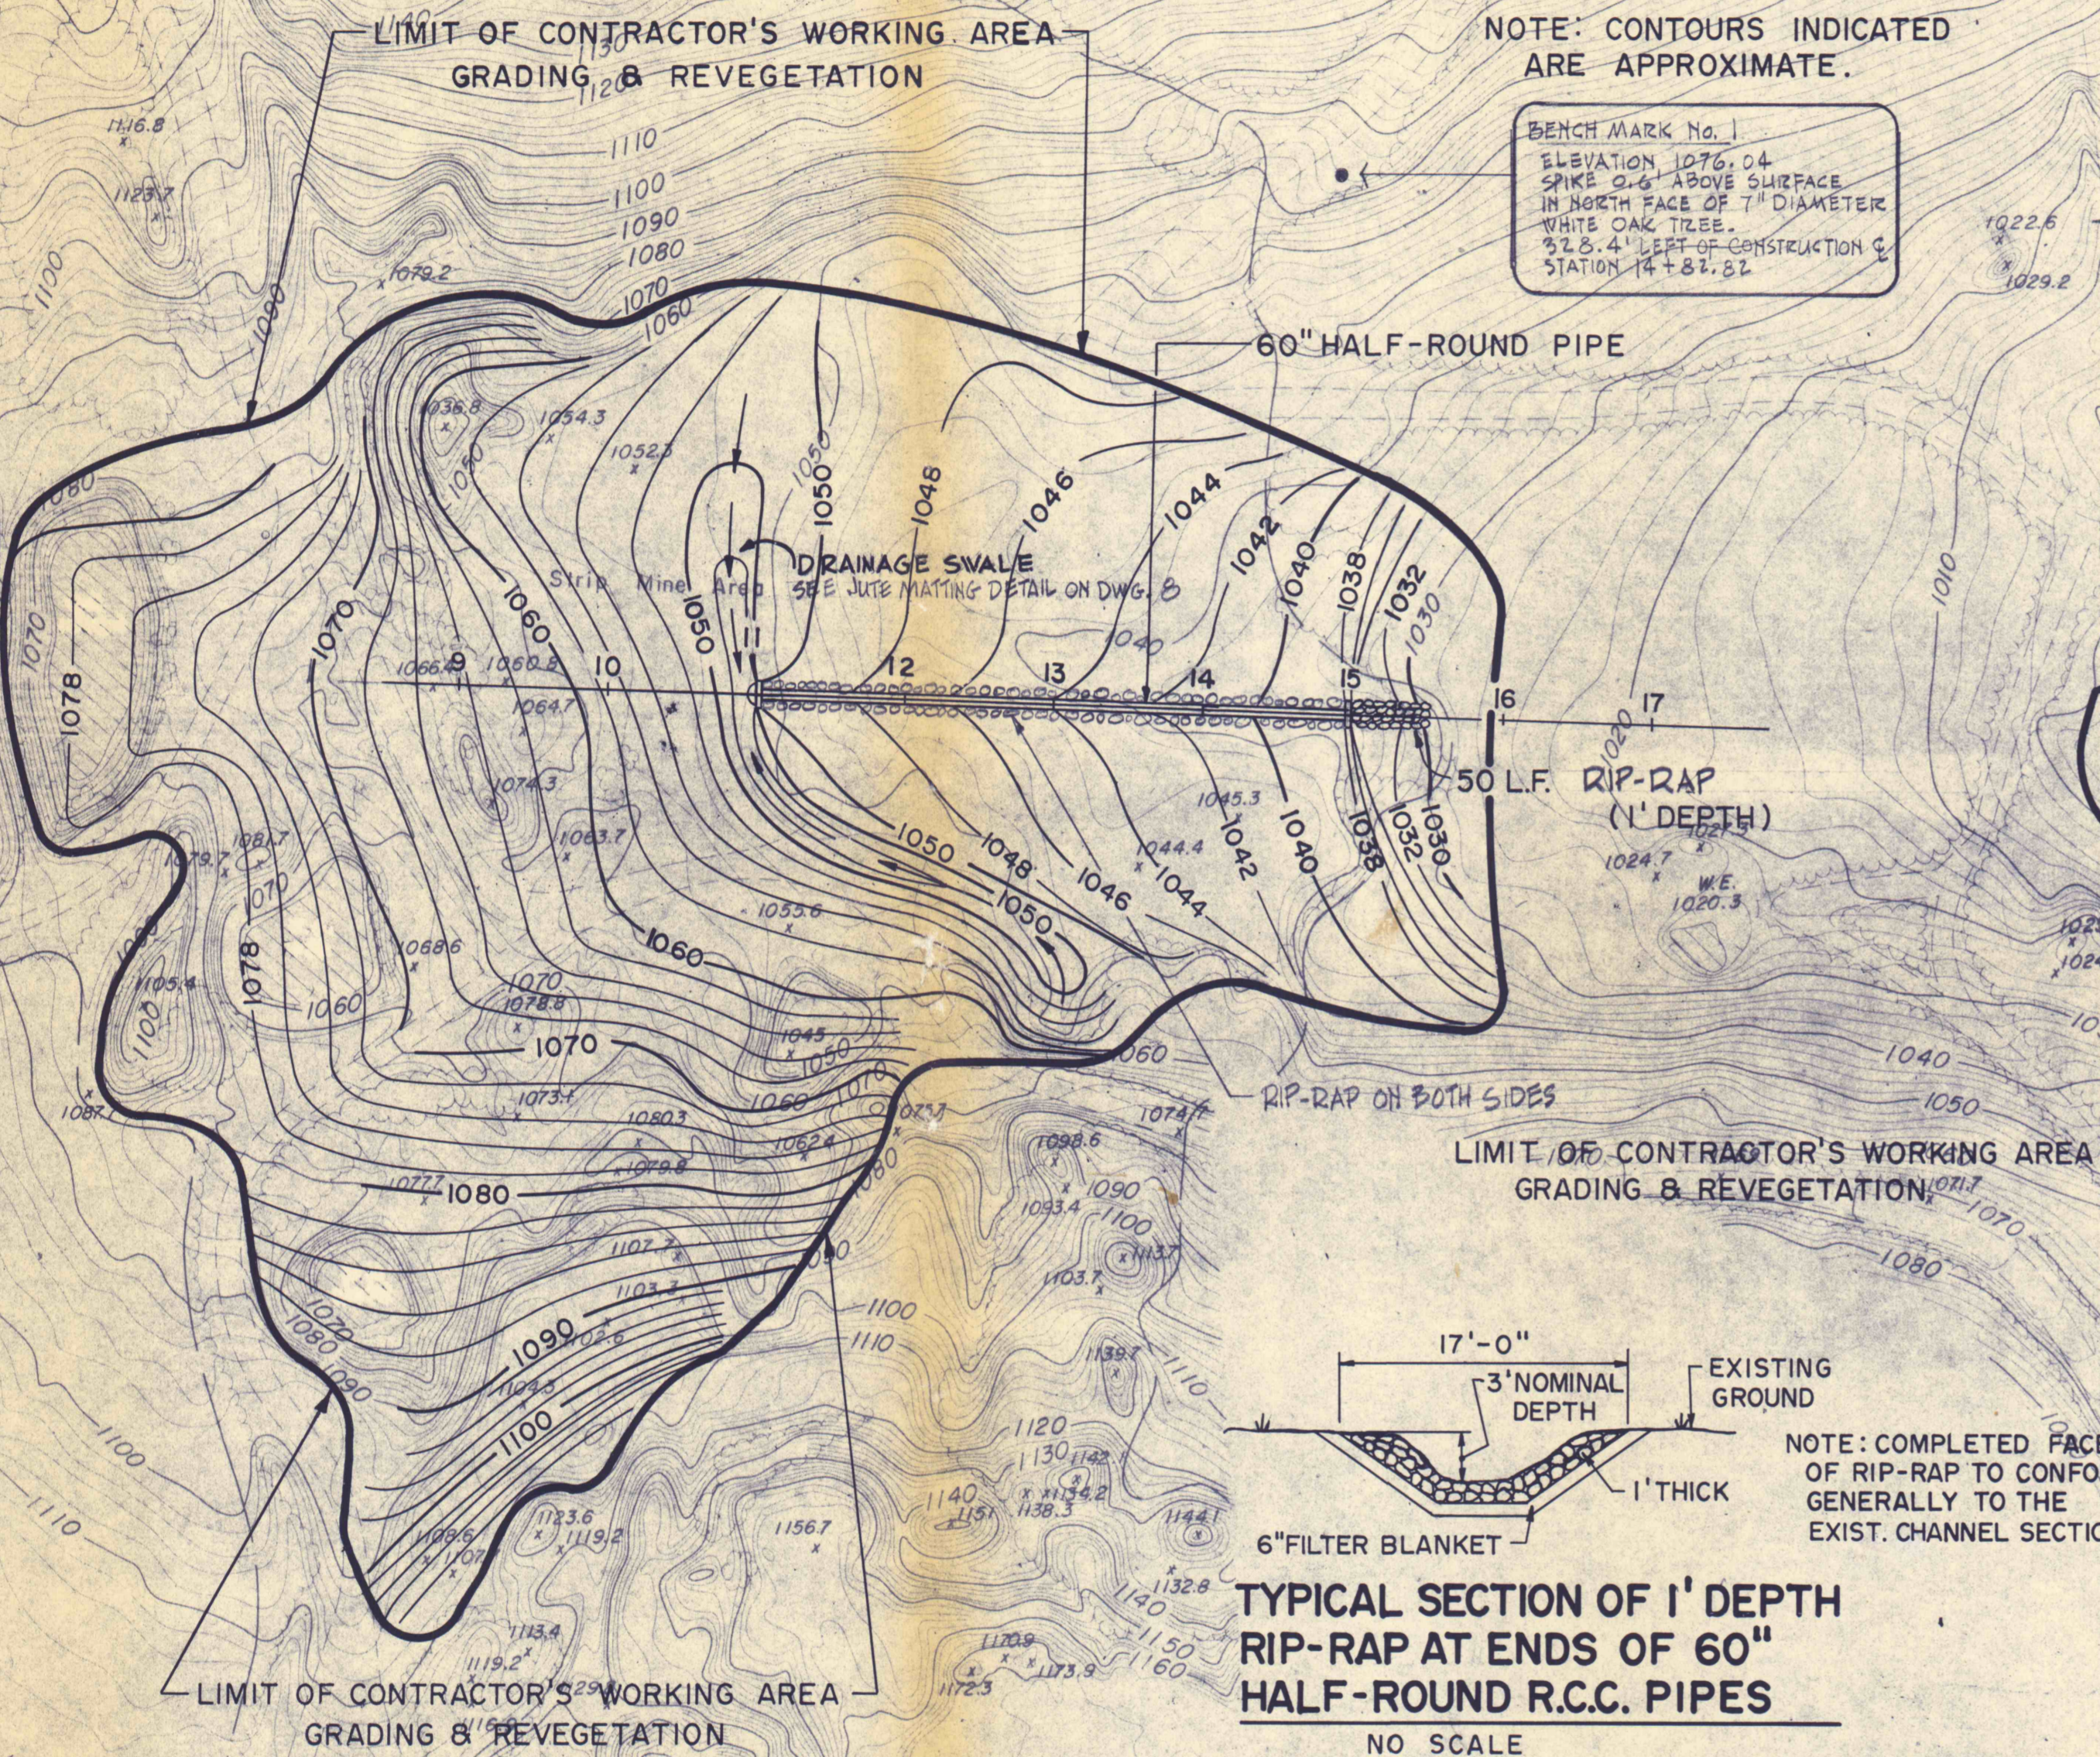
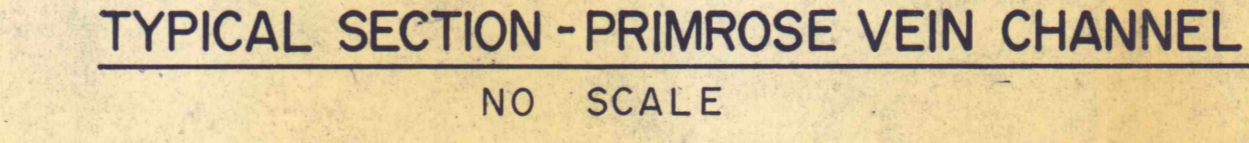



**(A) PRIMROSE VEIN CHANNEL**  
SCALE: 1" = 100'

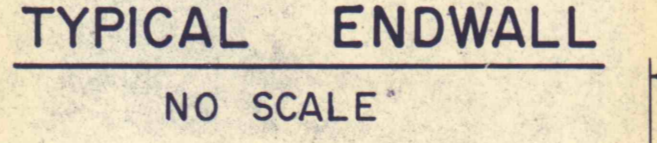


**(B) PROVING PIT**  
SCALE: 1" = 100'

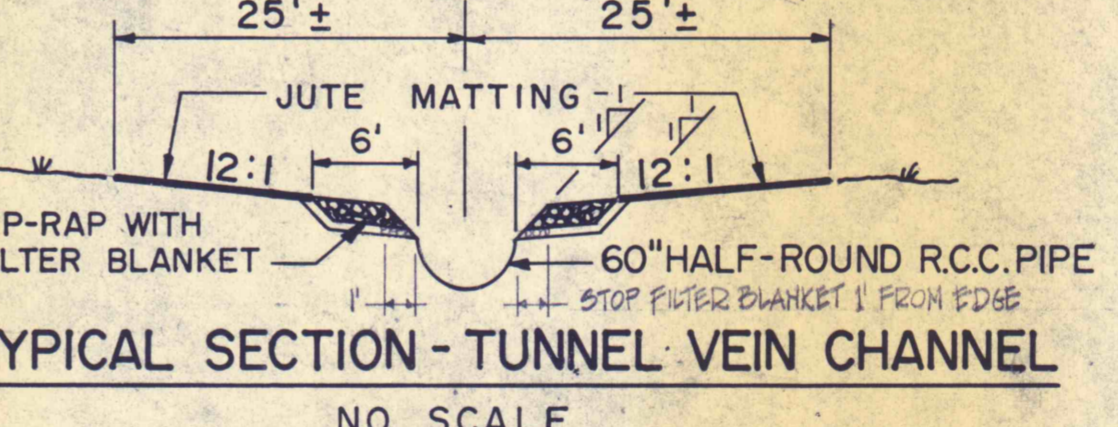


**PROFILE - TUNNEL VEIN CHANNEL**  
SCALE: VERT. 1" = 20'  
HORIZ. 1" = 100'

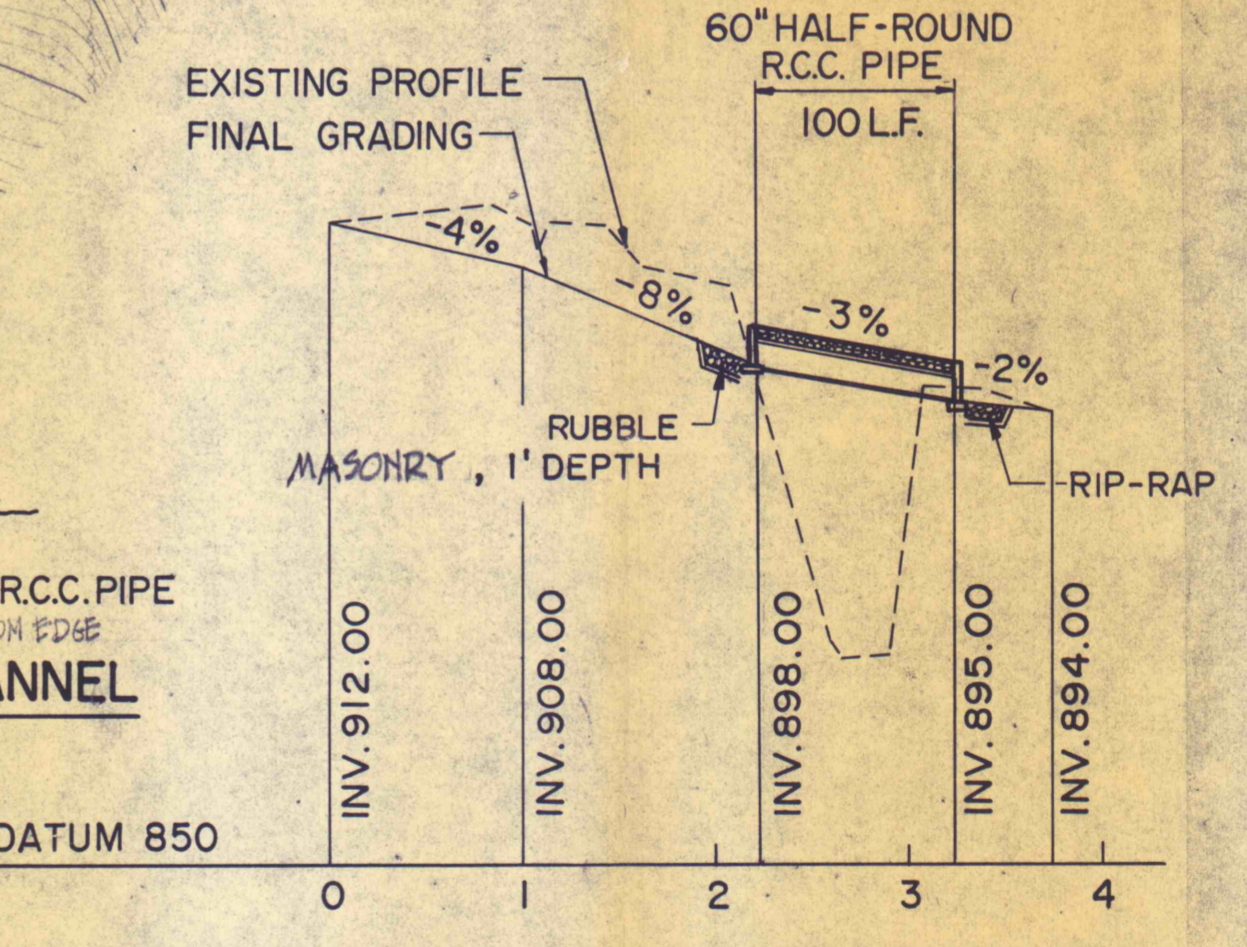


**TYPICAL SECTION EARTH BARRICADE**  
NO SCALE

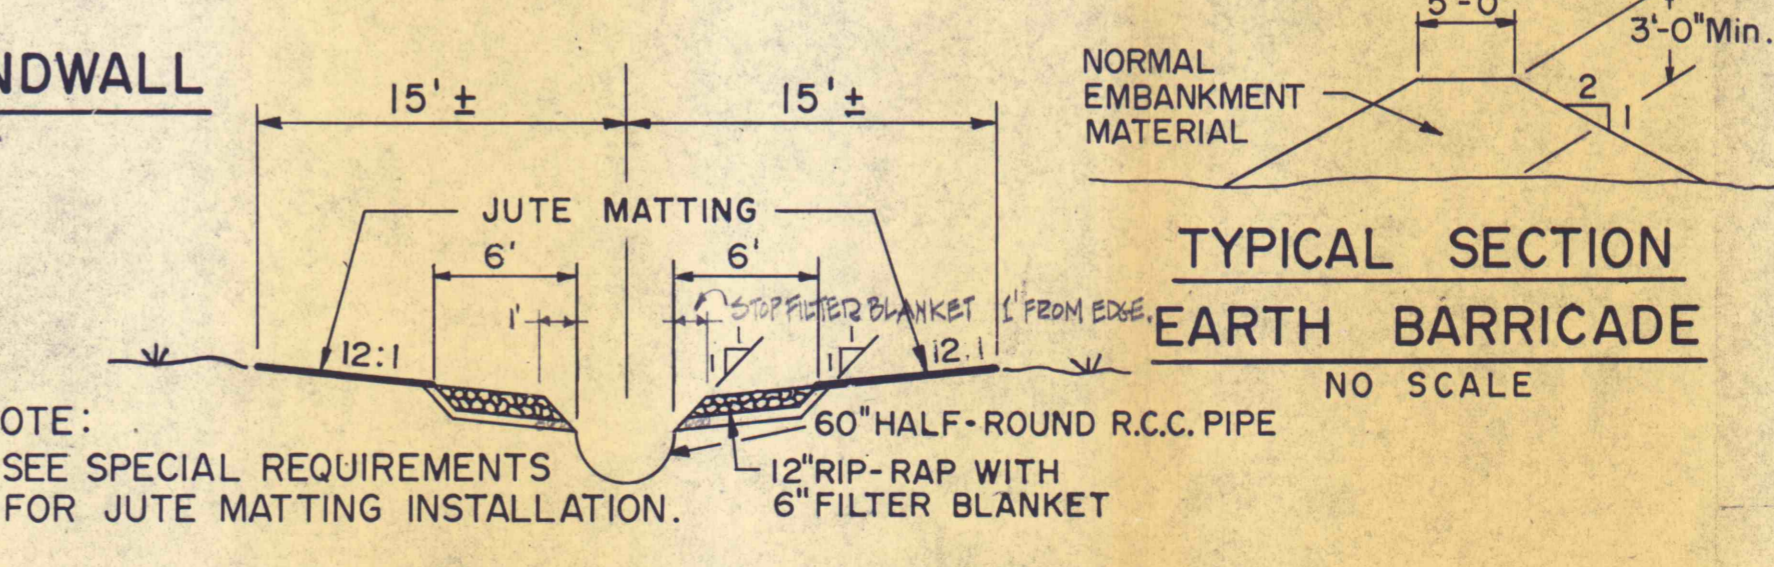

**(C) TUNNEL VEIN CHANNEL**  
SCALE: 1" = 100'

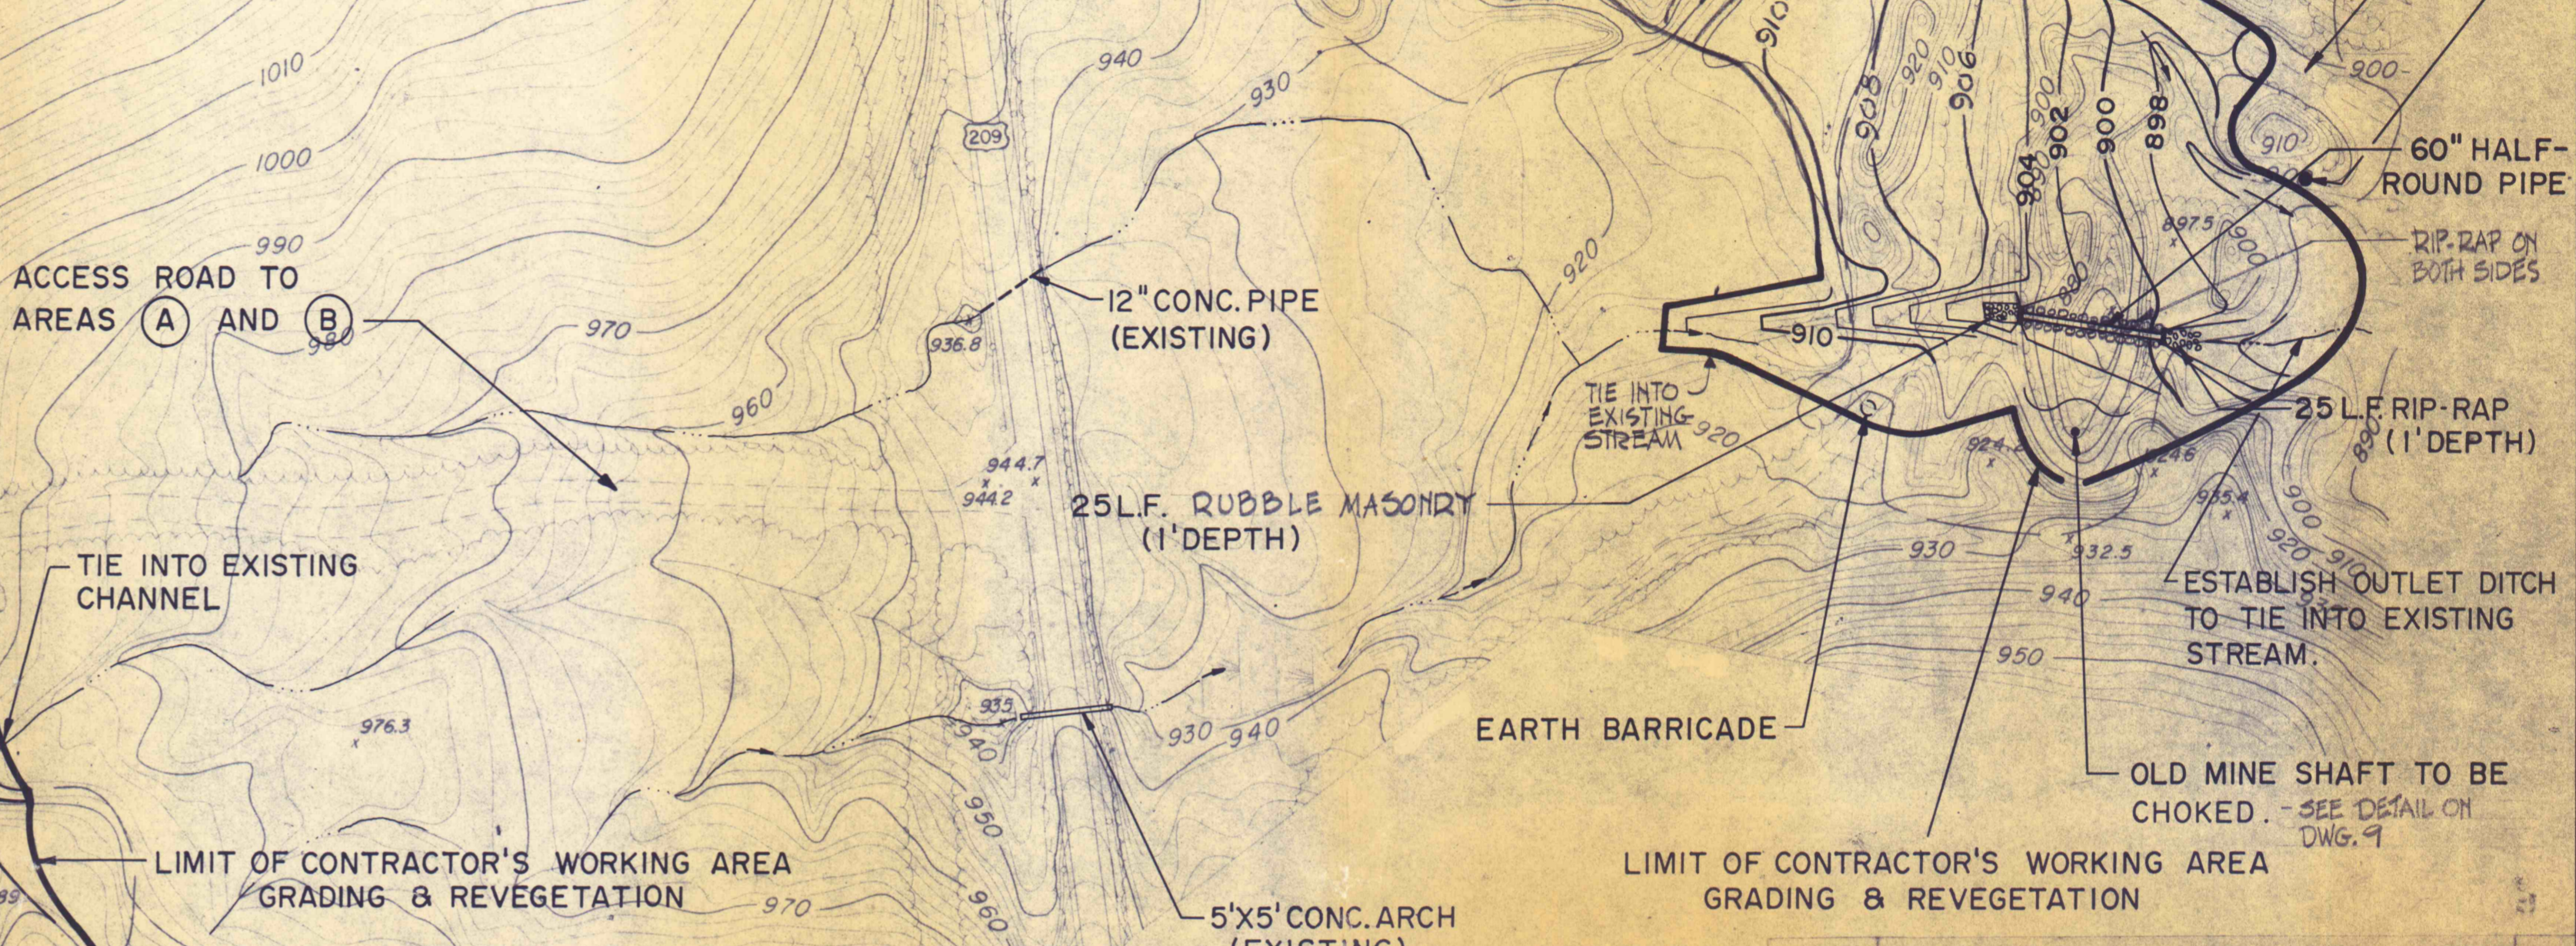

NO.	DATE	REVISION	APPR.
SUBMITTED	<i>Harvey P. Cowley</i>		PROFESSIONAL
APPROVED	<i>Robert A. Ramer</i>		CHIEF - DIVISION OF MINE RECLAMATION
APPROVED	<i>Andrew</i>		DIRECTOR - BUREAU OF DESIGN

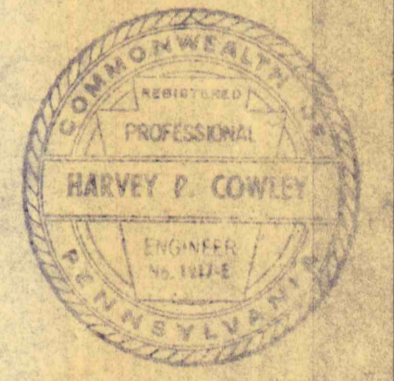

COMMONWEALTH OF PENNSYLVANIA  
DEPARTMENT OF ENVIRONMENTAL RESOURCES  
OFFICE OF RESOURCES MANAGEMENT

PROJECT NO. SL 126-1-5  
MINE DRAINAGE POLLUTION ABATEMENT  
SWATARA CREEK WATERSHED  
UPPER SWATARA CREEK & POLLY'S RUN  
REILLY TWP. SCHUYLKILL CO., PA.

NICHOLAS-COWLEY-BROSCH ASSOC., INC.  
Consulting Engineers  
3300 North Third St. Harrisburg, Pa.

**POLLY'S RUN  
PLAN & PROFILE**

DRAWN BY BEN	DATE Jan. 11, 1974	DRAWING NO. 3 of 9
CHECKED BY HPC	SCALE As Shown	

NOTE: TOPOGRAPHIC DATA OBTAINED FEBRUARY, 1973.