



DITCH "B"

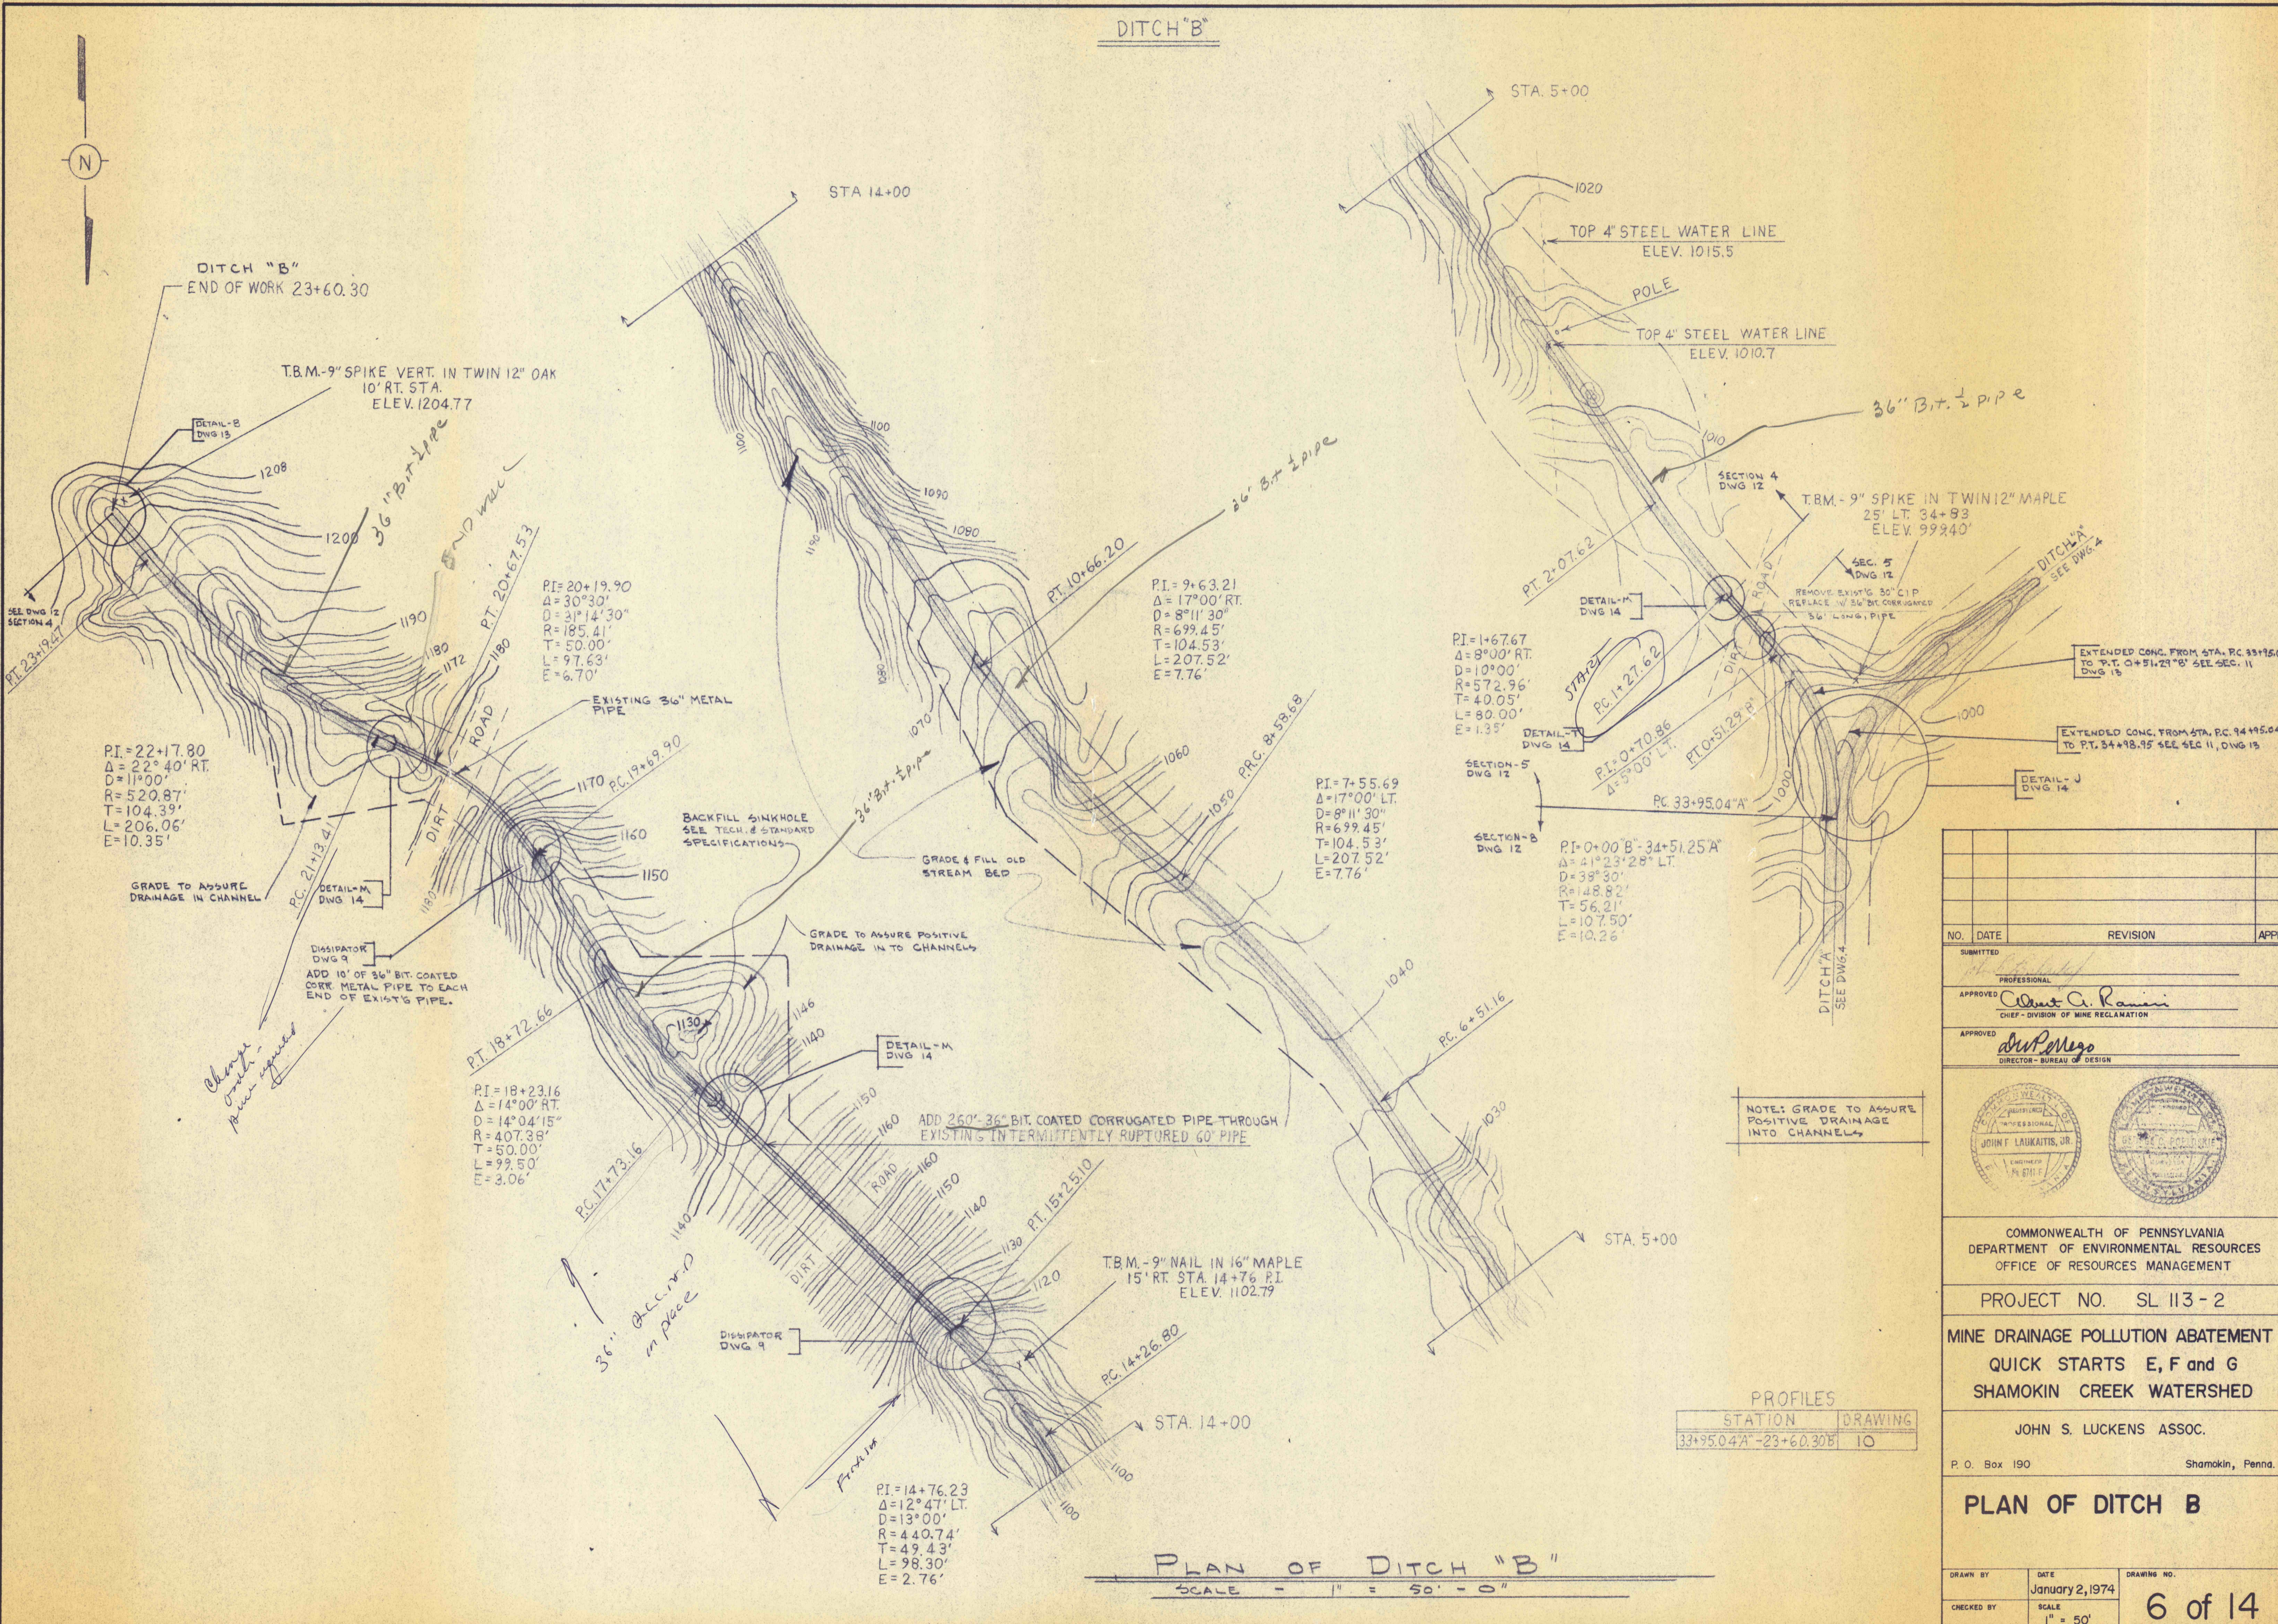

NO.	DATE	REVISION	APPR.

SUBMITTED: *[Signature]*
 PROFESSIONAL
 APPROVED: *Robert A. Rainier*
 CHIEF - DIVISION OF MINE RECLAMATION
 APPROVED: *[Signature]*
 DIRECTOR - BUREAU OF DESIGN

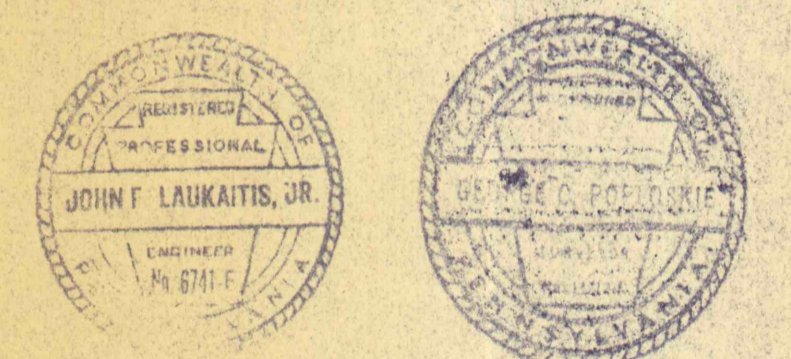

COMMONWEALTH OF PENNSYLVANIA
 DEPARTMENT OF ENVIRONMENTAL RESOURCES
 OFFICE OF RESOURCES MANAGEMENT

PROJECT NO. SL 113-2
 MINE DRAINAGE POLLUTION ABATEMENT
 QUICK STARTS E, F and G
 SHAMOKIN CREEK WATERSHED

JOHN S. LUCKENS ASSOC.
 P. O. Box 190 Shamokin, Penna.

PLAN OF DITCH B

DRAWN BY	DATE	DRAWING NO.
CHECKED BY	SCALE	6 of 14

PROFILES

STATION	DRAWING
33+95.04" - 23+60.30"	10

PLAN OF DITCH "B"
 SCALE - 1" = 50' - 0"