


4-11-81  
SUSSEX INDUSTRIES, SEWING CO  
OPEN PIT - SHAFT HILL

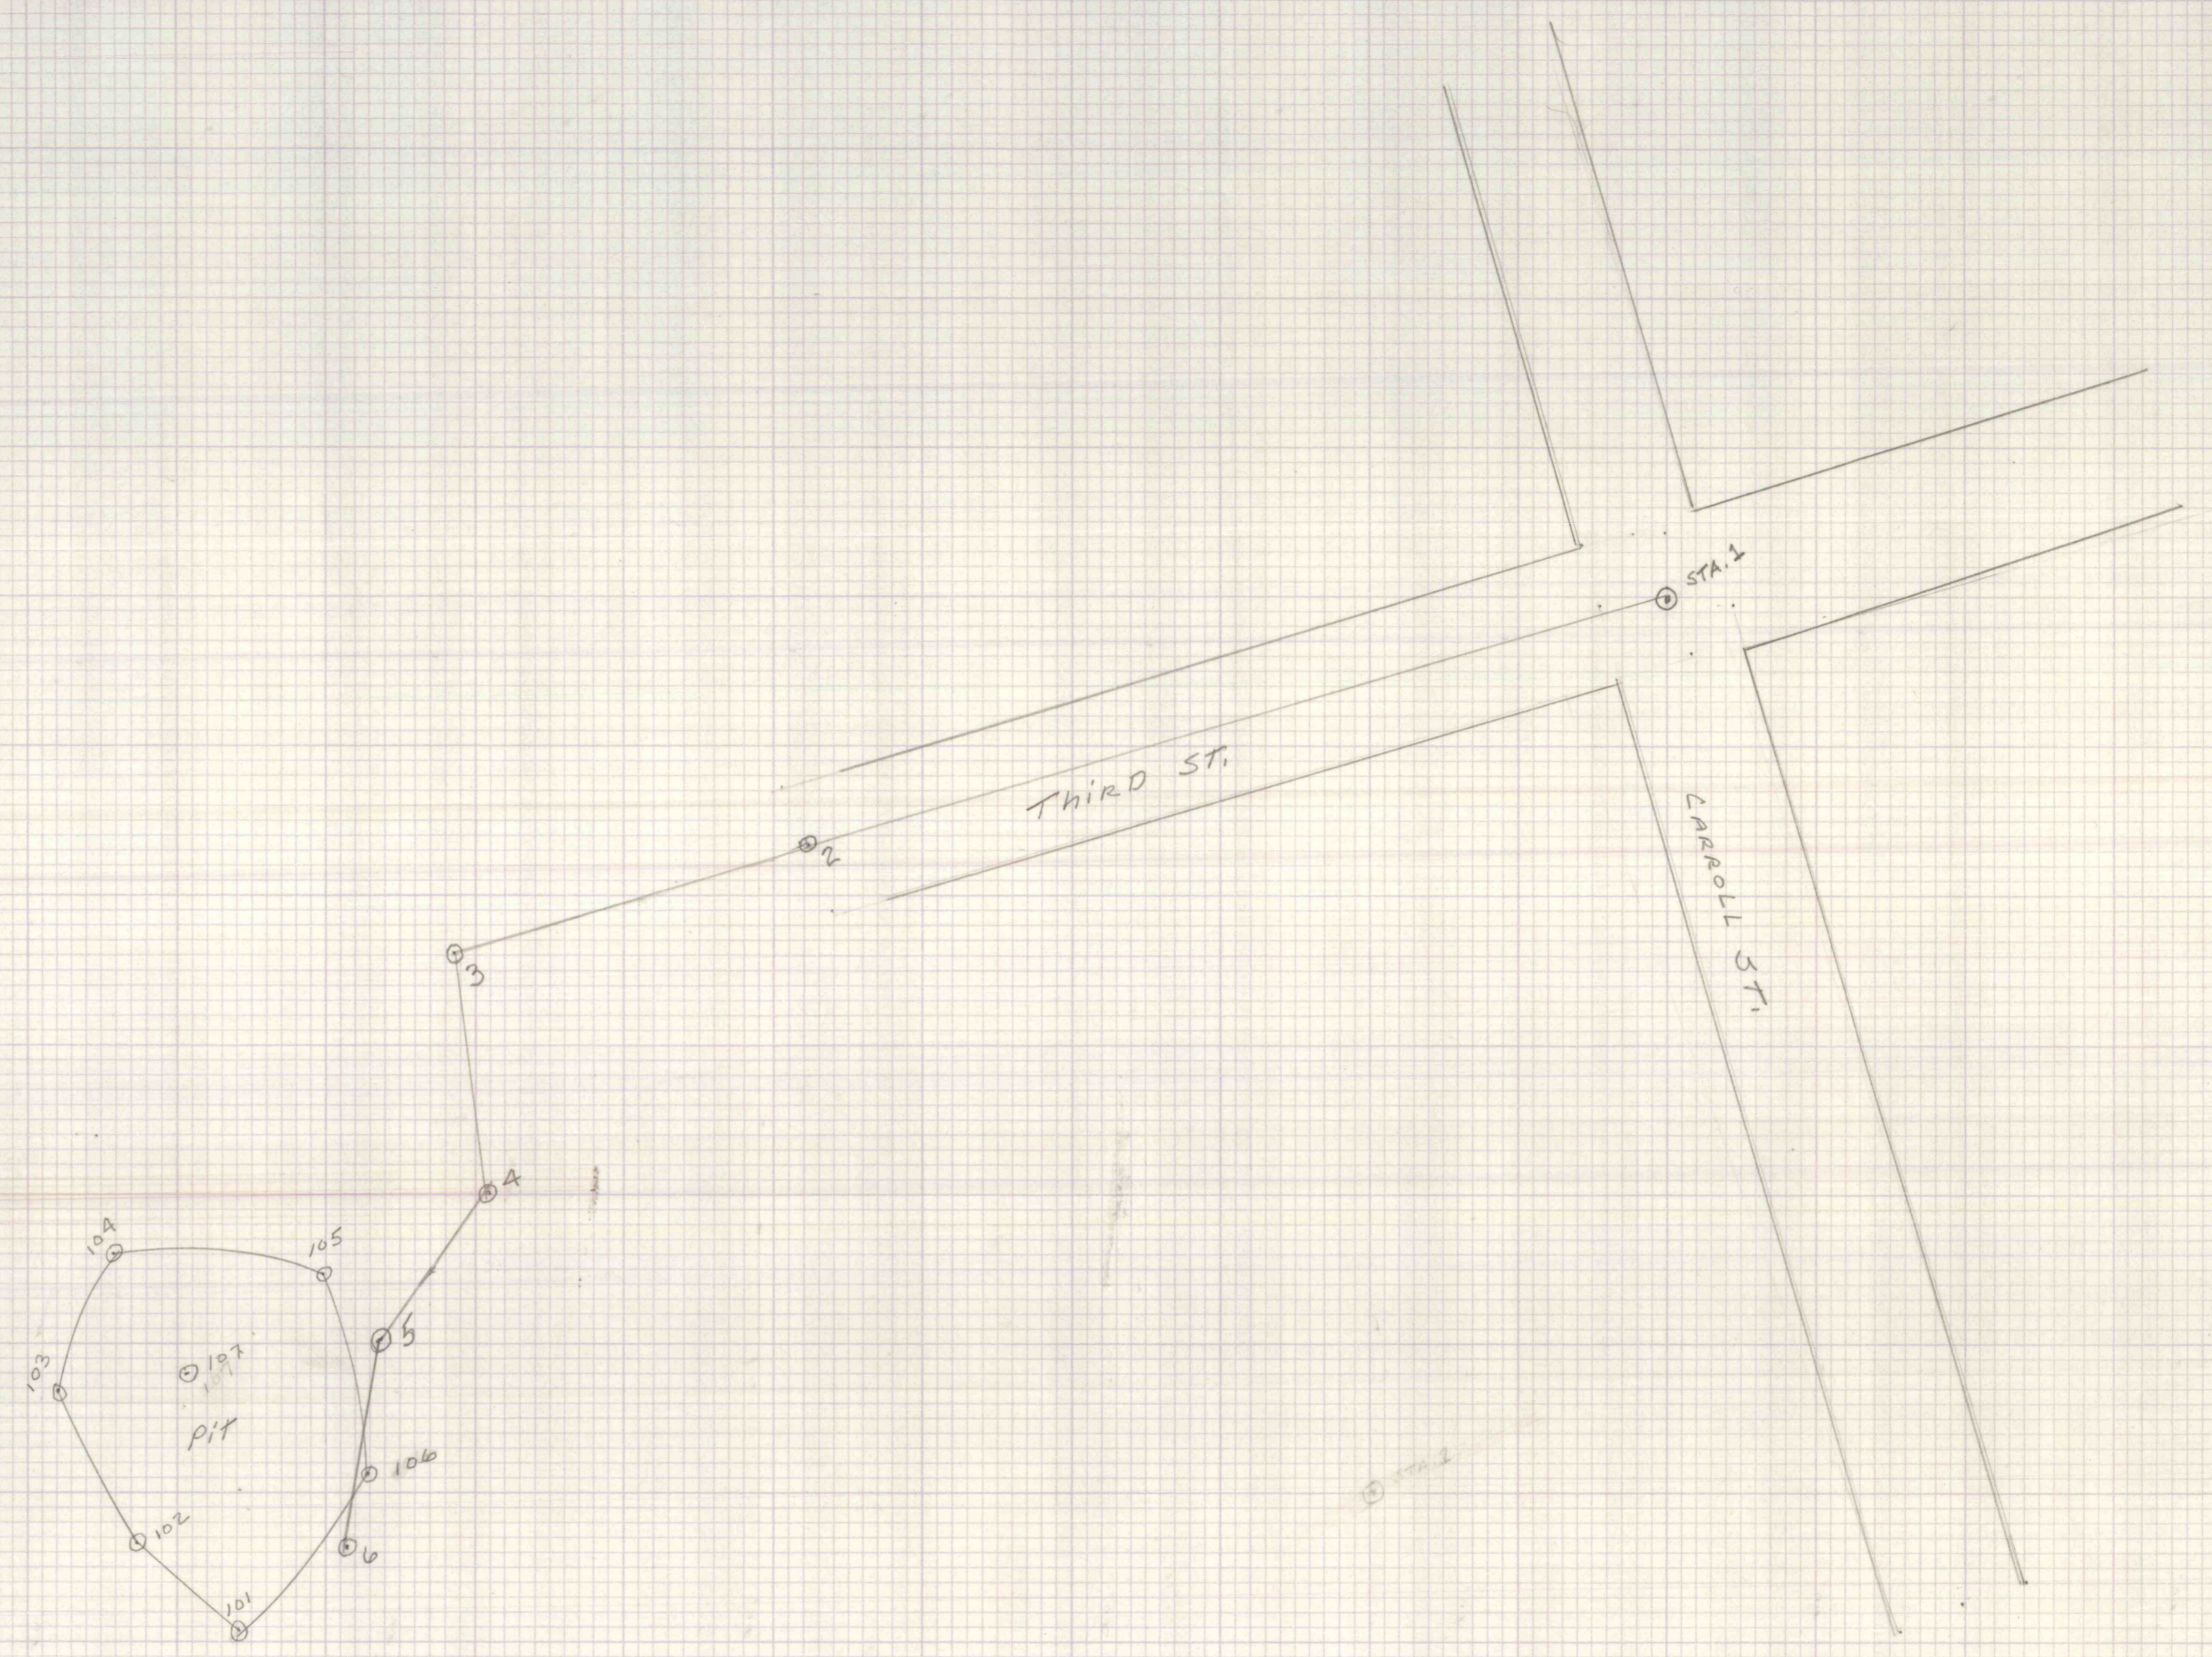

SHAFT HILL - OPEN PIT - WADESVILLE  
ST. CLAIR, PA AUG. '78  
SCALE 1" = 40'  
SCHUYLKILL COUNTY  
SOUTHERN FIELD  
SURFACE