


ST. CLAIR TRACT

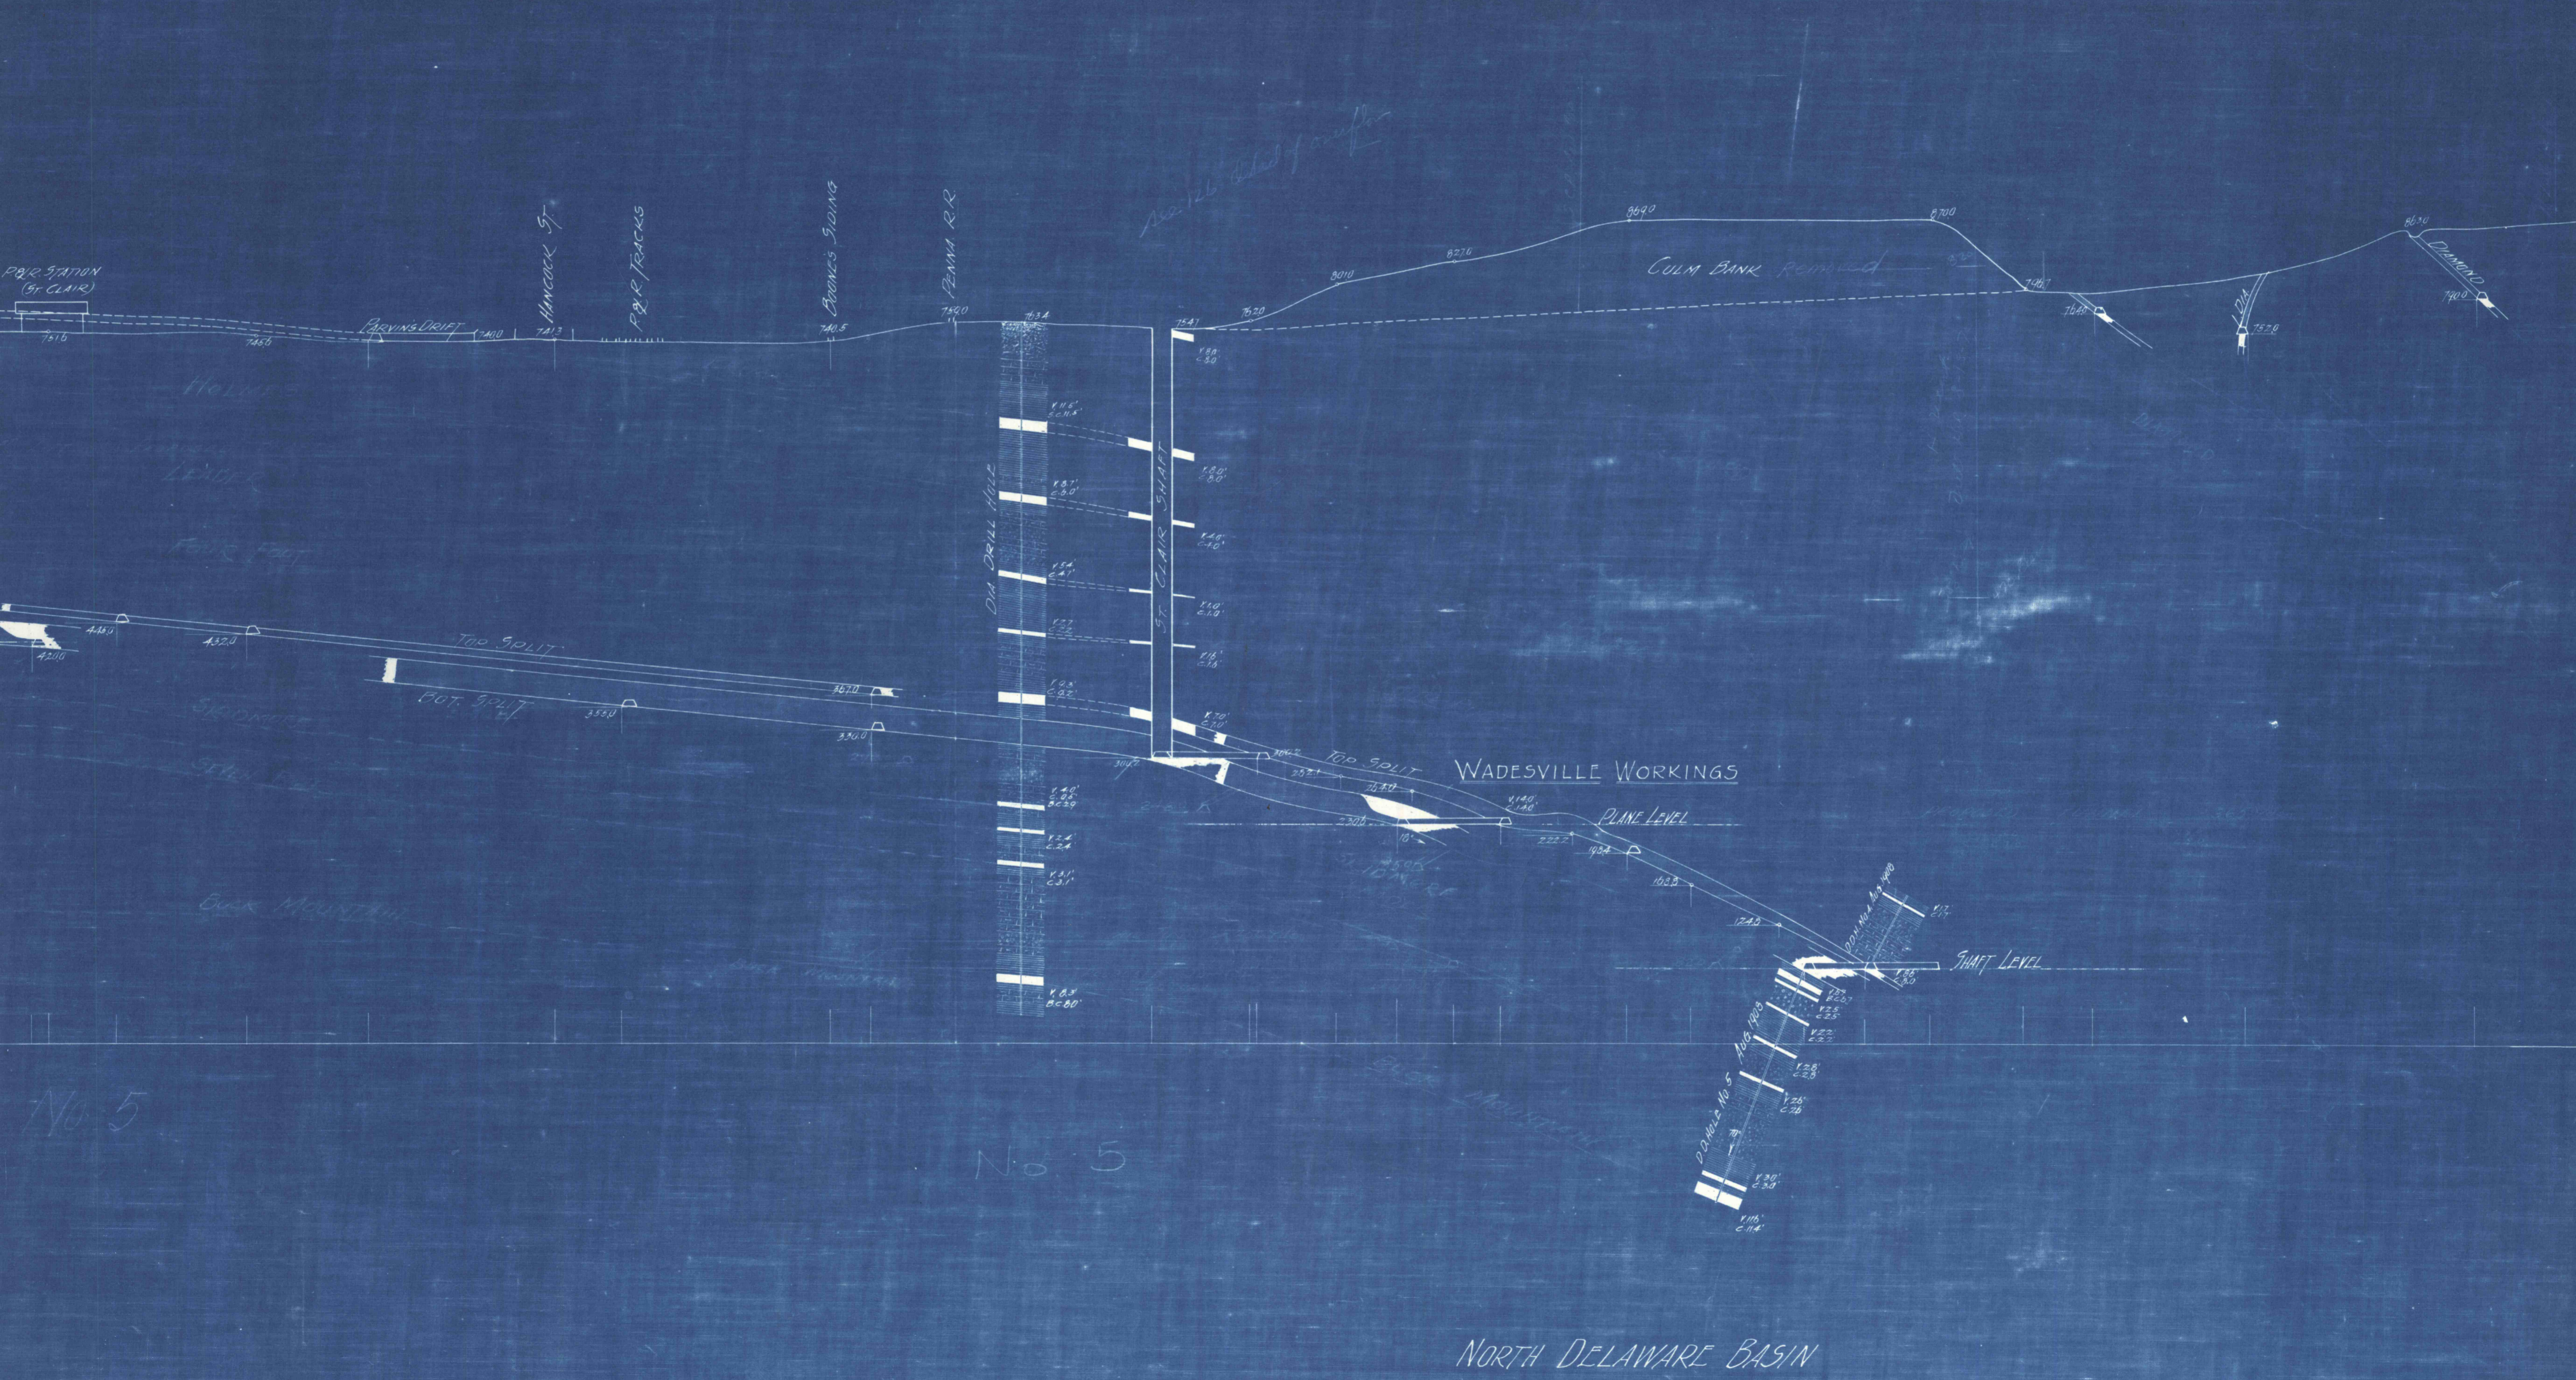

NORTH DELAWARE BASIN