
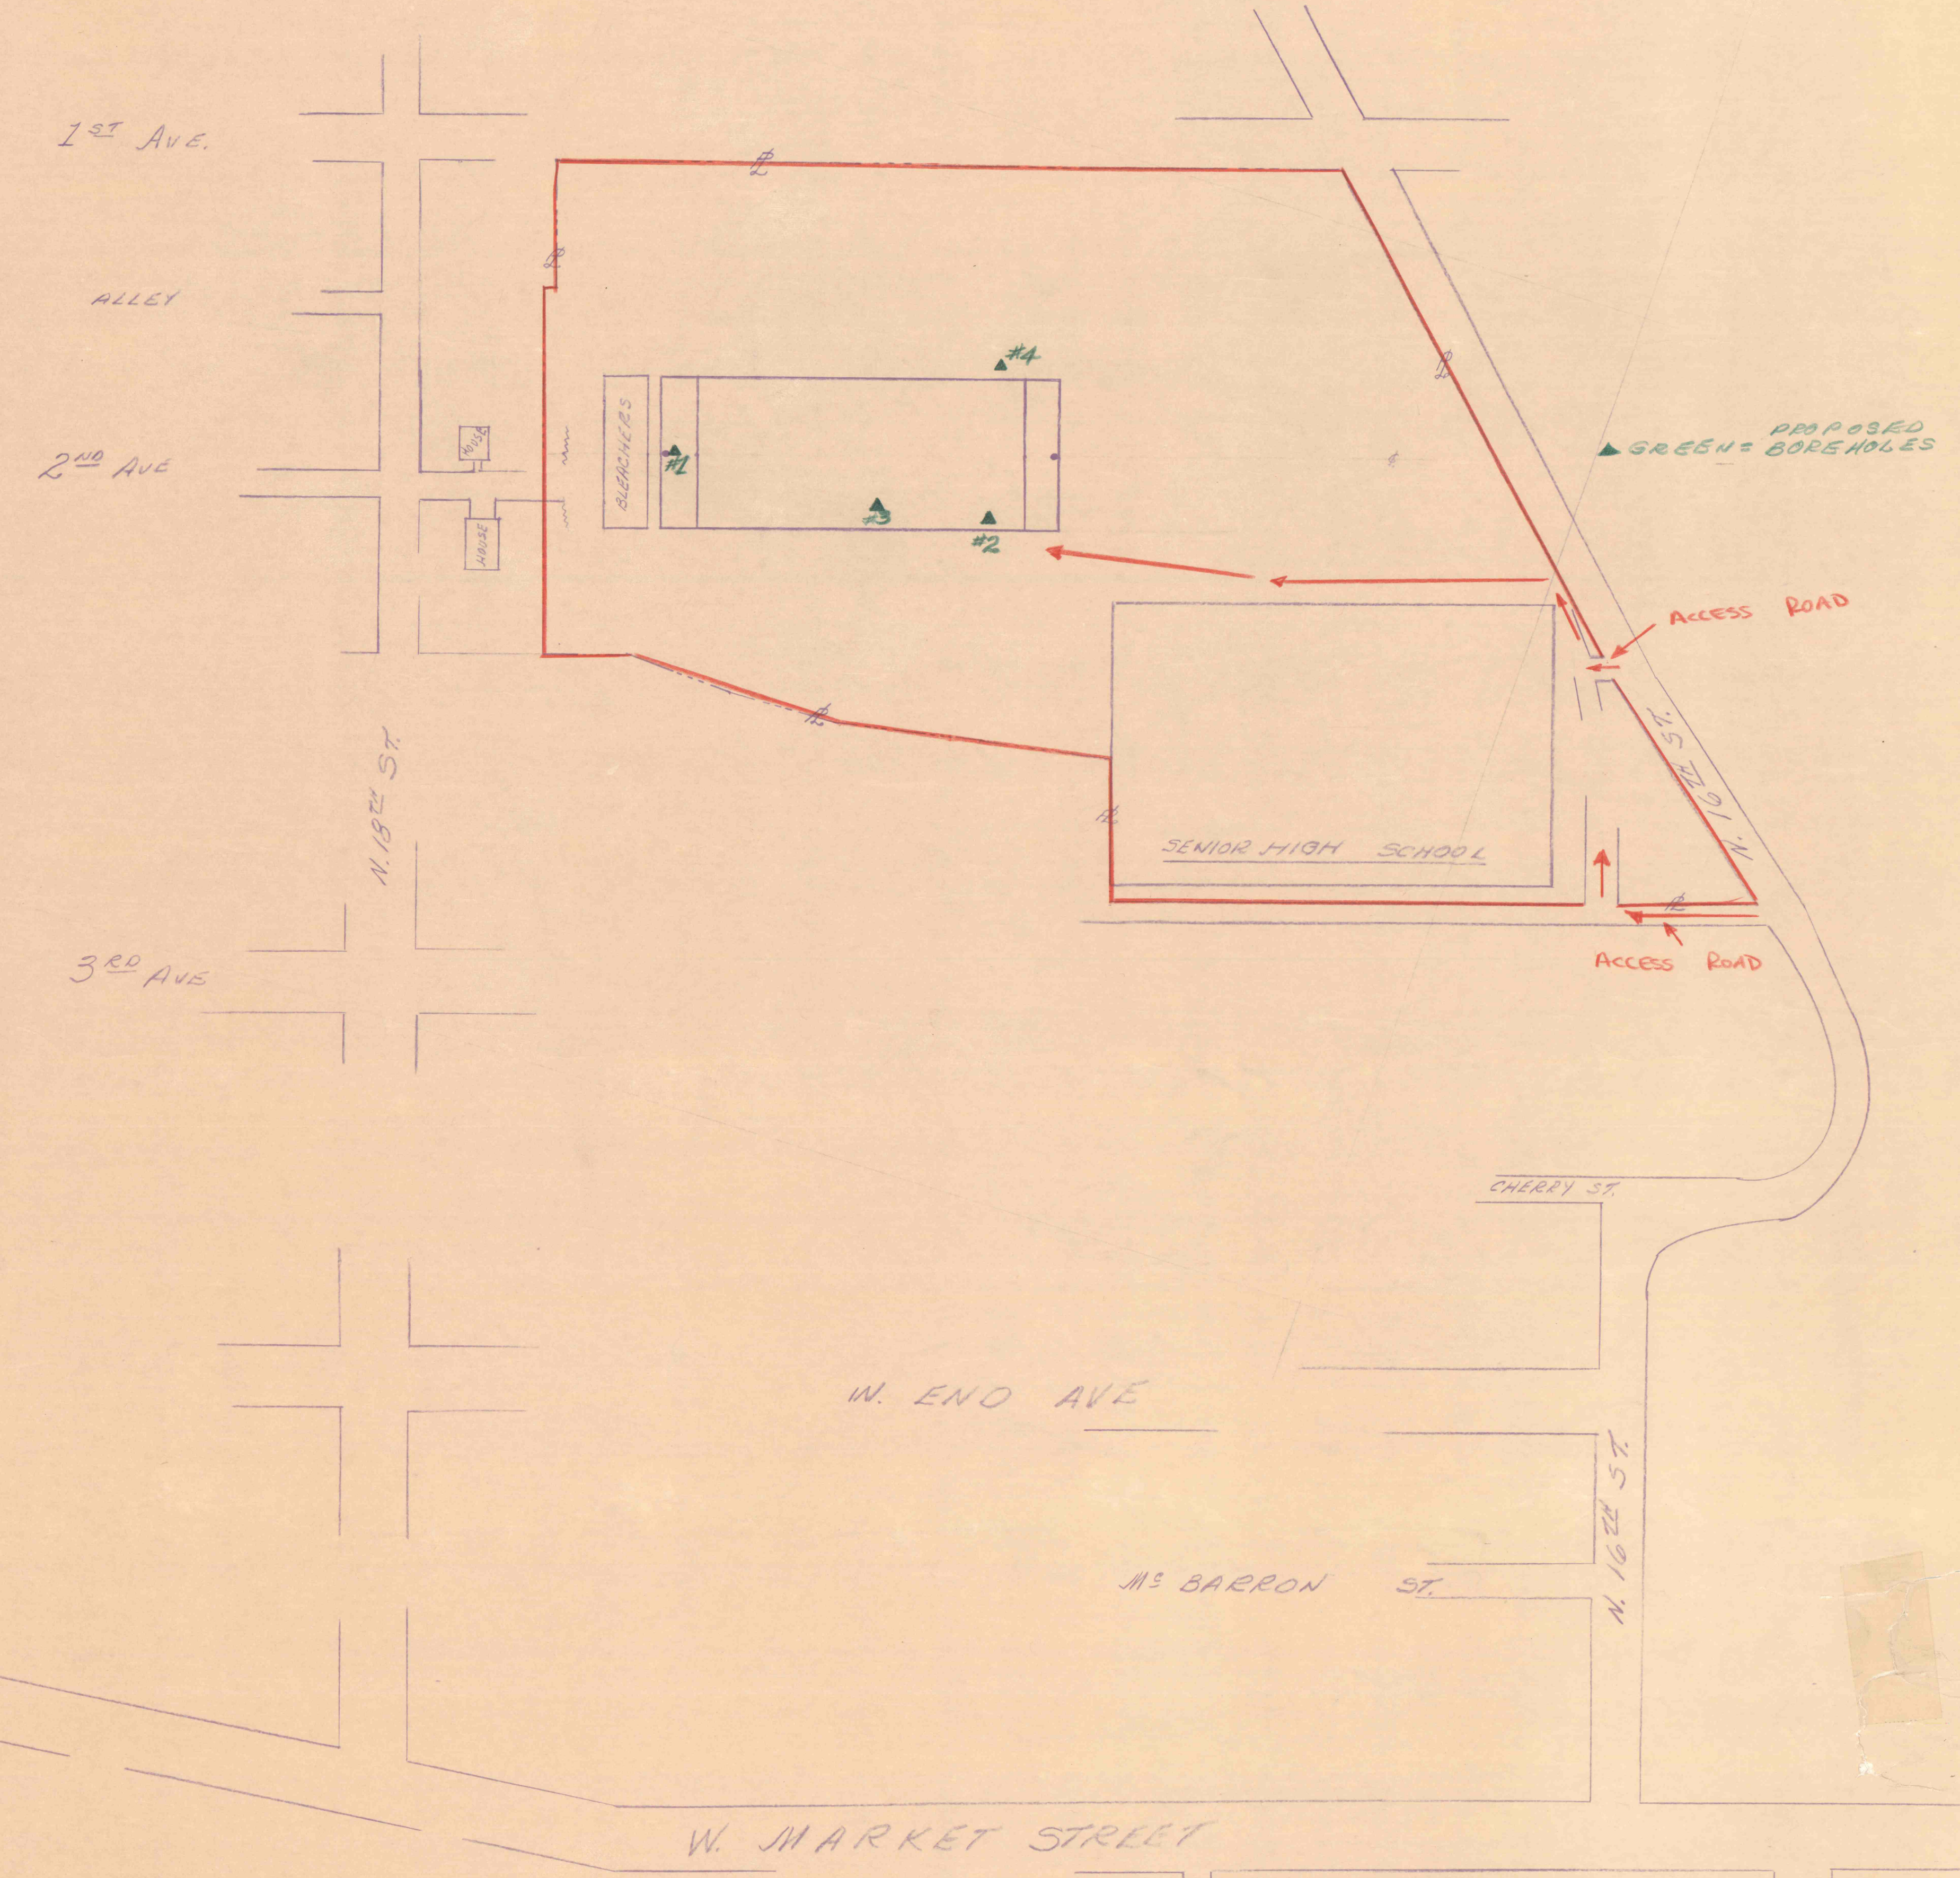


4000 No

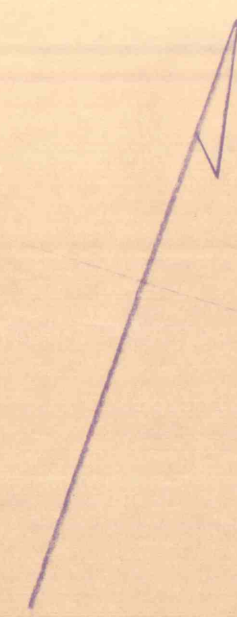

POTTSVILLE AND YORK FARM
SURFACE & MINE WORKINGS IN
VICINITY OF POTTSVILLE HI-SCHOOL
VETERANS MEMORIAL STADIUM
SCALE 1" = 100' 3-27-70
DEPT. OF ENVIR. RES.